PARENT PARCEL: 07-00-008-117-085

CHILD PARCEL: NEW SURVEY AND AC CORRECTION

STARTING POINT: C/L Center Ride RD and intersetion of C/L of Lear Nagel RD

24-05350-C

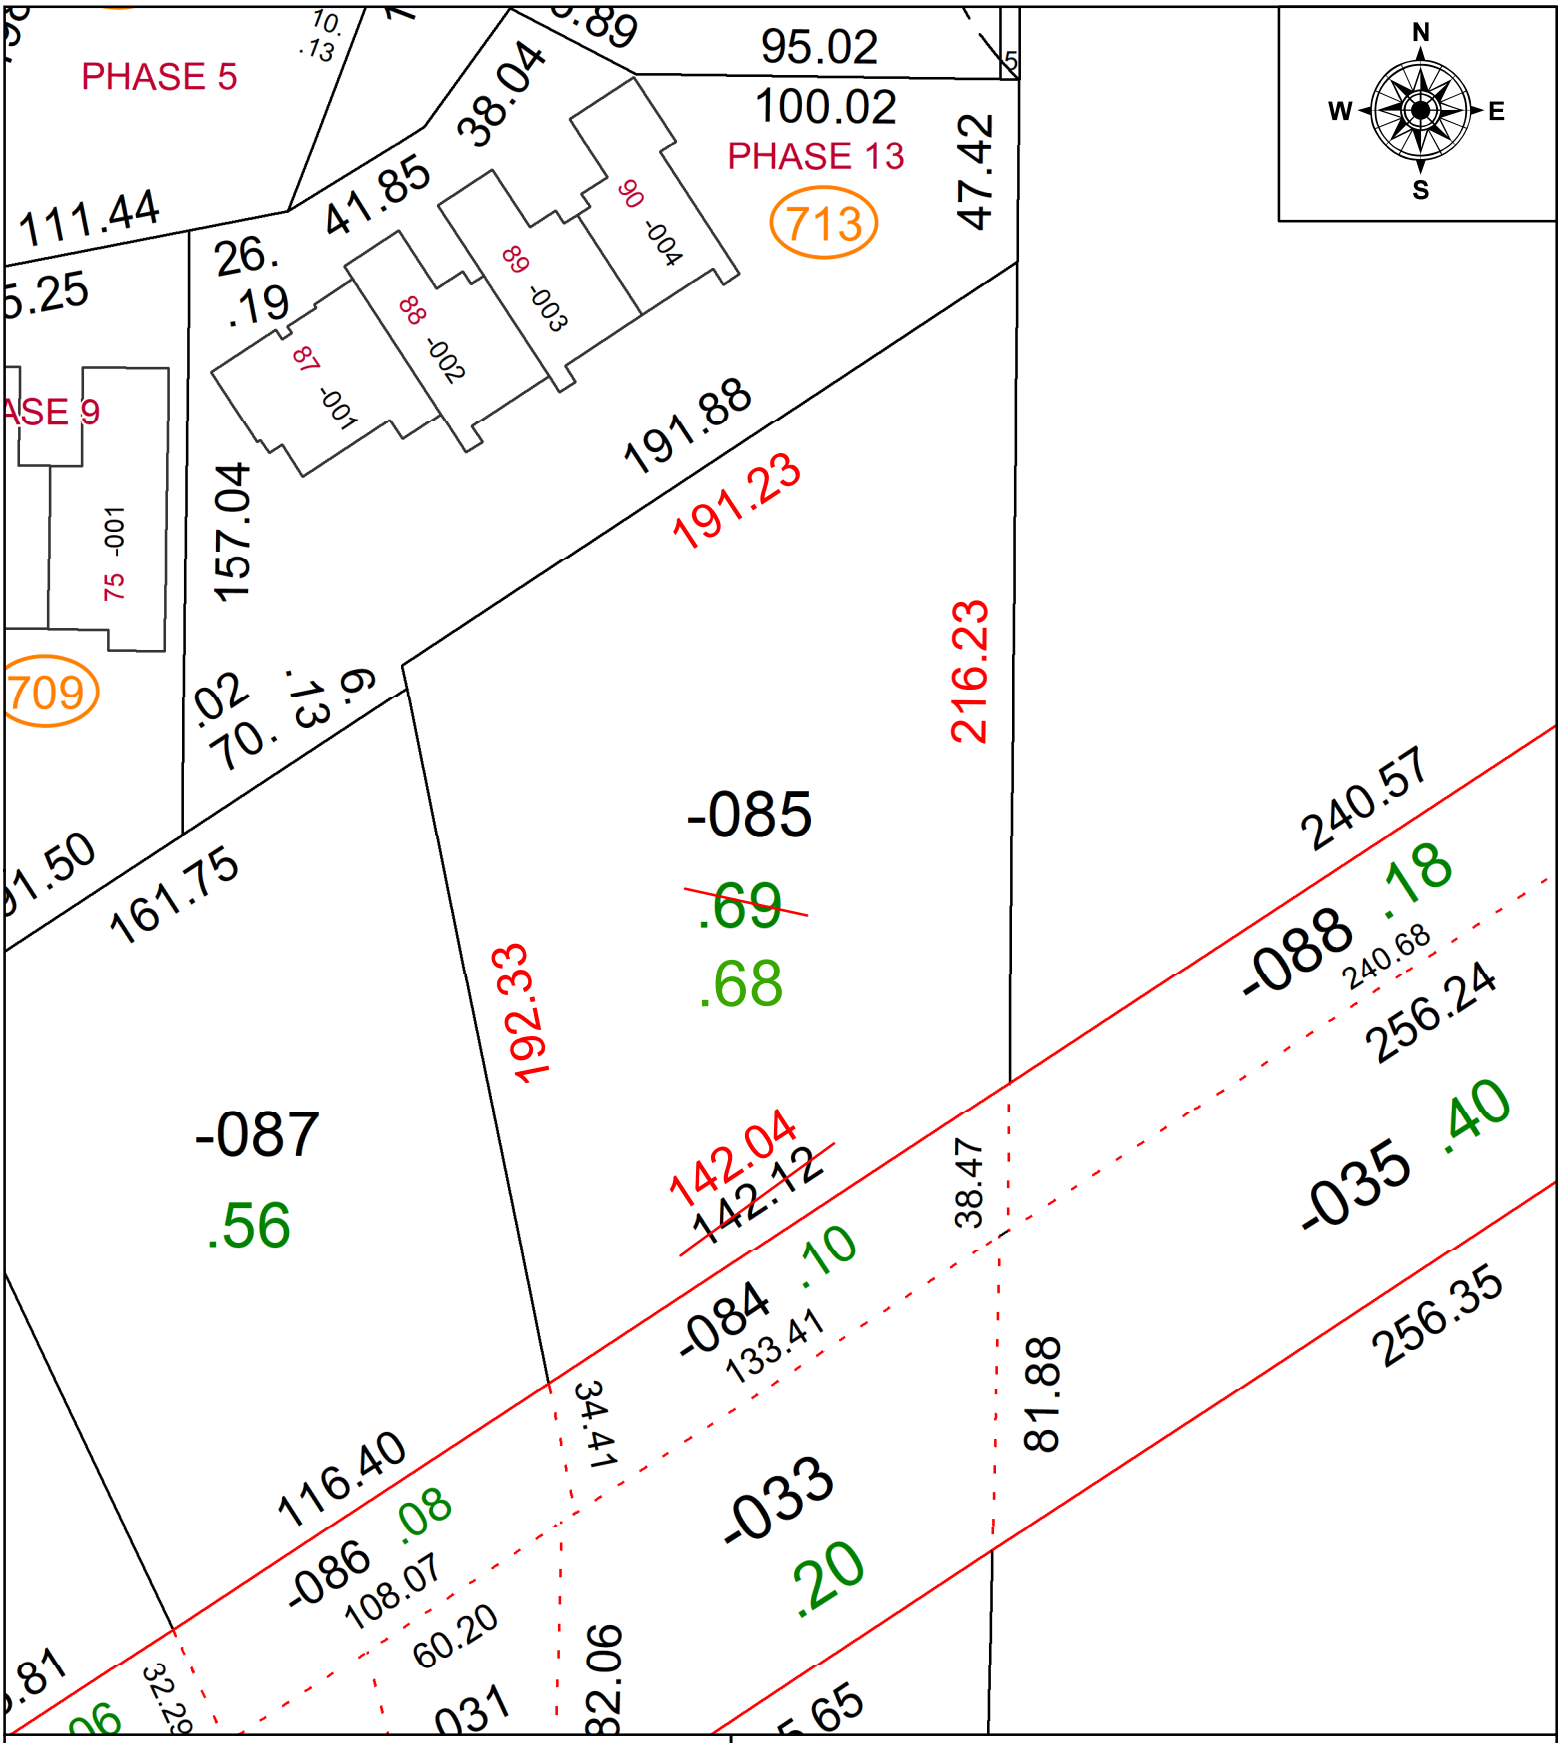

SPLITS/DEEDS PROCESSED

LORAIN COUNTY TAX MAP DEPARTMENT
226 MIDDLE AVE. ELYRIA, OH

SURVEYED BY: SEAN A. BOLAND **SURVEY #:** 51253

CLOSURE: 1;147762

MAP PAGE(S): 0700008

APPOVED BY: BB **DATE:** 8/19/2024

SCALE: 1" = 50' **PRIOR INSTRUMENT:** #20160612078