PARENT PARCEL: 18-00-029-000-060

CHILD PARCEL: AC CORR PER SURVEYOR THOMAS SIMON

STARTING POINT: INTERSECTION OF NORTHEASTERLY CORNER OF O.L. 29 & C/L OF PECK-WADSWORTH RD

24-05356-C

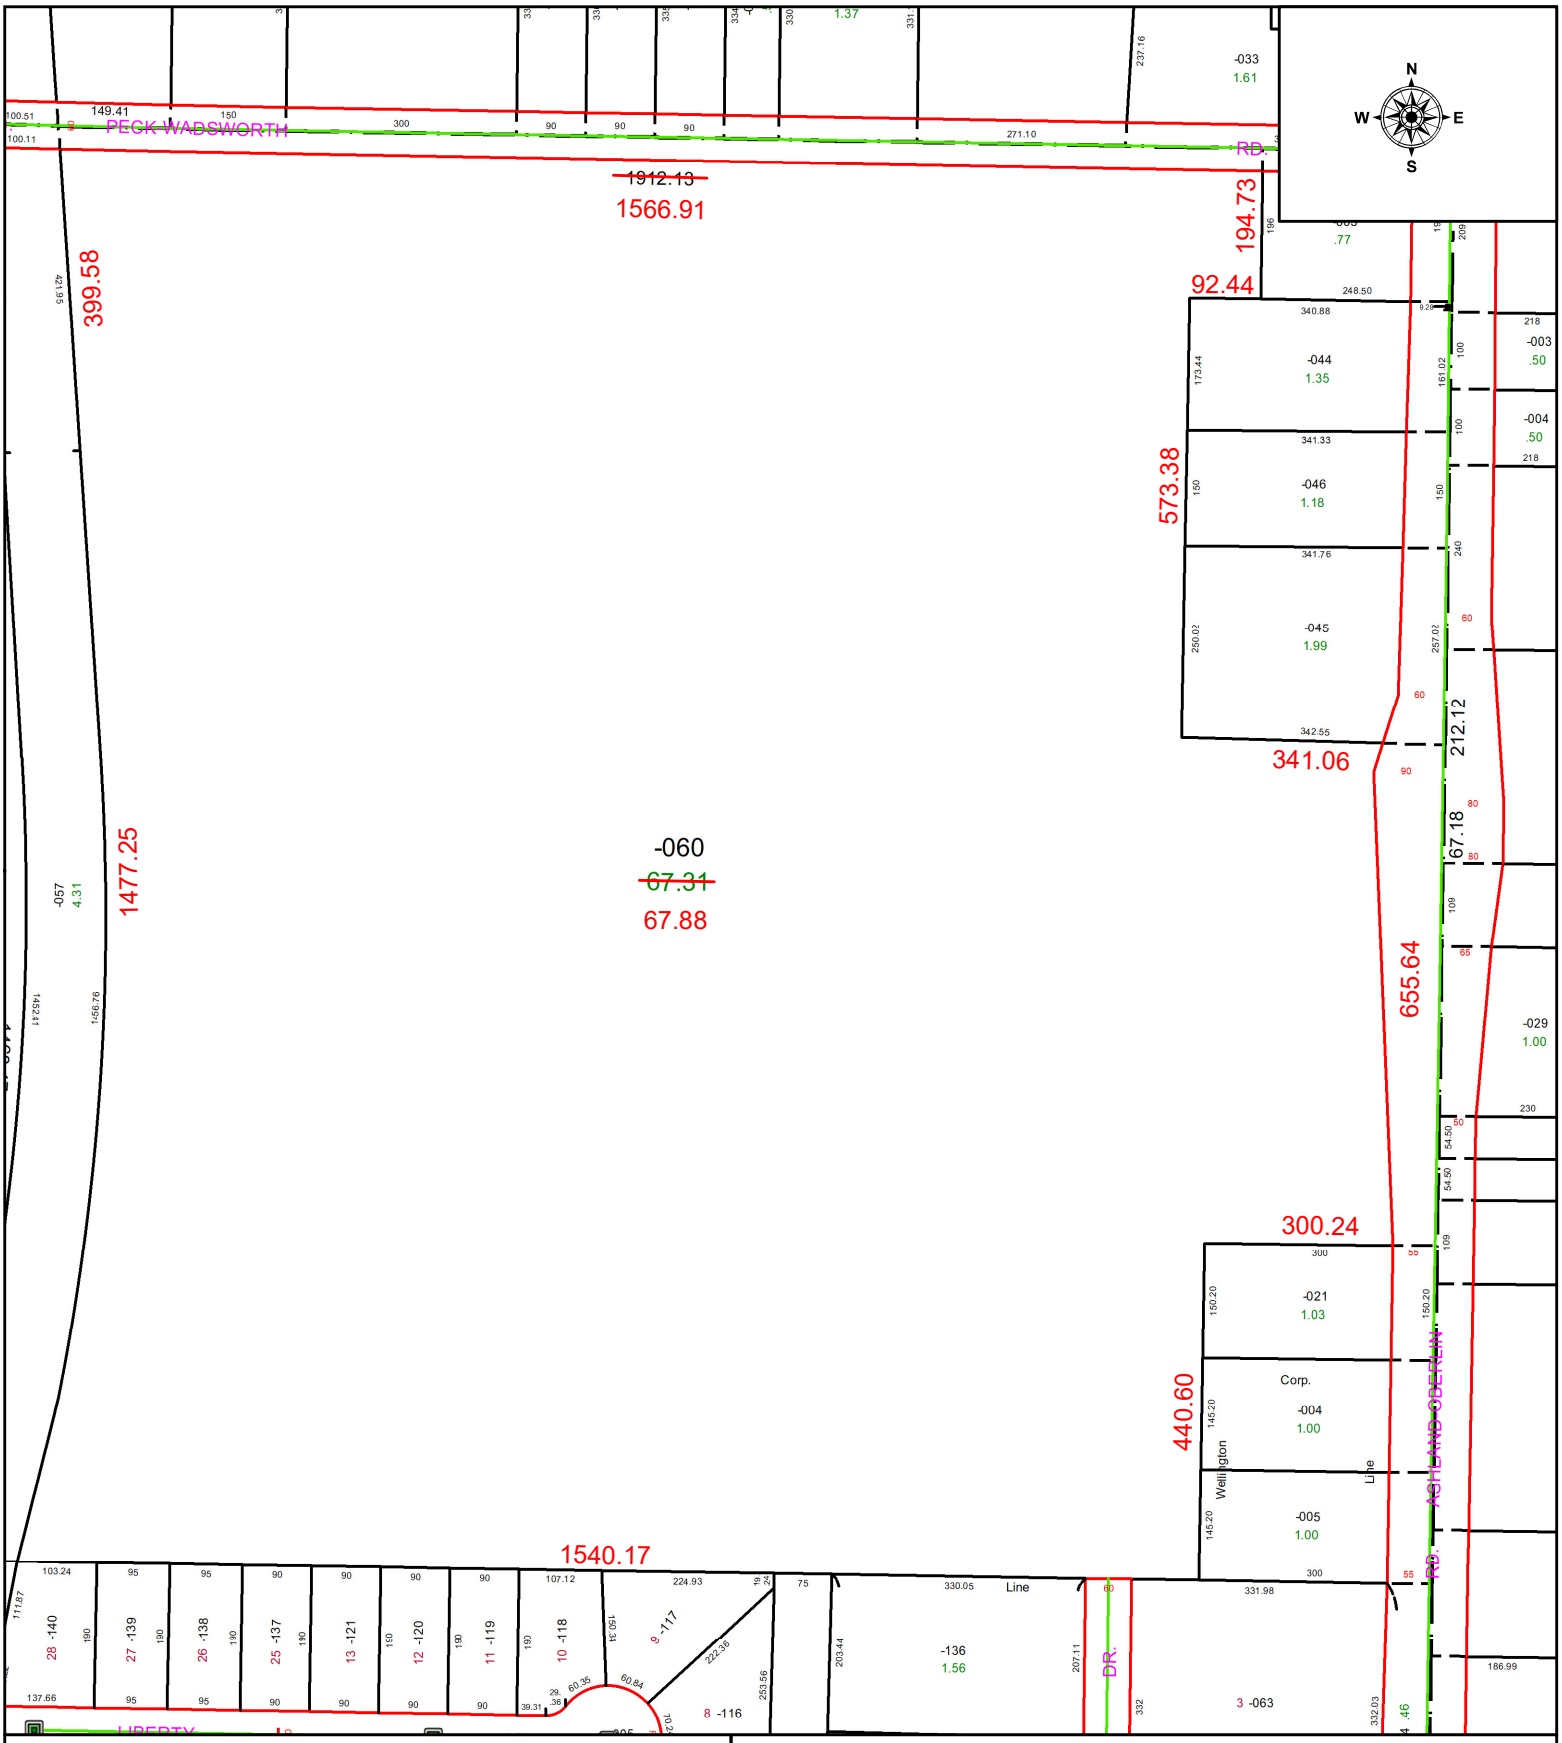

SPLITS/DEEDS PROCESSED

LORAIN COUNTY TAX MAP DEPARTMENT
226 MIDDLE AVE. ELYRIA, OH

SURVEYED BY: THOMAS SIMON SURVEY # 51259

CLOSURE: 1: 285622

MAP PAGE(S): 18-00-029

APPOVED BY: WRZ **DATE:** 8/27/2024

SCALE: 1" = 250 **PRIOR INSTRUMENT:** #2013-0463358