PARENT PARCEL: 02-02-008-107-063
CHILD PARCEL: AC. CORR. PER DEED INST. # 2024-0024321
STARTING POINT: I.P. FD. CL OF JEAGER RD. & WEST LINE OF O.L. 8, TRACT 2

24-05357-C

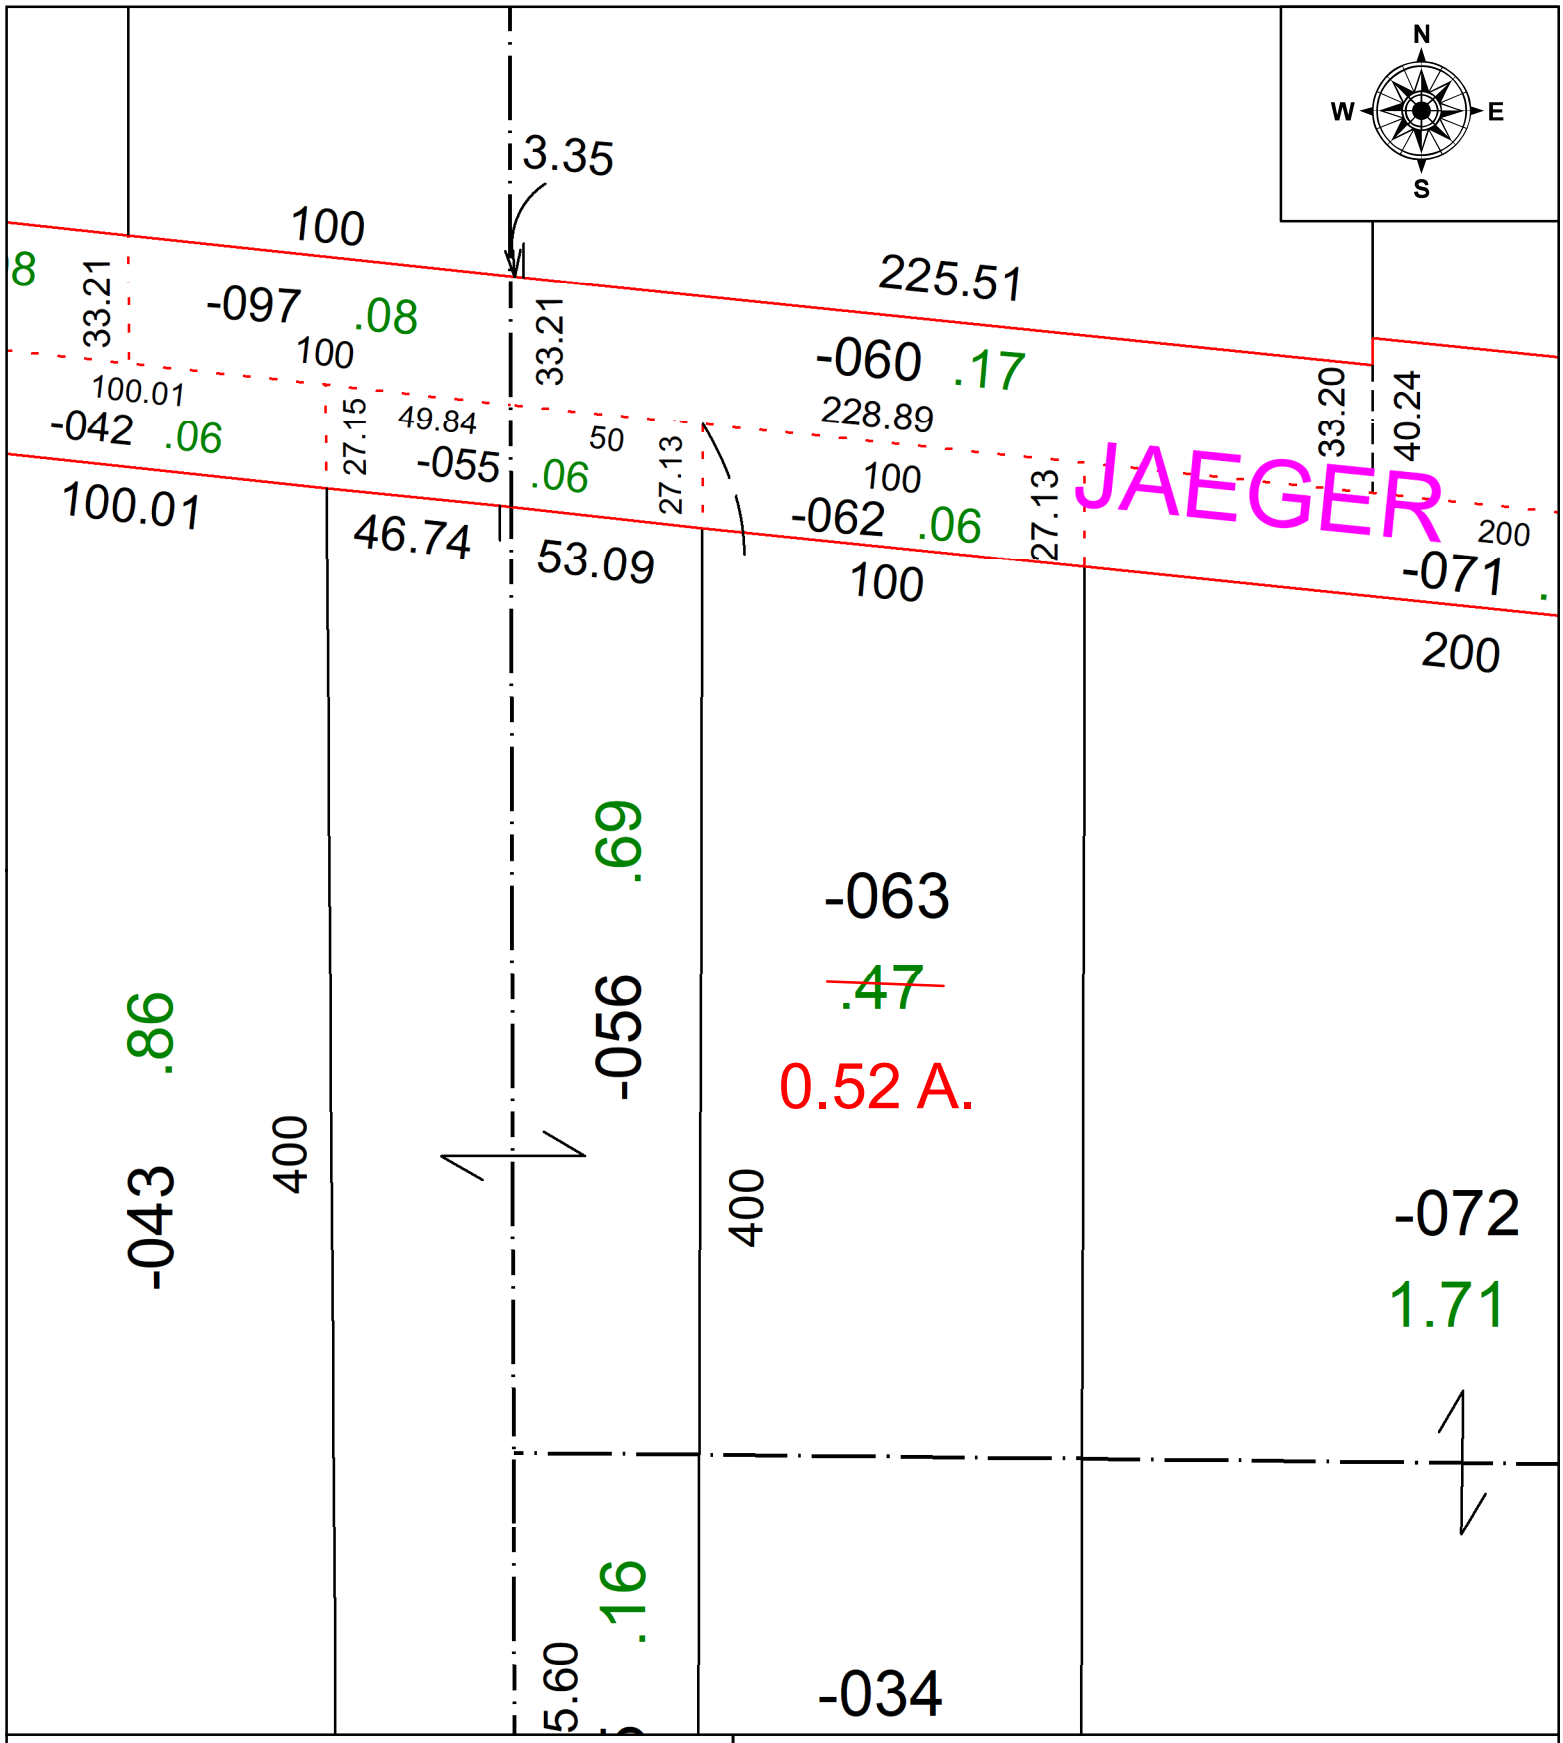

SPLITS/DEEDS PROCESSED
LORAIN COUNTY TAX MAP DEPARTMENT
226 MIDDLE AVE. ELYRIA, OH

SURVEYED BY: HURA
CLOSURE: 1: INF
MAP PAGE(S): 02-02-008
APPOVED BY: TJS **DATE:** 8/27/2024
SCALE: 1" = 50' **PRIOR INSTRUMENT:** 1998-0518531