PARENT PARCEL: 18-00-044-000-024

CHILD PARCEL: AC CORR PER INSTRUMENT NO. 2021- 0808613

STARTING POINT: C/L OF PECK WADSWORTH AND QUARRY RD

24-05361-C

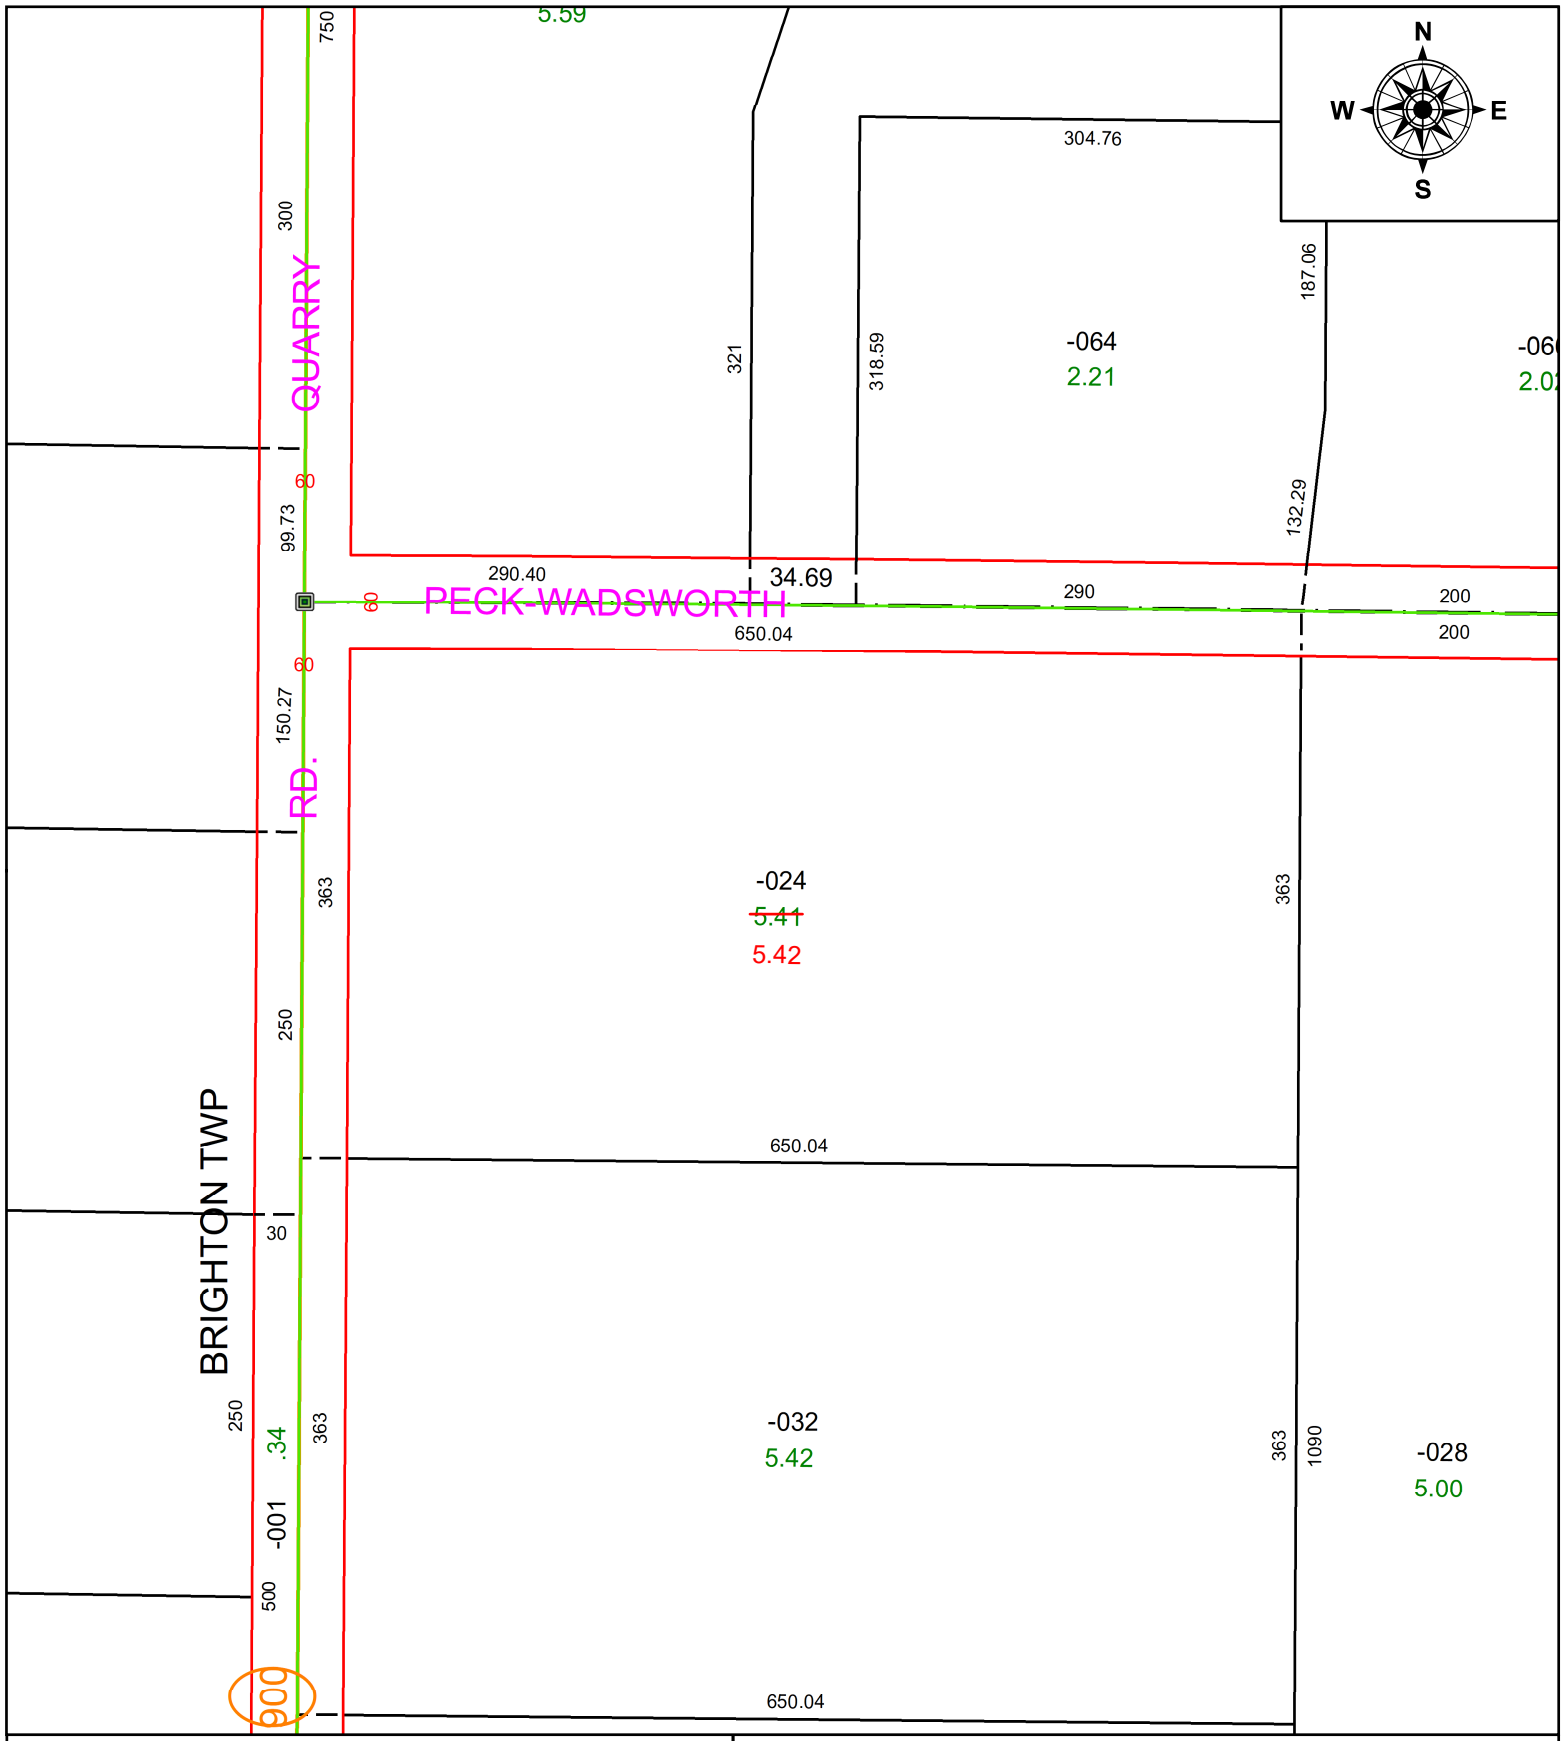

SPLITS/DEEDS PROCESSED

LORAIN COUNTY TAX MAP DEPARTMENT
226 MIDDLE AVE. ELYRIA, OH

SURVEYED BY: N/A **SURV # N/A**

CLOSURE: 1: 100789

MAP PAGE(S): 18-00-044

APPOVED BY: AC **DATE:** September 03, 2024

SCALE: 1 in = 125 ft **PRIOR INSTRUMENT:** 2021- 0808613