PARENT PARCEL: 05-00-036-101-009

CHILD PARCEL: FRONT & DEPTH TO AC CORR PER SURV BY ROBERT M. RUFFING

STARTING POINT: E LINE OF JACKSON AND N LINE OF ELYRIA AVE

24-05362-C

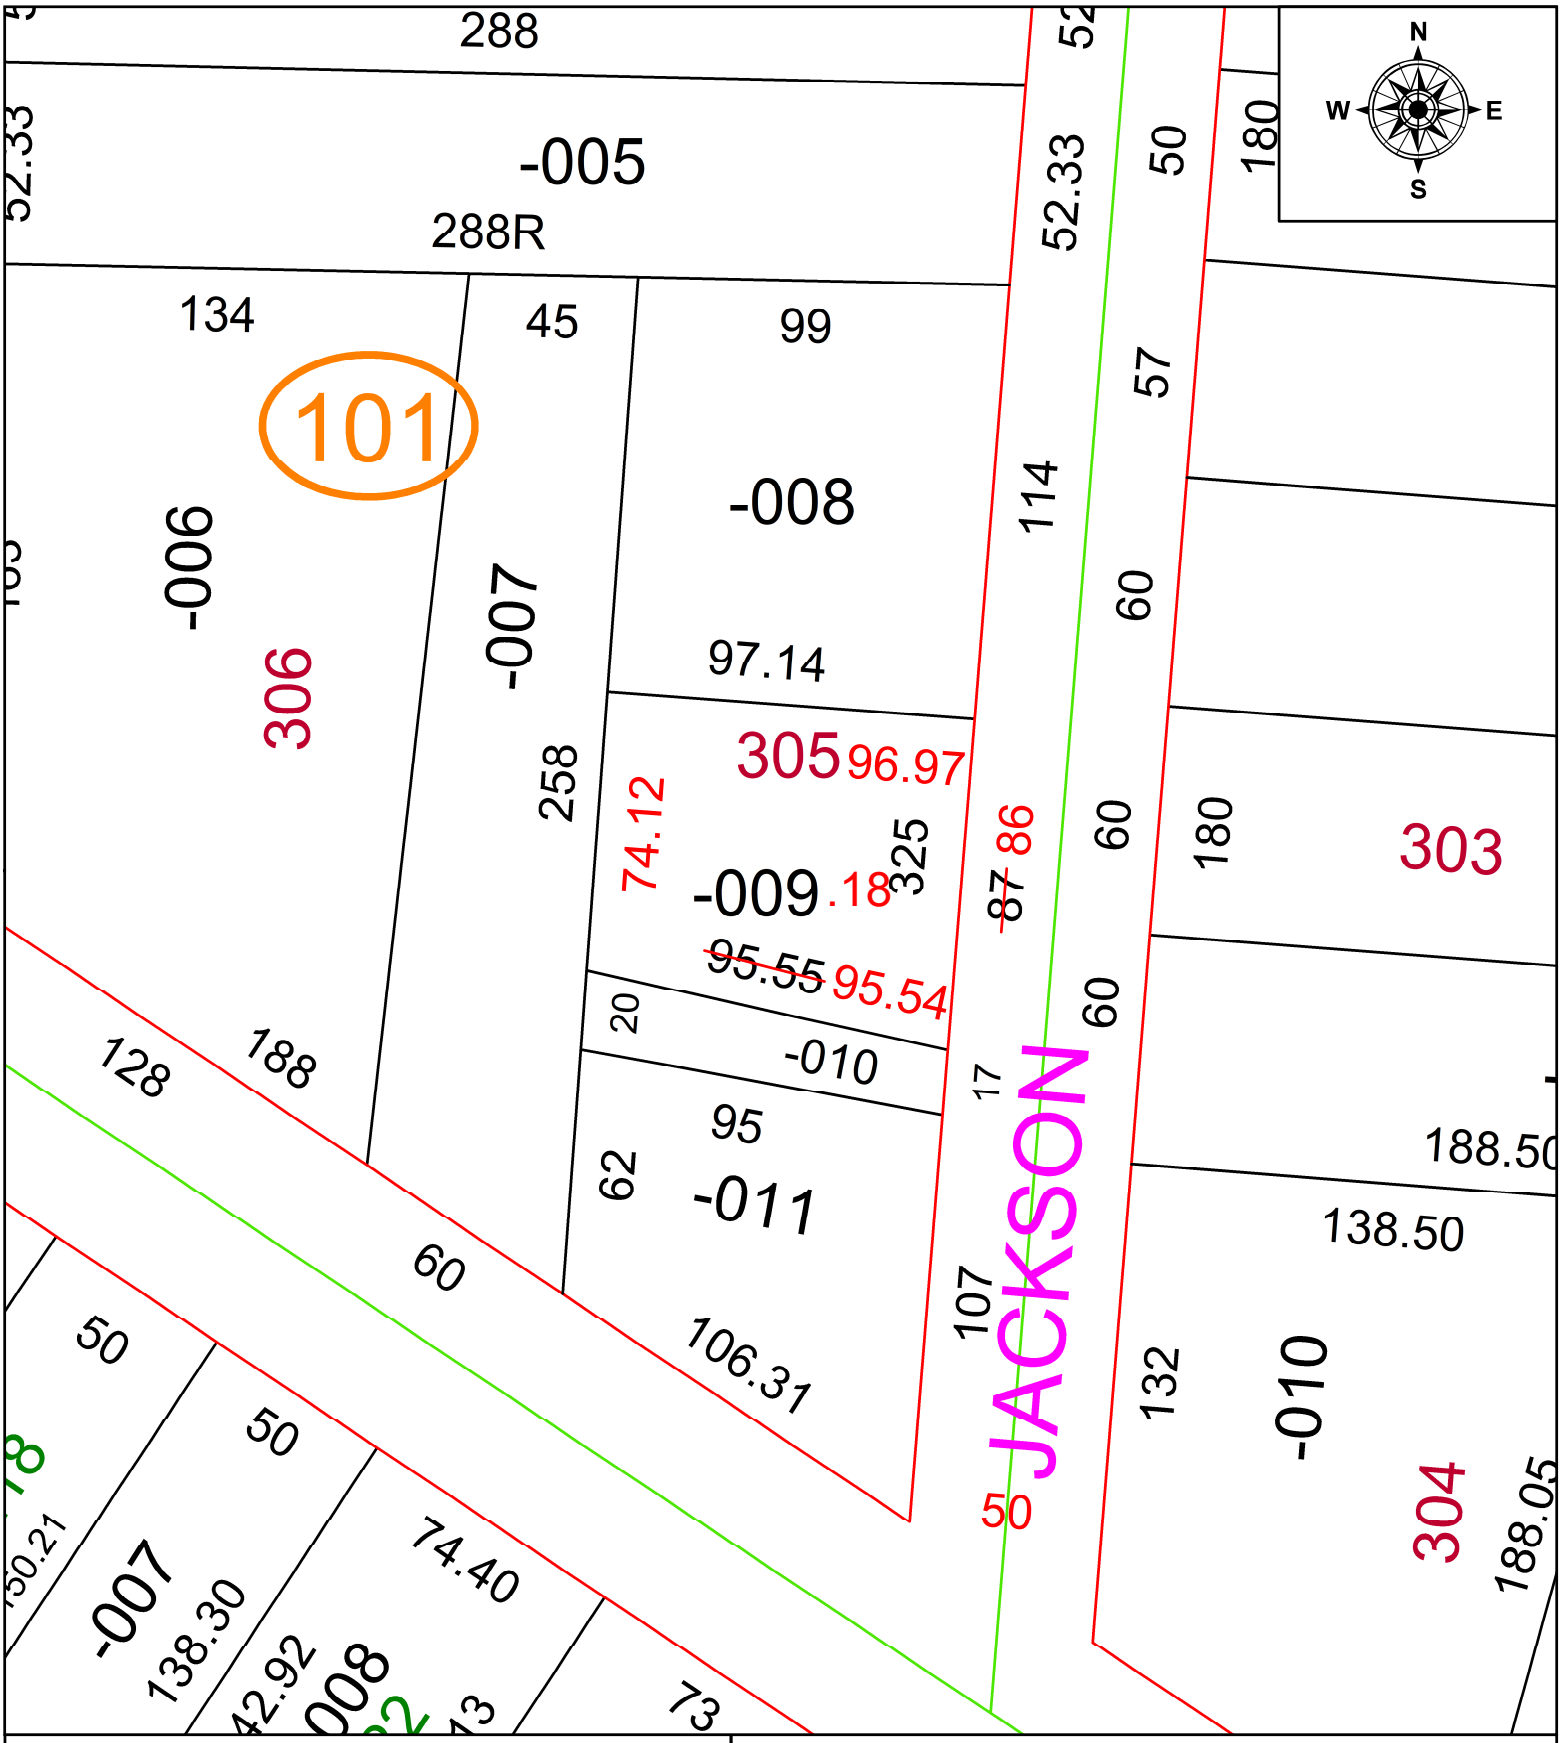

SPLITS/DEEDS PROCESSED

LORAIN COUNTY TAX MAP DEPARTMENT
226 MIDDLE AVE. ELYRIA, OH

SURVEYED BY: ROBERT M. RUFFING **SURV # 51270**

CLOSURE: 1: 46012

MAP PAGE(S): 05-00-036

APPOVED BY: AC **DATE:** September 09, 2024

SCALE: 1 in = 50 ft **PRIOR INSTRUMENT:** 2002- 0804283