PARENT PARCEL: 15-00-064-000-004

CHILD PARCEL: AC CORR PER SURV BY JOHNATHAN A. EASTON

STARTING POINT: C/L OF WHITNEY AND SW CORNER OF O/L 64

24-05364-C

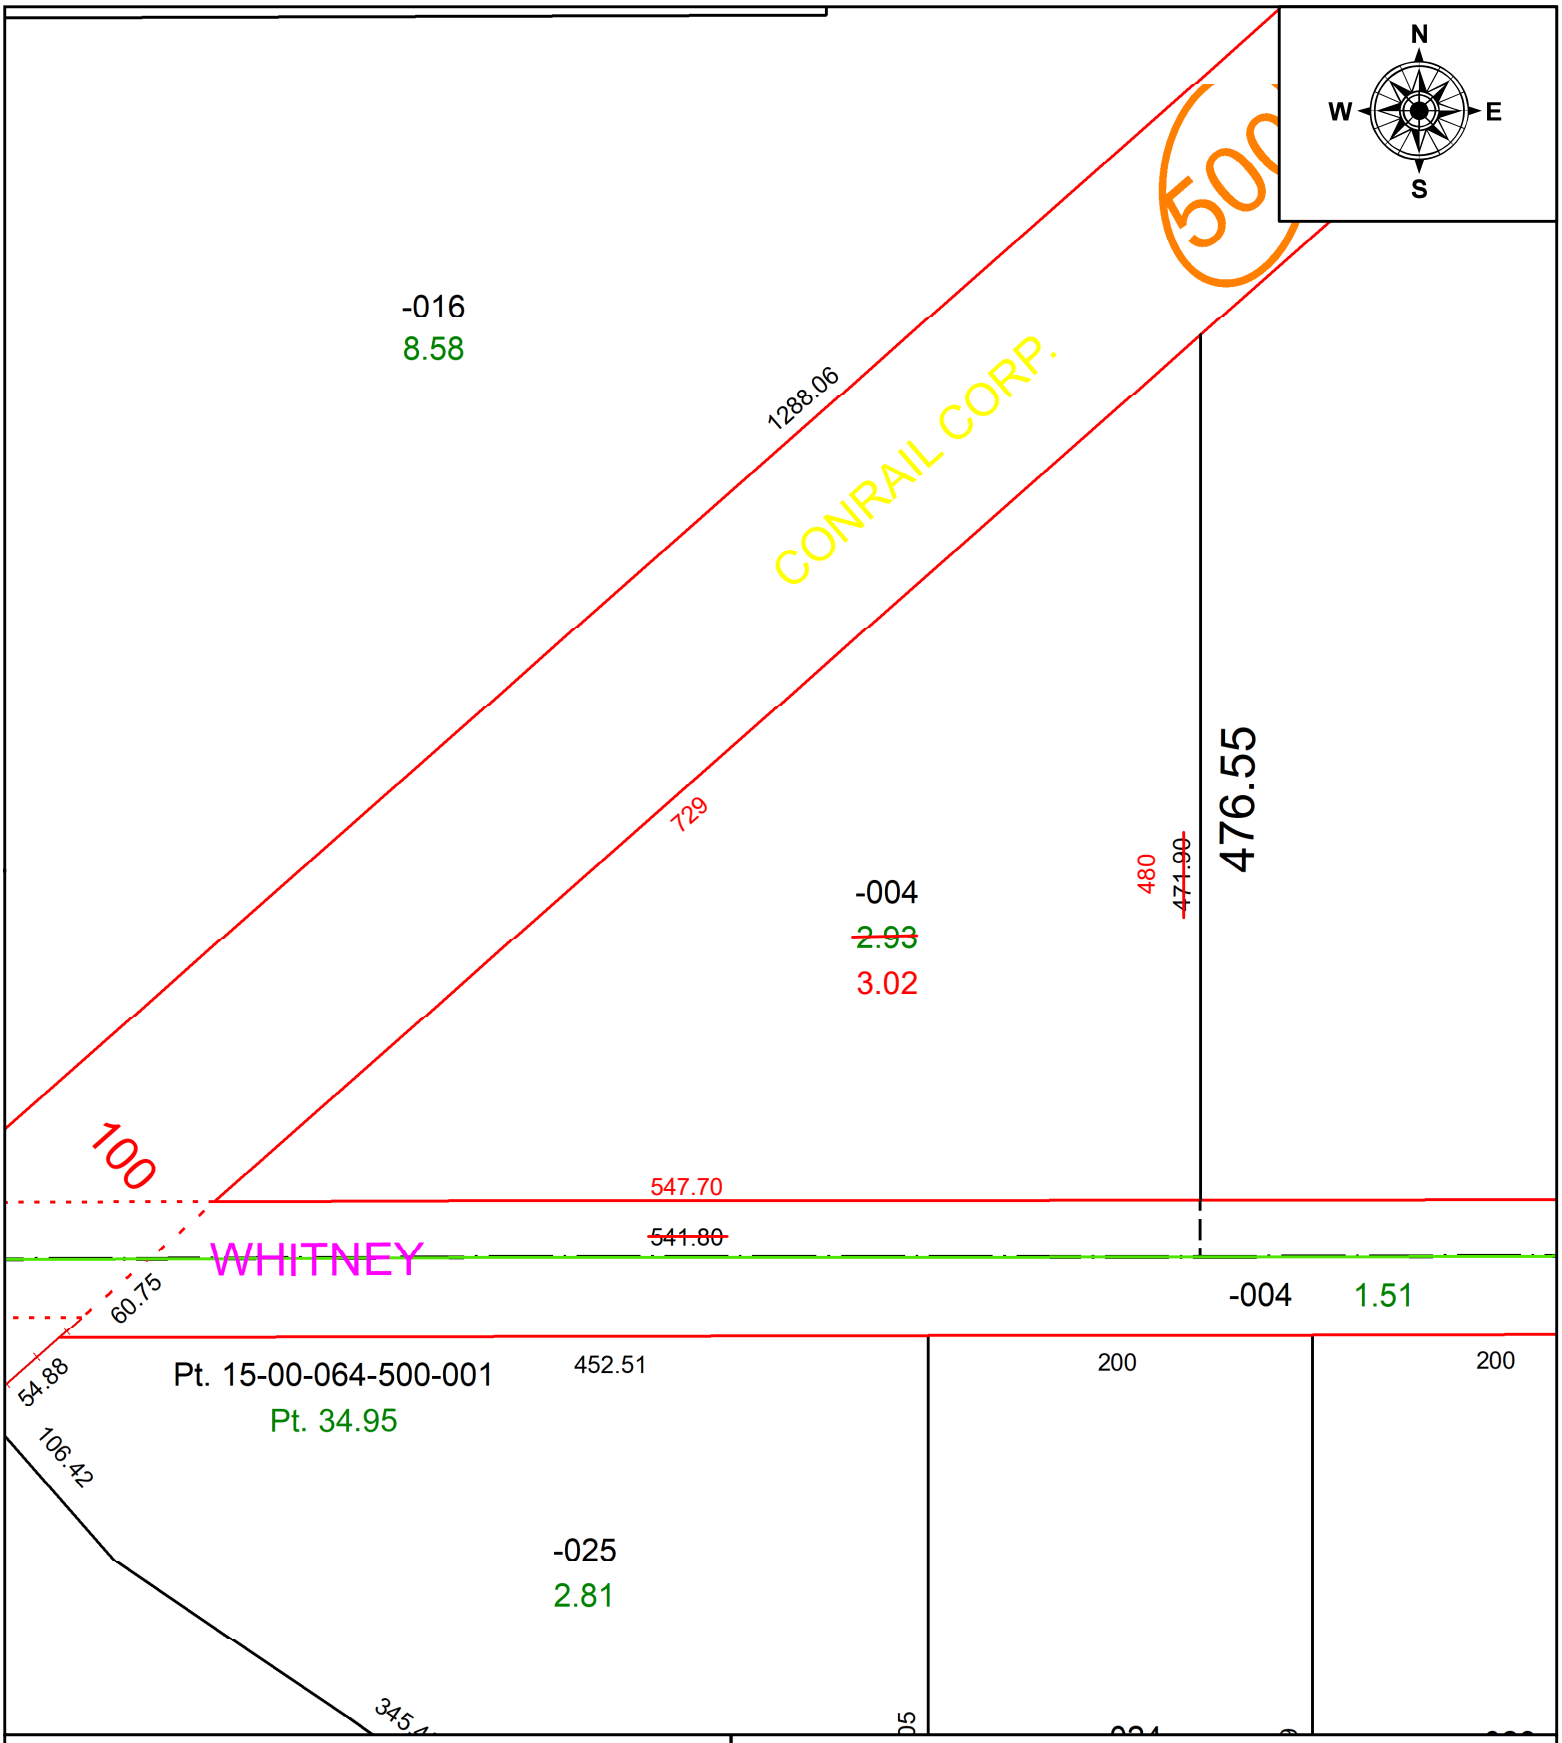

SPLITS/DEEDS PROCESSED

LORAIN COUNTY TAX MAP DEPARTMENT
226 MIDDLE AVE. ELYRIA, OH

SURVEYED BY: JOHNATHAN A. EASTON **SURV # 51274**

CLOSURE: 1: 193016

MAP PAGE(S): 15-00-064

APPOVED BY: AC **DATE:** September 13, 2024

SCALE: 1 in = 100 ft **PRIOR INSTRUMENT:** VOL 401 PG 326