PARENT PARCEL: 06-25-176-104-003, -004, & -015

CHILD PARCEL: 06-25-176-104-043

STARTING POINT: AC CORR PER SURV BY THOMAS A. SIMON

24-05366-C

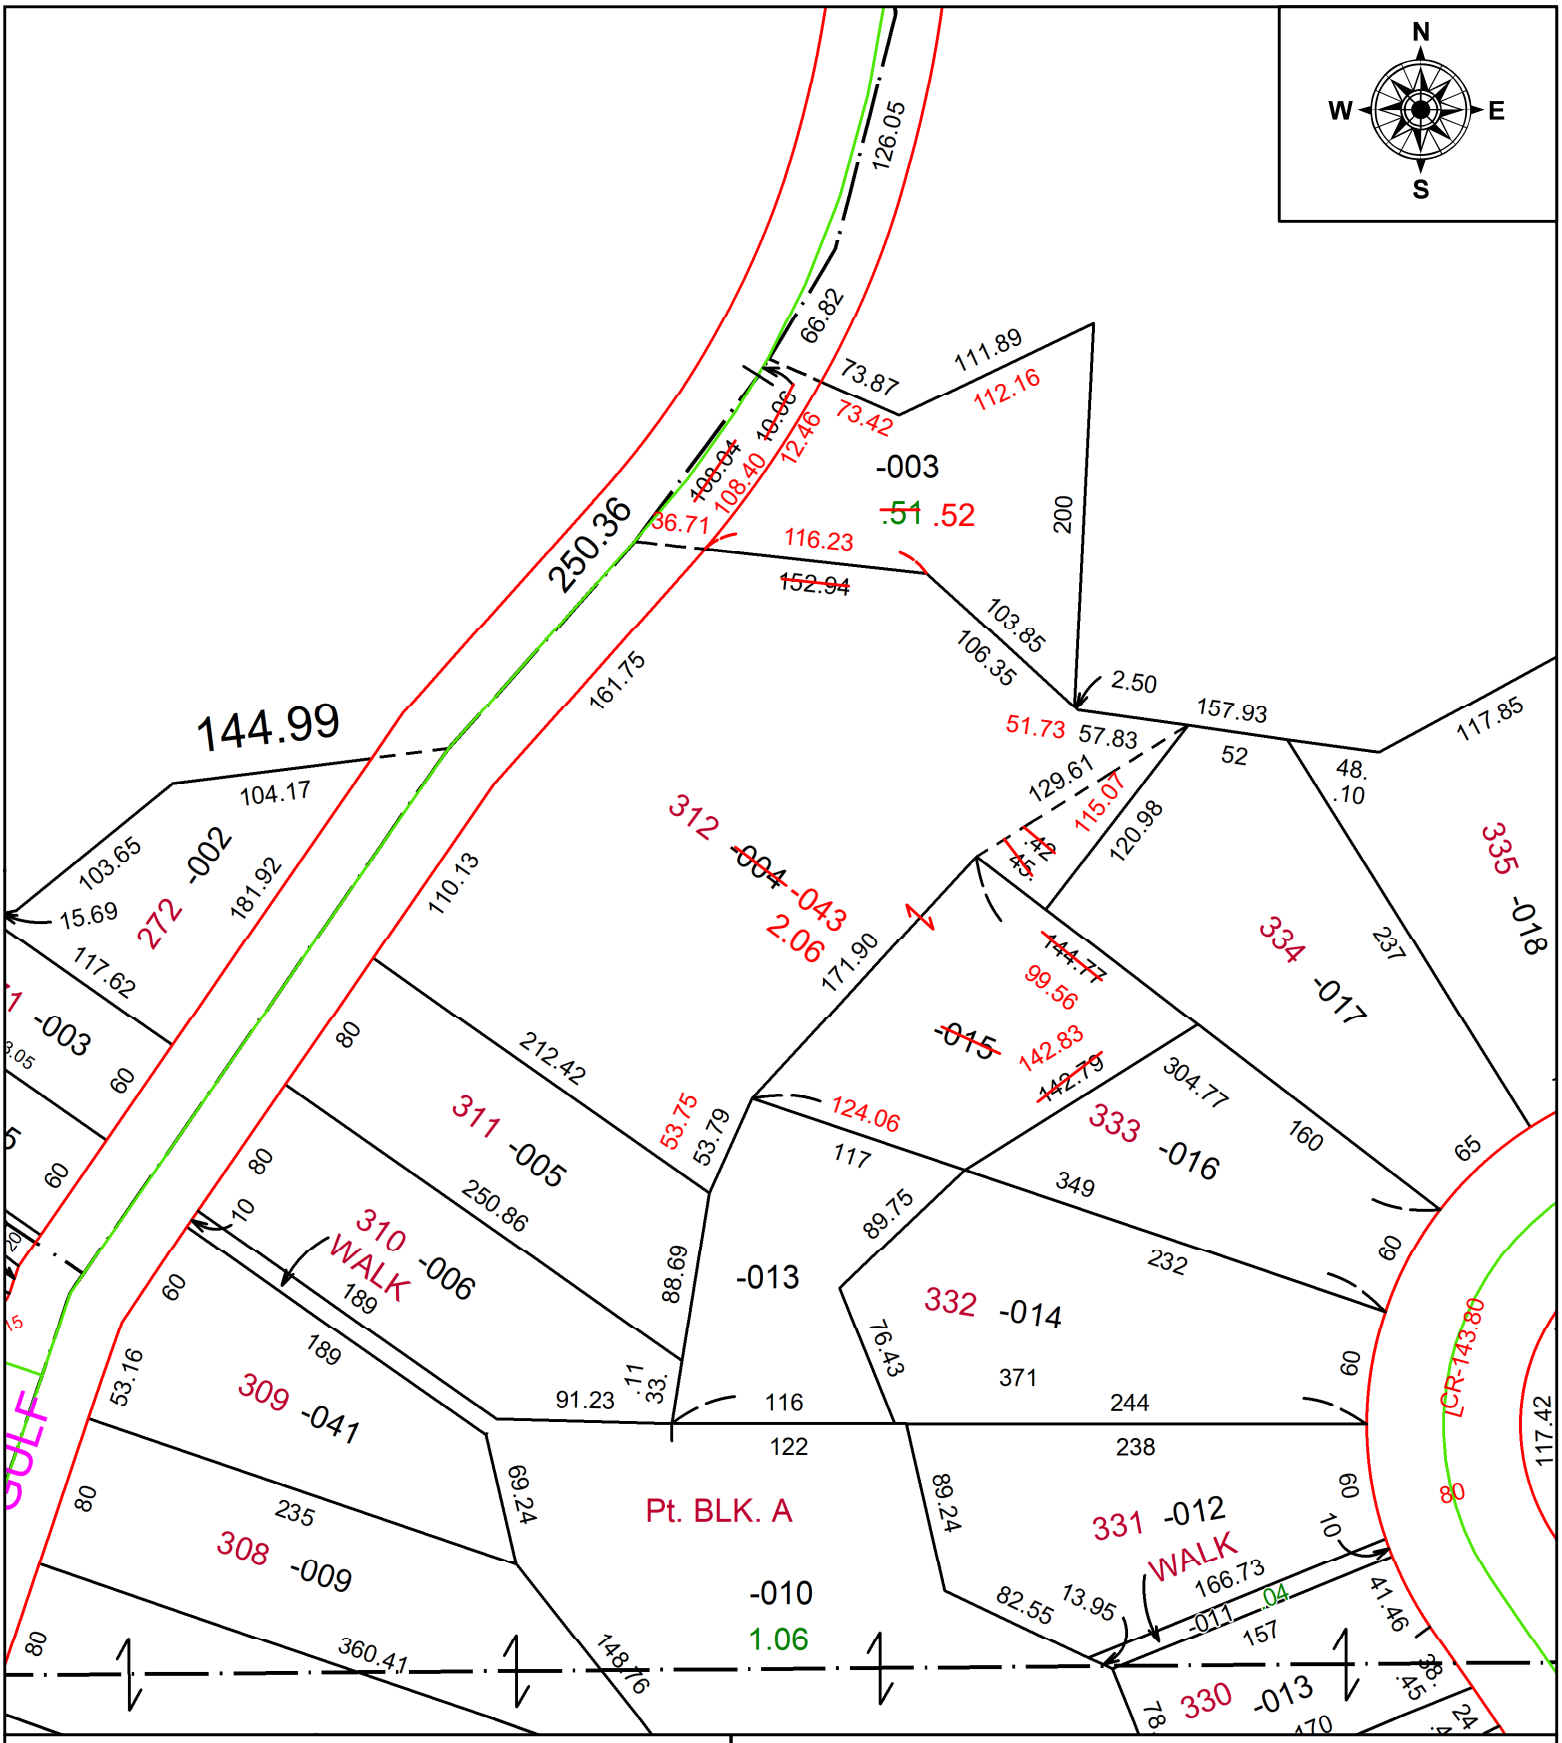

SPLITS/DEEDS PROCESSED

LORAIN COUNTY TAX MAP DEPARTMENT
226 MIDDLE AVE. ELYRIA, OH

SURVEYED BY: THOMAS A. SIMON **SURV # 51275**

CLOSURE: 1: 345055

MAP PAGE(S): 06-25

APPOVED BY: AC **DATE:** September 16, 2024

SCALE: 1 in = 100 ft **PRIOR INSTRUMENT:** 2024- 0009745