PARENT PARCEL: 13-10-003-000-023

CHILD PARCEL: 13-10-003-000-030 & -031 UNCOMBINATION PER #1988-0022850 & DV 196/434

STARTING POINT: INTERSECTION OF C/L BAIRD RD & SOUTHEAST CORNER OF MARVIN B. & JUDITH E. FANNIN DV 1131/522

24-05382-U

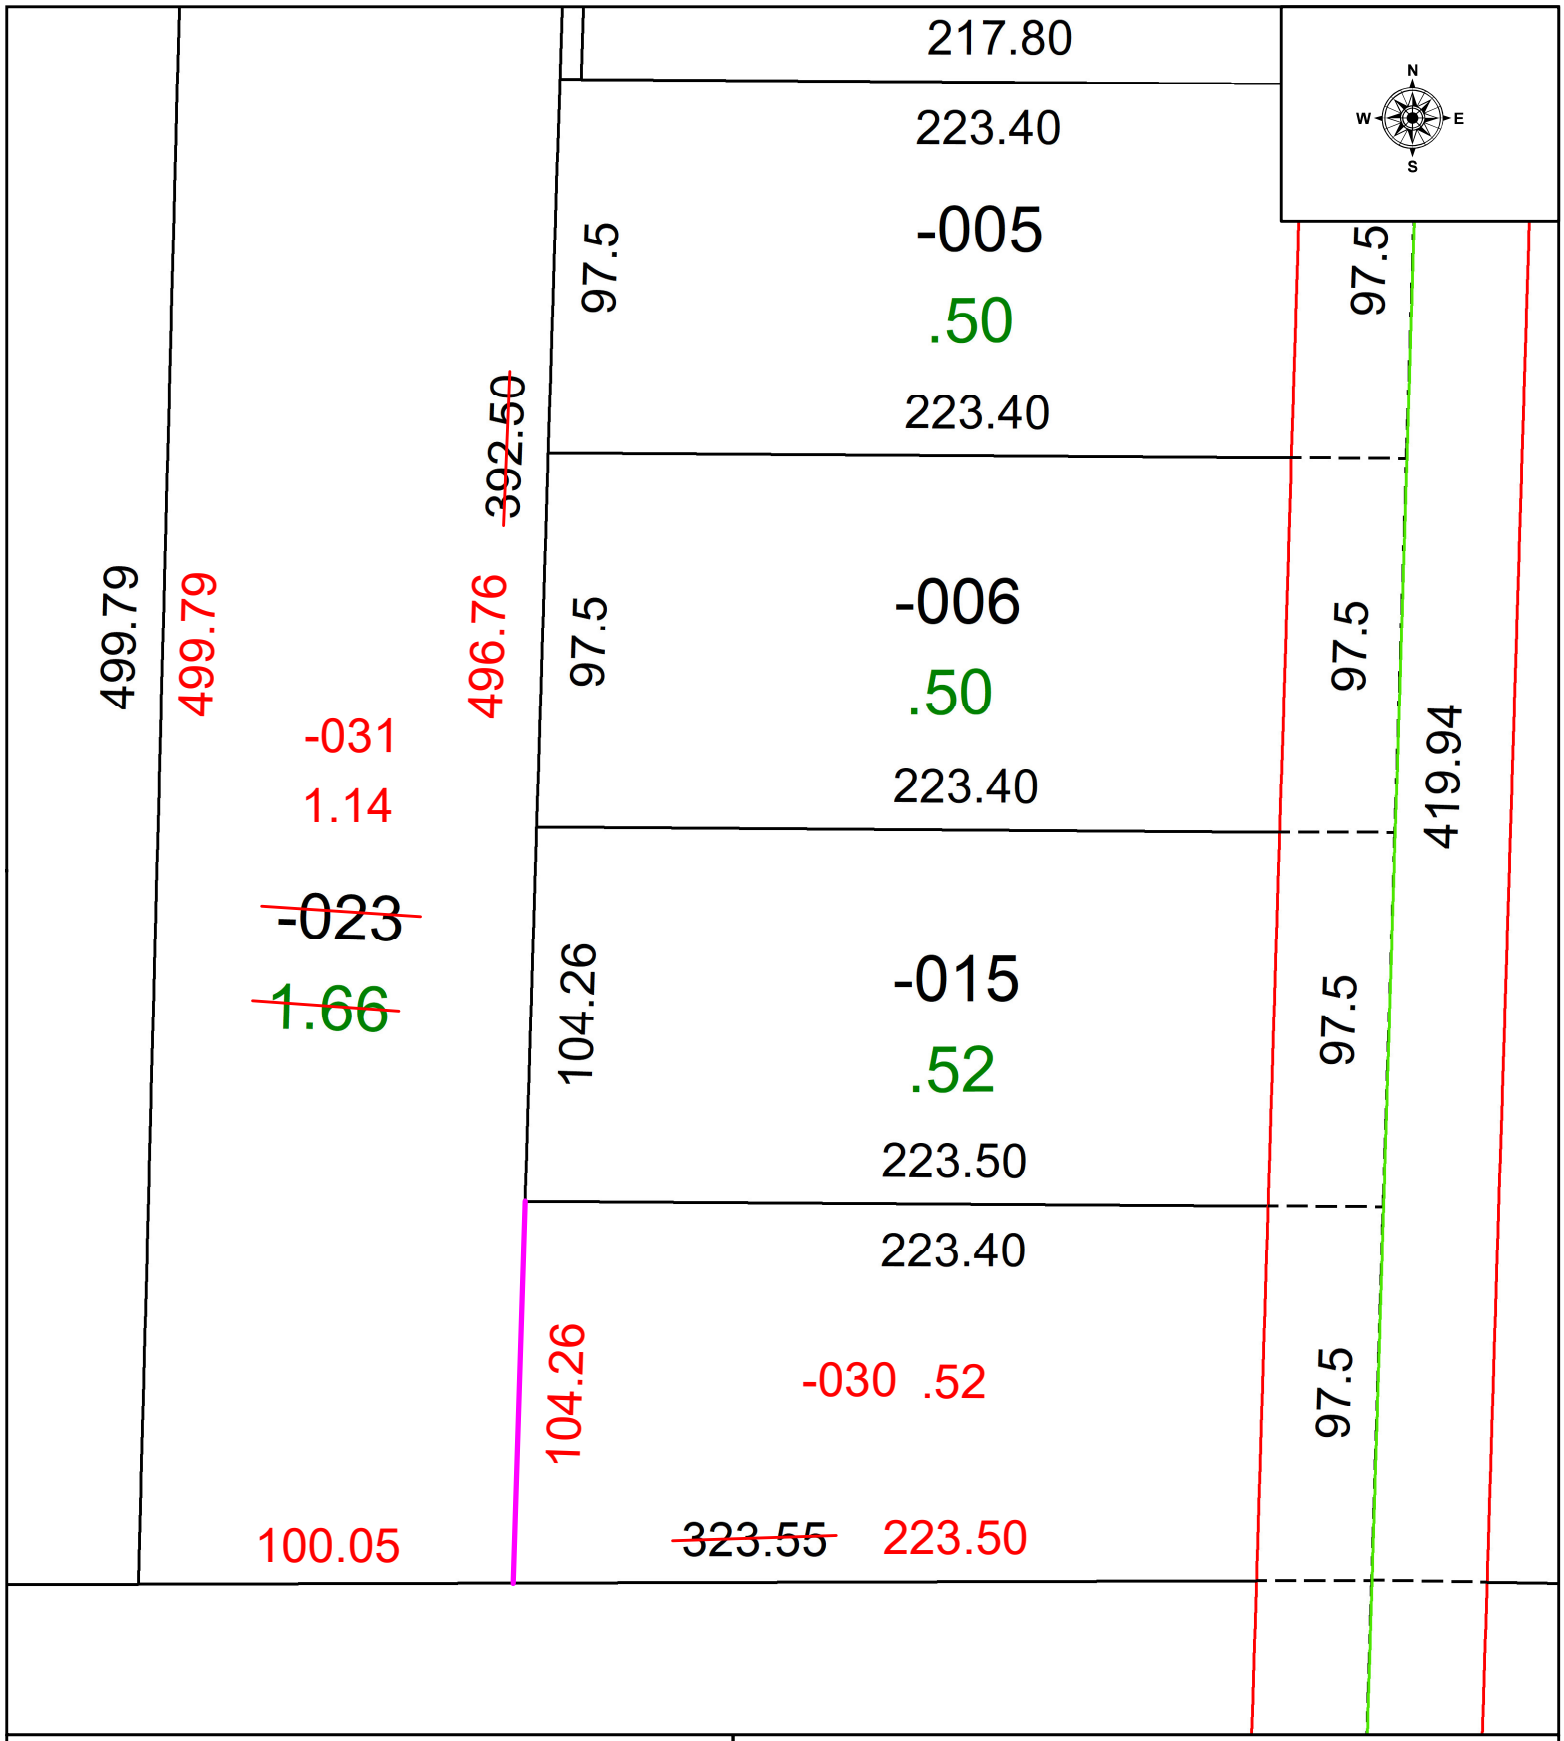

SPLITS/DEEDS PROCESSED

LORAIN COUNTY TAX MAP DEPARTMENT
226 MIDDLE AVE. ELYRIA, OH

SURVEYED BY: LAWRENCE MCGLINCHY SURVEY # N/A
CLOSURE: 1: 212907
MAP PAGE(S): 13-10-003
APPOVED BY: WRZ **DATE:** 10/7/2024 #1988-0022850
SCALE: 1" = 50 **PRIOR INSTRUMENT:** DV 196/434