PARENT PARCEL: 01-00-003-103-035 & -036
CHILD PARCEL: 01-00-003-103-072
STARTING POINT: COMBINATION PER DEED

24-05388-C

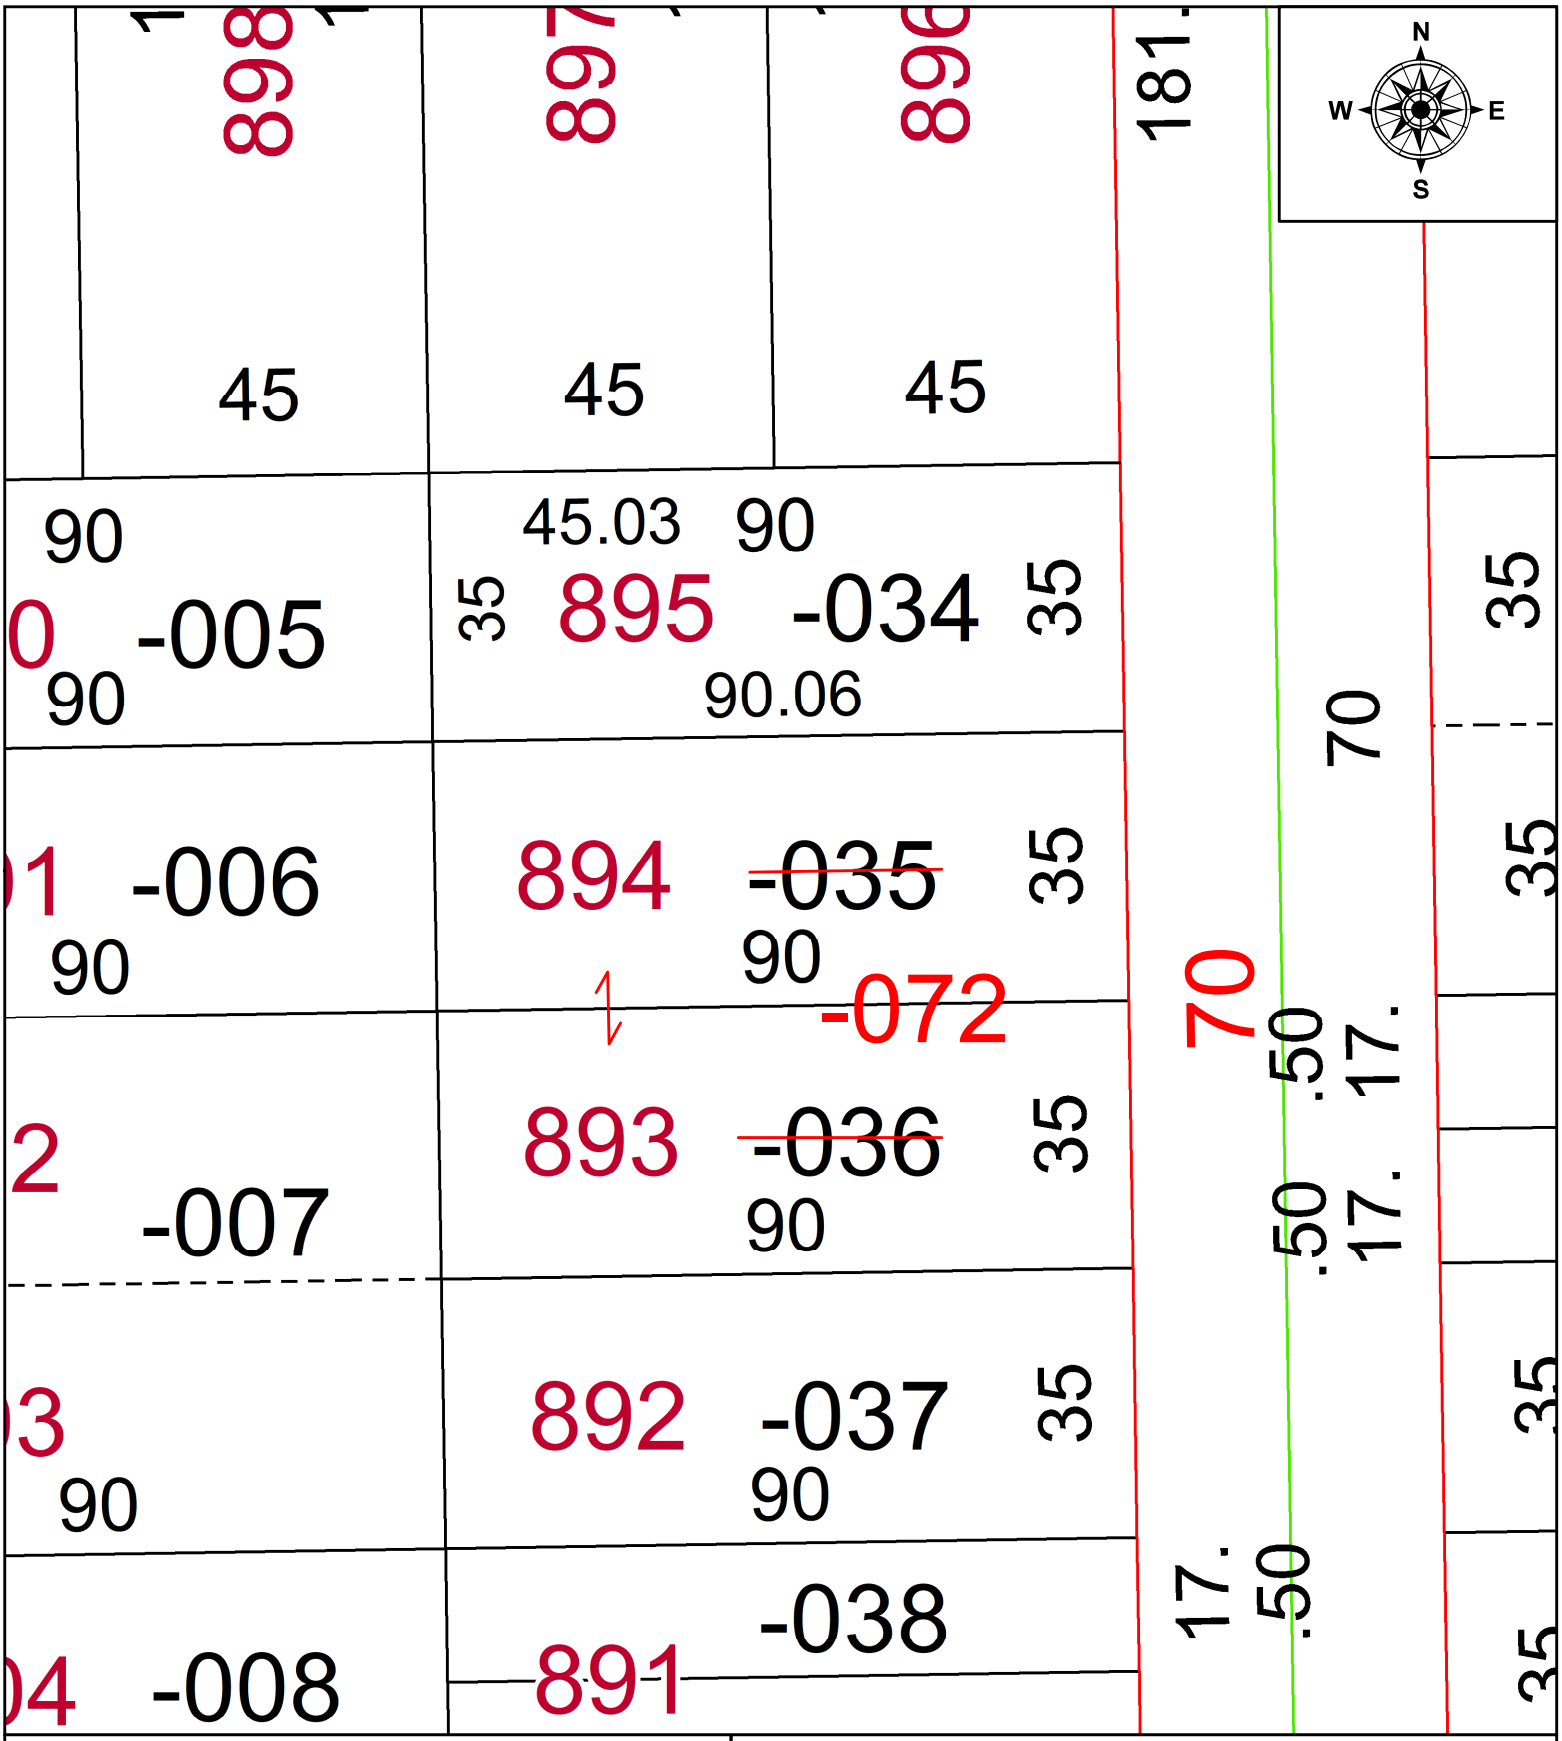

SPLITS/DEEDS PROCESSED
LORAIN COUNTY TAX MAP DEPARTMENT
226 MIDDLE AVE. ELYRIA, OH

SURVEYED BY: N/A **SURV # N/A**
CLOSURE: 1: N/A
MAP PAGE(S): 01-00-003
APPOVED BY: AC **DATE:** October 16, 2024
SCALE: 1 in = 25 ft **PRIOR INSTRUMENT:** 2024- 0029319