**PARENT PARCEL:** 05-00-021-102-004

**CHILD PARCEL:** AC COR PER SURVEYOR RONALD W. HINTON

**STARTING POINT:** C/Ls OF NORTH MAIN ST & COOPER FOSTER PARK RD

24-05389-C

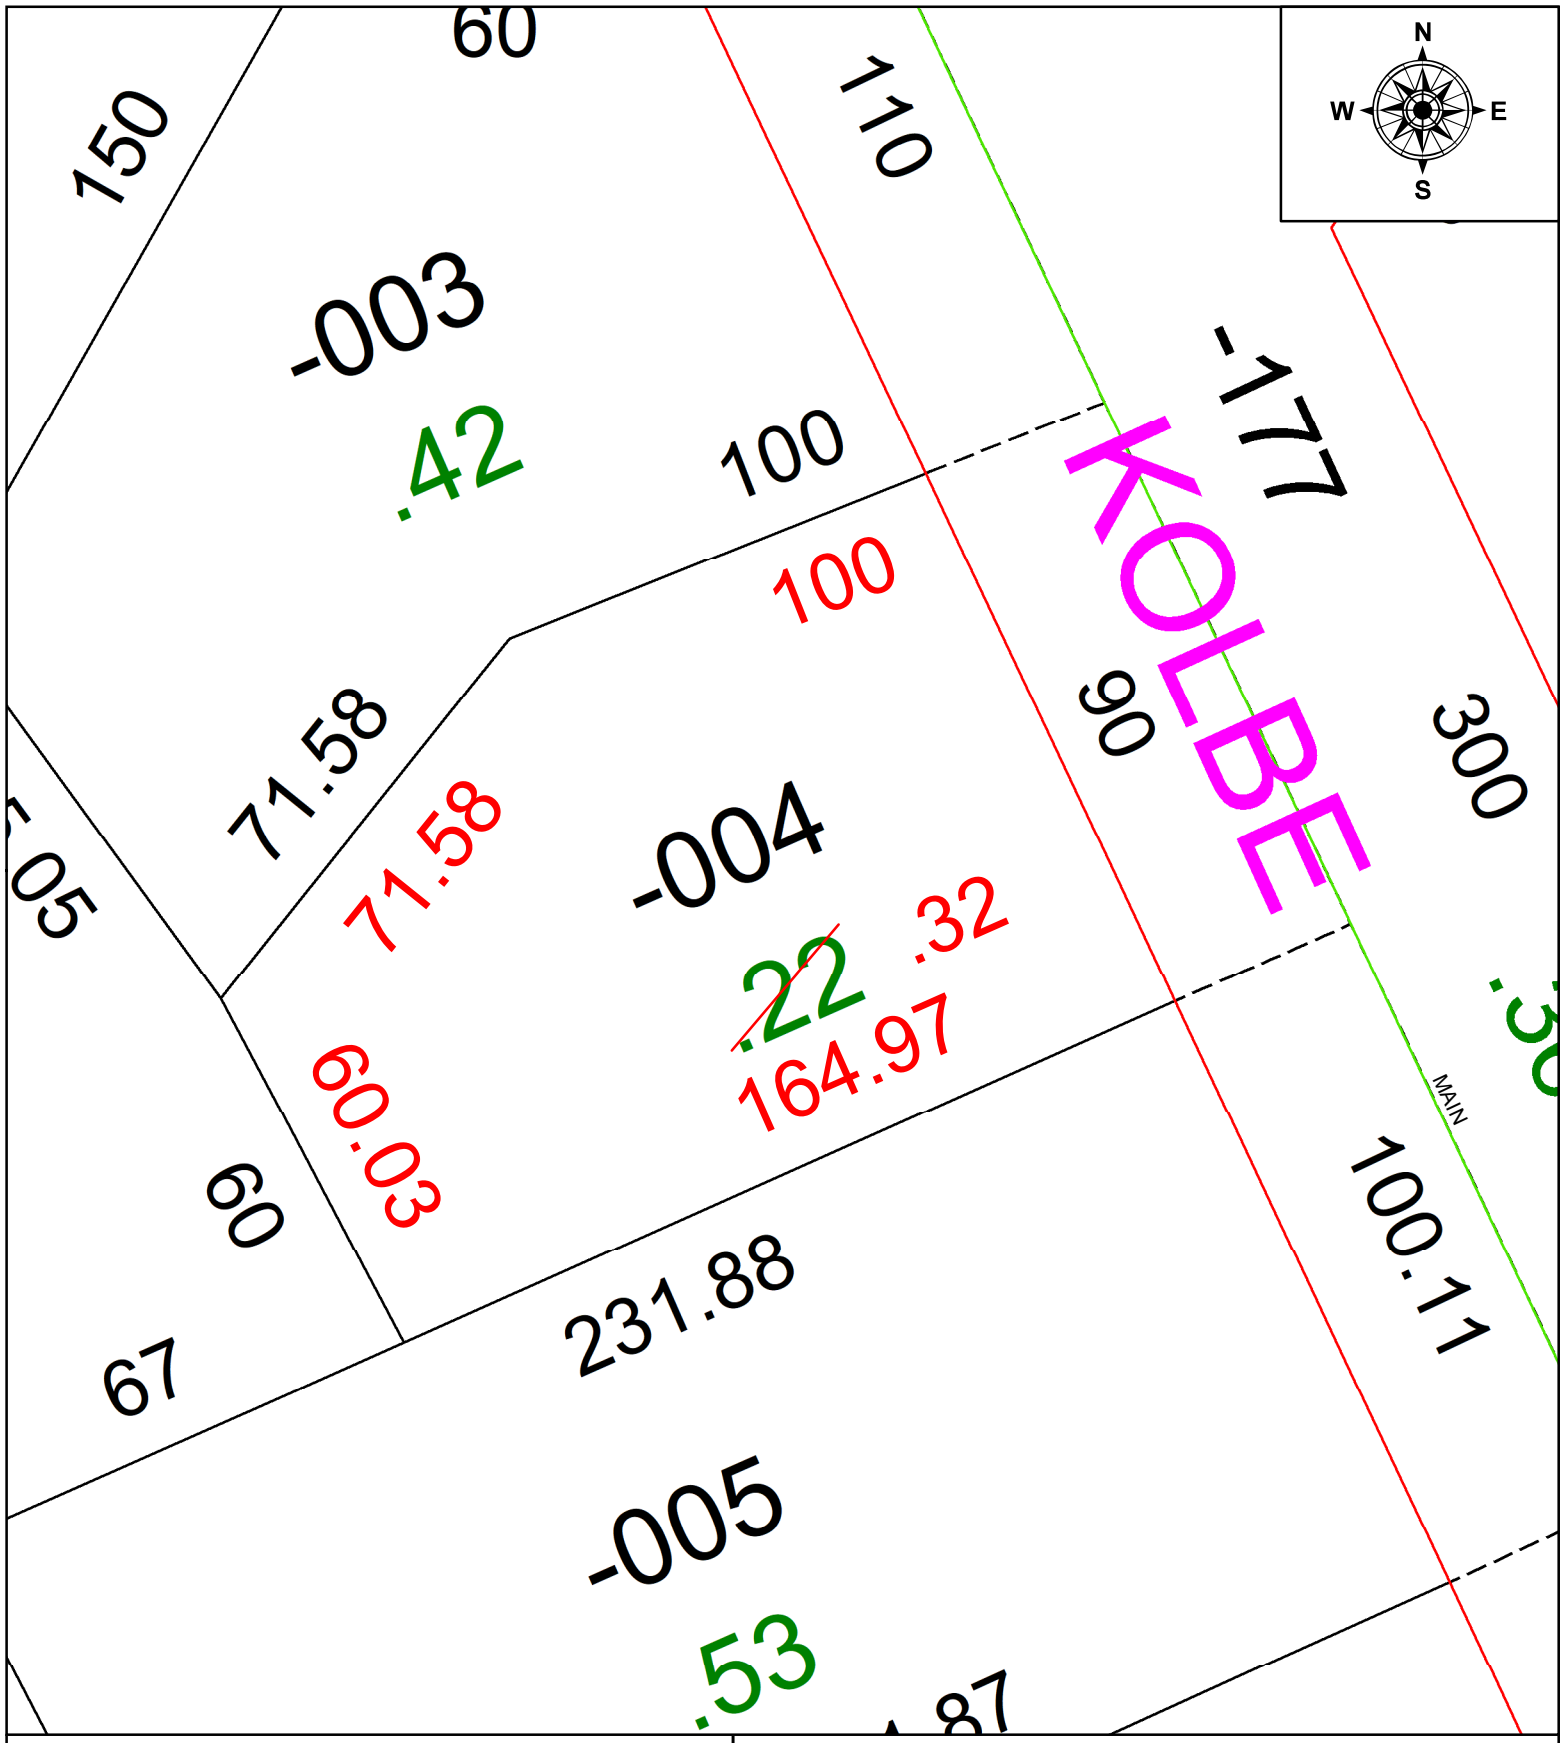


**SPLITS/DEEDS PROCESSED**

LORAIN COUNTY TAX MAP DEPARTMENT
226 MIDDLE AVE. ELYRIA, OH

**SURVEYED BY:** RONALD W. HINTON **SURVEY #:** 51300

**CLOSURE:** 1:314158

**MAP PAGE(S):** 0500021

**APPOVED BY:** BB **DATE:** 10/16/2024

**SCALE:** 1" = 30' **PRIOR INSTRUMENT:** #20230912972