PARENT PARCEL: 05-00-011-101-009 & -010

CHILD PARCEL: MAP CORRECTION ONLY

STARTING POINT: INTERSECTION OF C/LS OF E. MAIN ST & N. LAKE ST

24-05394-C

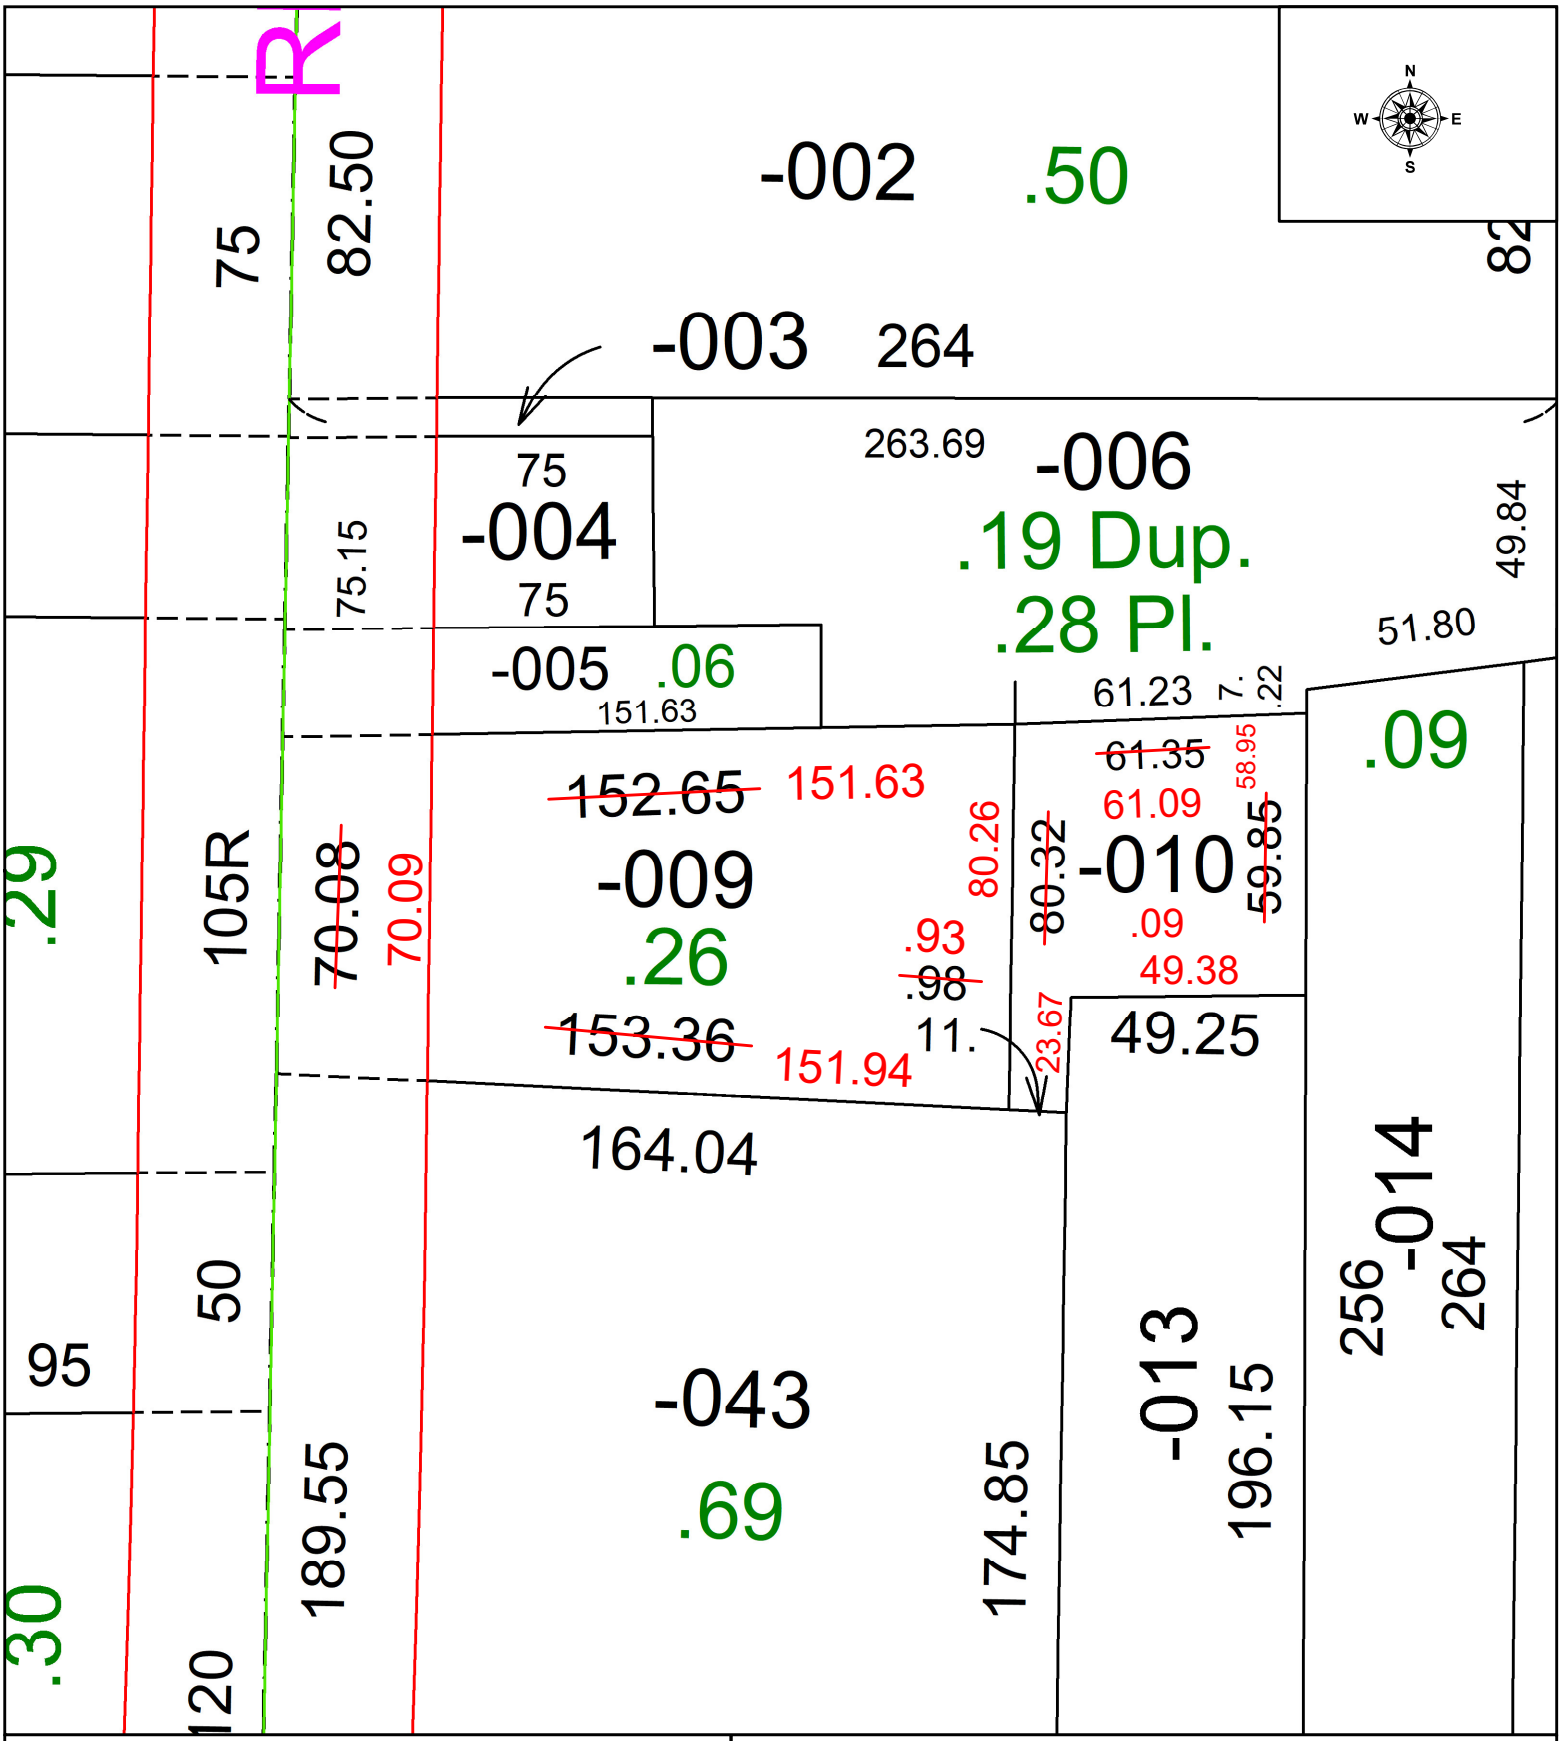

SPLITS/DEEDS PROCESSED

LORAIN COUNTY TAX MAP DEPARTMENT
226 MIDDLE AVE. ELYRIA, OH

SURVEYED BY: ROBERT RUFFING SURVEY # 51309

CLOSURE: 1: 92380

MAP PAGE(S): 05-00-011

APPOVED BY: WRZ **DATE:** 10/29/2024

SCALE: 1" = 40 **PRIOR INSTRUMENT:** #2023-0922972