PARENT PARCEL: ADD TO DUPLICATE - PER ORD. # 2024-80

CHILD PARCEL: 07-00-045-109-008 & 07-00-046-000-010

STARTING POINT: S.W. CORNER OF S/L 122 - THE MEADOWS NO. 1 PV. 11, PG. 4

24-05396-V

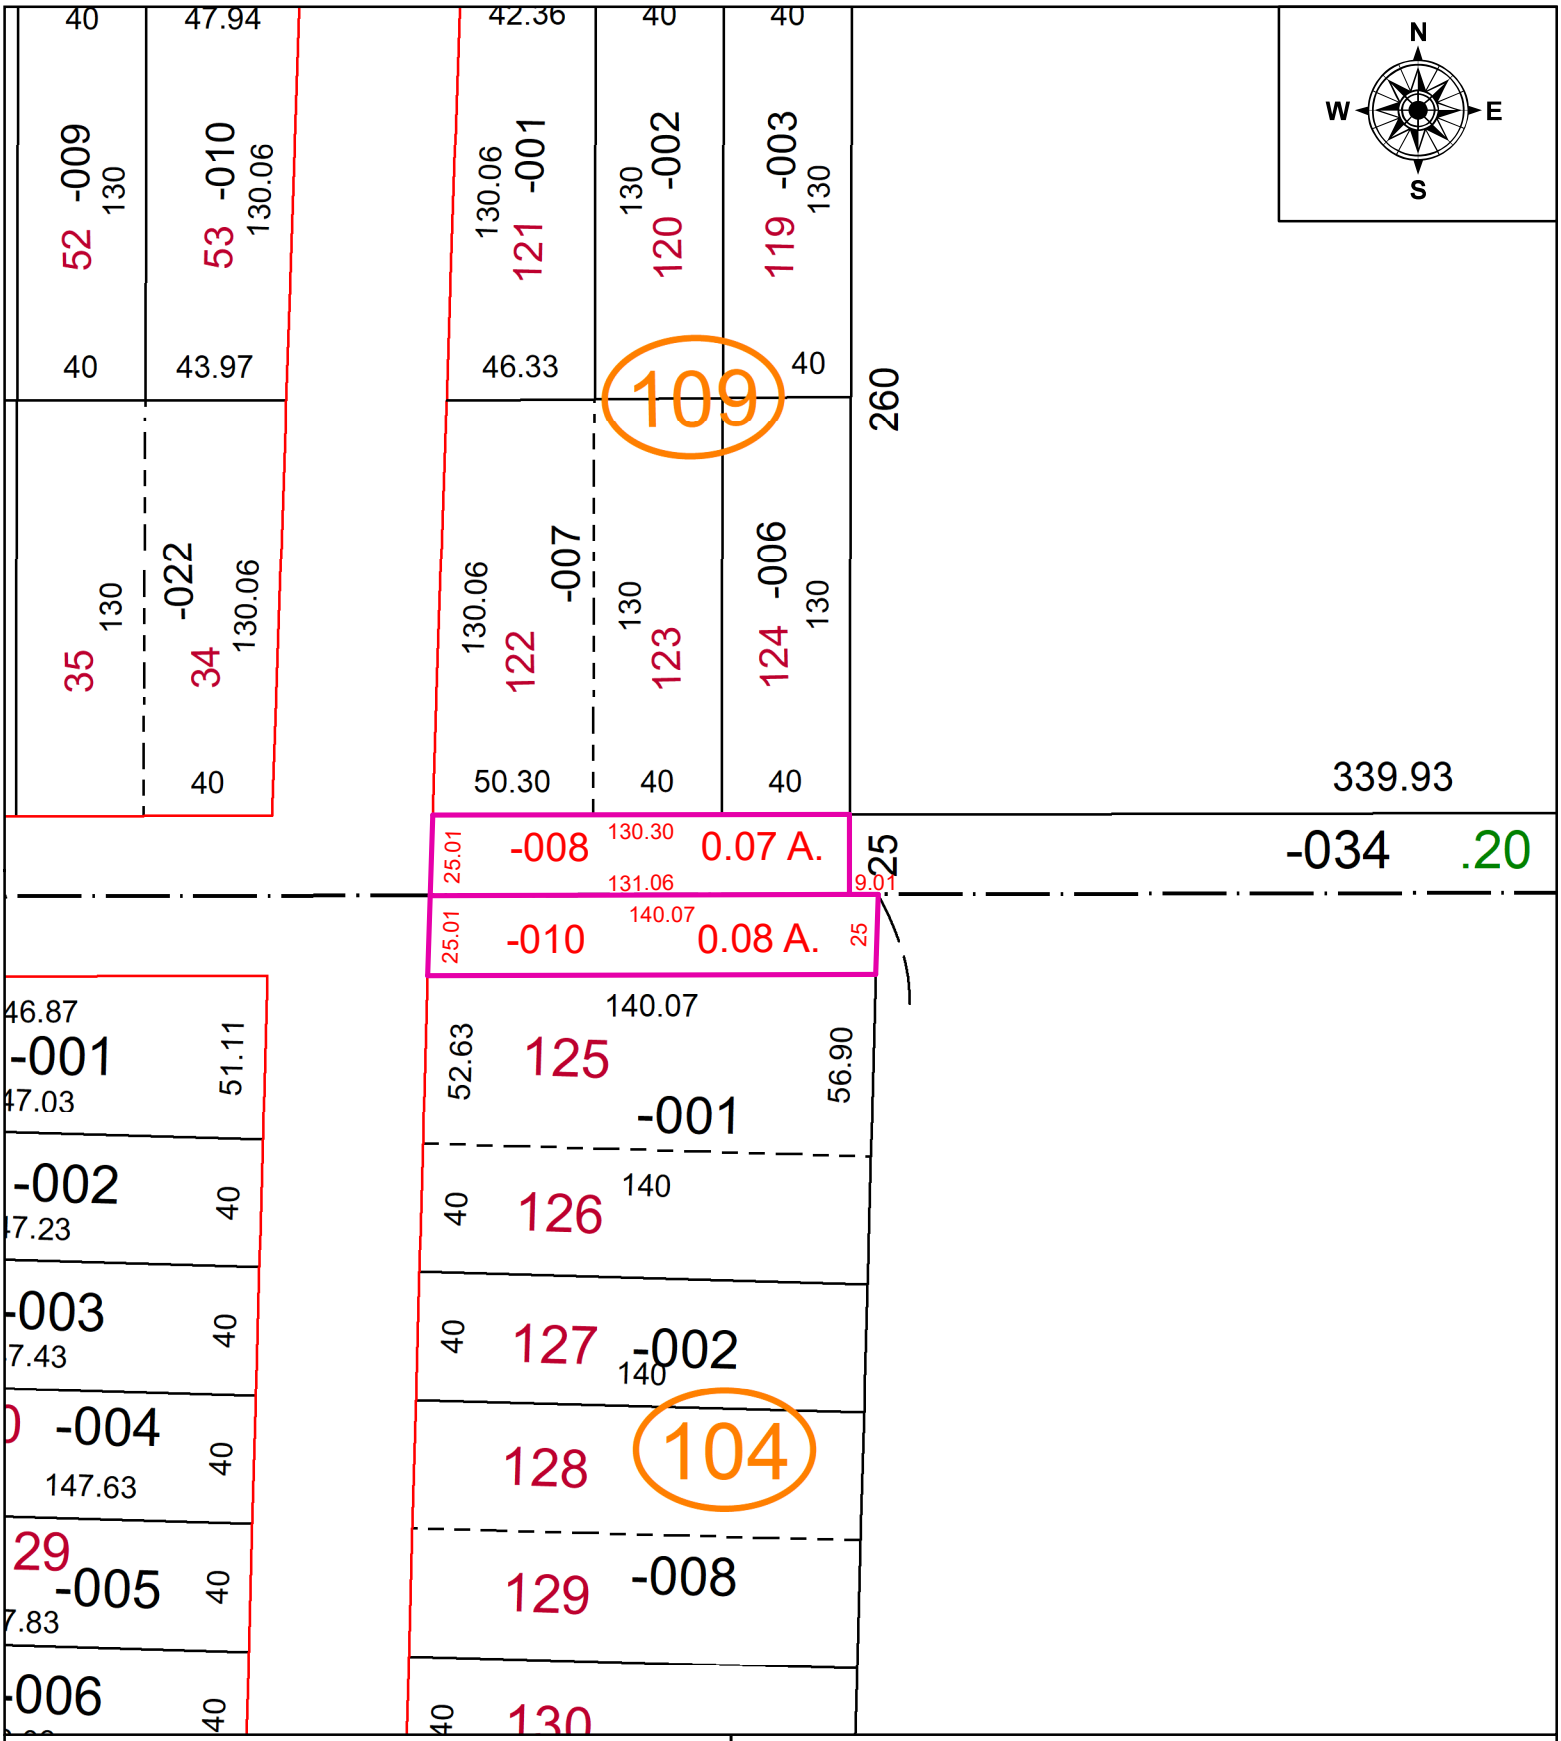

SPLITS/DEEDS PROCESSED

LORAIN COUNTY TAX MAP DEPARTMENT
226 MIDDLE AVE. ELYRIA, OH

SURVEYED BY: W. BARBOSA
CLOSURE: 1: 41,000
MAP PAGE(S): 7-00-045 & -046
APPOVED BY: TJS **DATE:** 10/29/2024
SCALE: 1" = 60' **PRIOR INSTRUMENT:** NA