PARENT PARCEL: 06-26-070-000-006

CHILD PARCEL: AC CORR PER SURVEYOR ROBERT M. RUFFING

STARTING POINT: NORTHEAST CORNER OF SUBLOT 31

24-05393-C

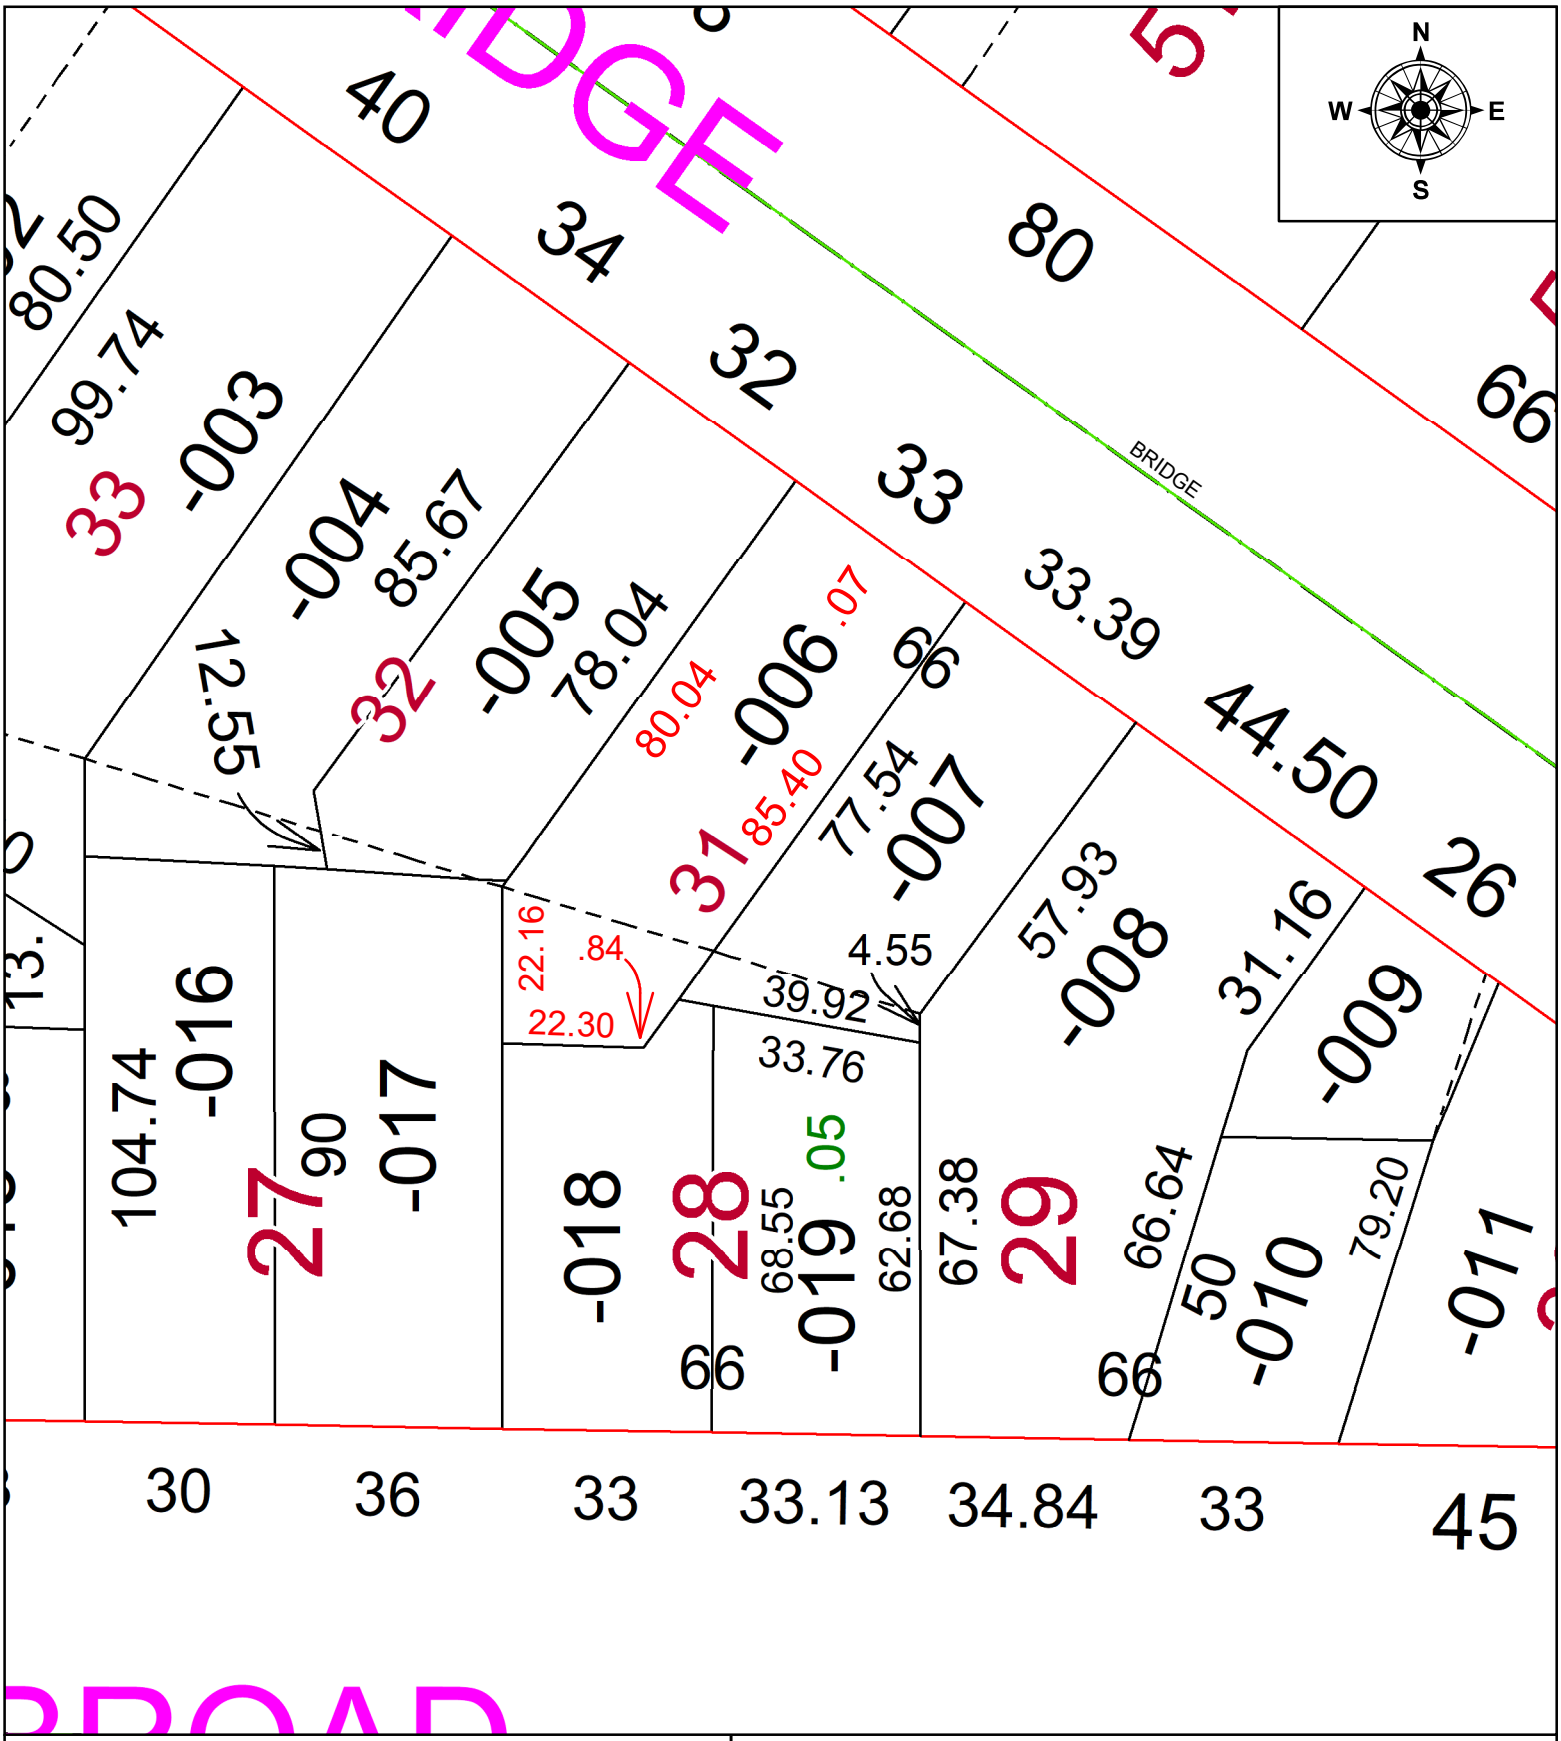

SPLITS/DEEDS PROCESSED

LORAIN COUNTY TAX MAP DEPARTMENT
226 MIDDLE AVE. ELYRIA, OH

SURVEYED BY: ROBBERT M. RUFFING **SURVEY #:** 51312

CLOSURE: I:78897

MAP PAGE(S): 0626070

APPOVED BY: BB **DATE:** 11/1/2024

SCALE: 1" = 130' **PRIOR INSTRUMENT:** #20170650167