**PARENT PARCEL:** 10-00-006-107-004 AC CORR PER SURVEYOR THOMAS SIMON

**CHILD PARCEL:**

**STARTING POINT:** INTERSECTION OF C/LS OF HAINES ST & DEWHURST RD

# 24-05409-C

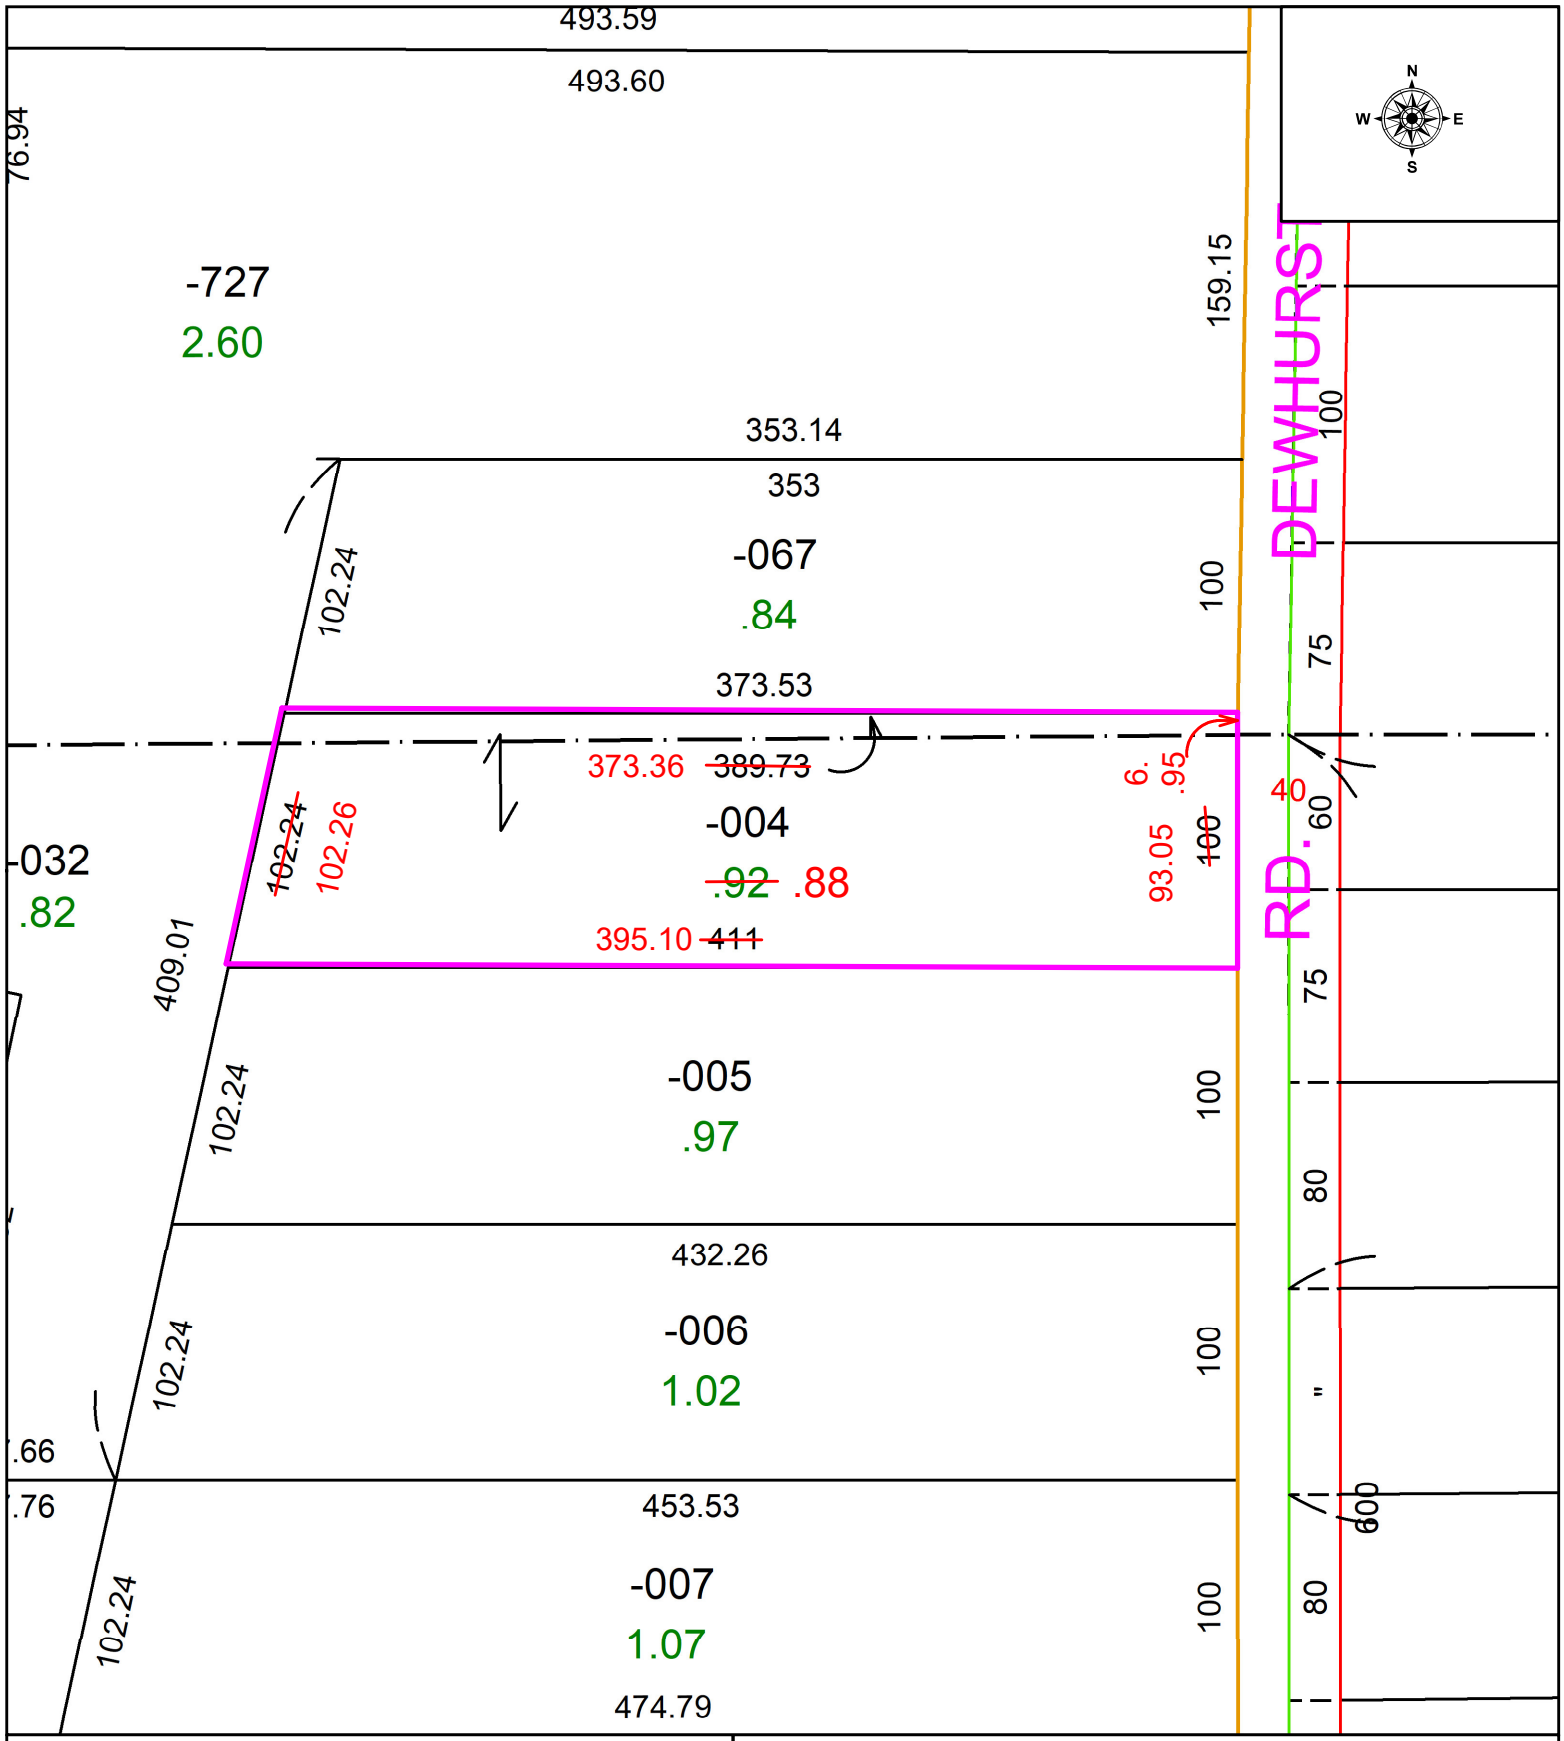


**SPLITS/DEEDS PROCESSED**

LORAIN COUNTY TAX MAP DEPARTMENT
226 MIDDLE AVE. ELYRIA, OH

**SURVEYED BY:** THOMAS SIMON SURVEY # 51334
**CLOSURE:** 1: 213490
**MAP PAGE(S):** 10-00-006
**APPOVED BY:** WRZ **DATE:** 12/2/2024
**SCALE:** 1" = 75 **PRIOR INSTRUMENT:** #2023-0927134