PARENT PARCEL: 04-00-006-103-012

CHILD PARCEL: 04-00-006-103-023 & -024

STARTING POINT: C/L OF LAKE ROAD AND MOORE ROAD

24-05415-U

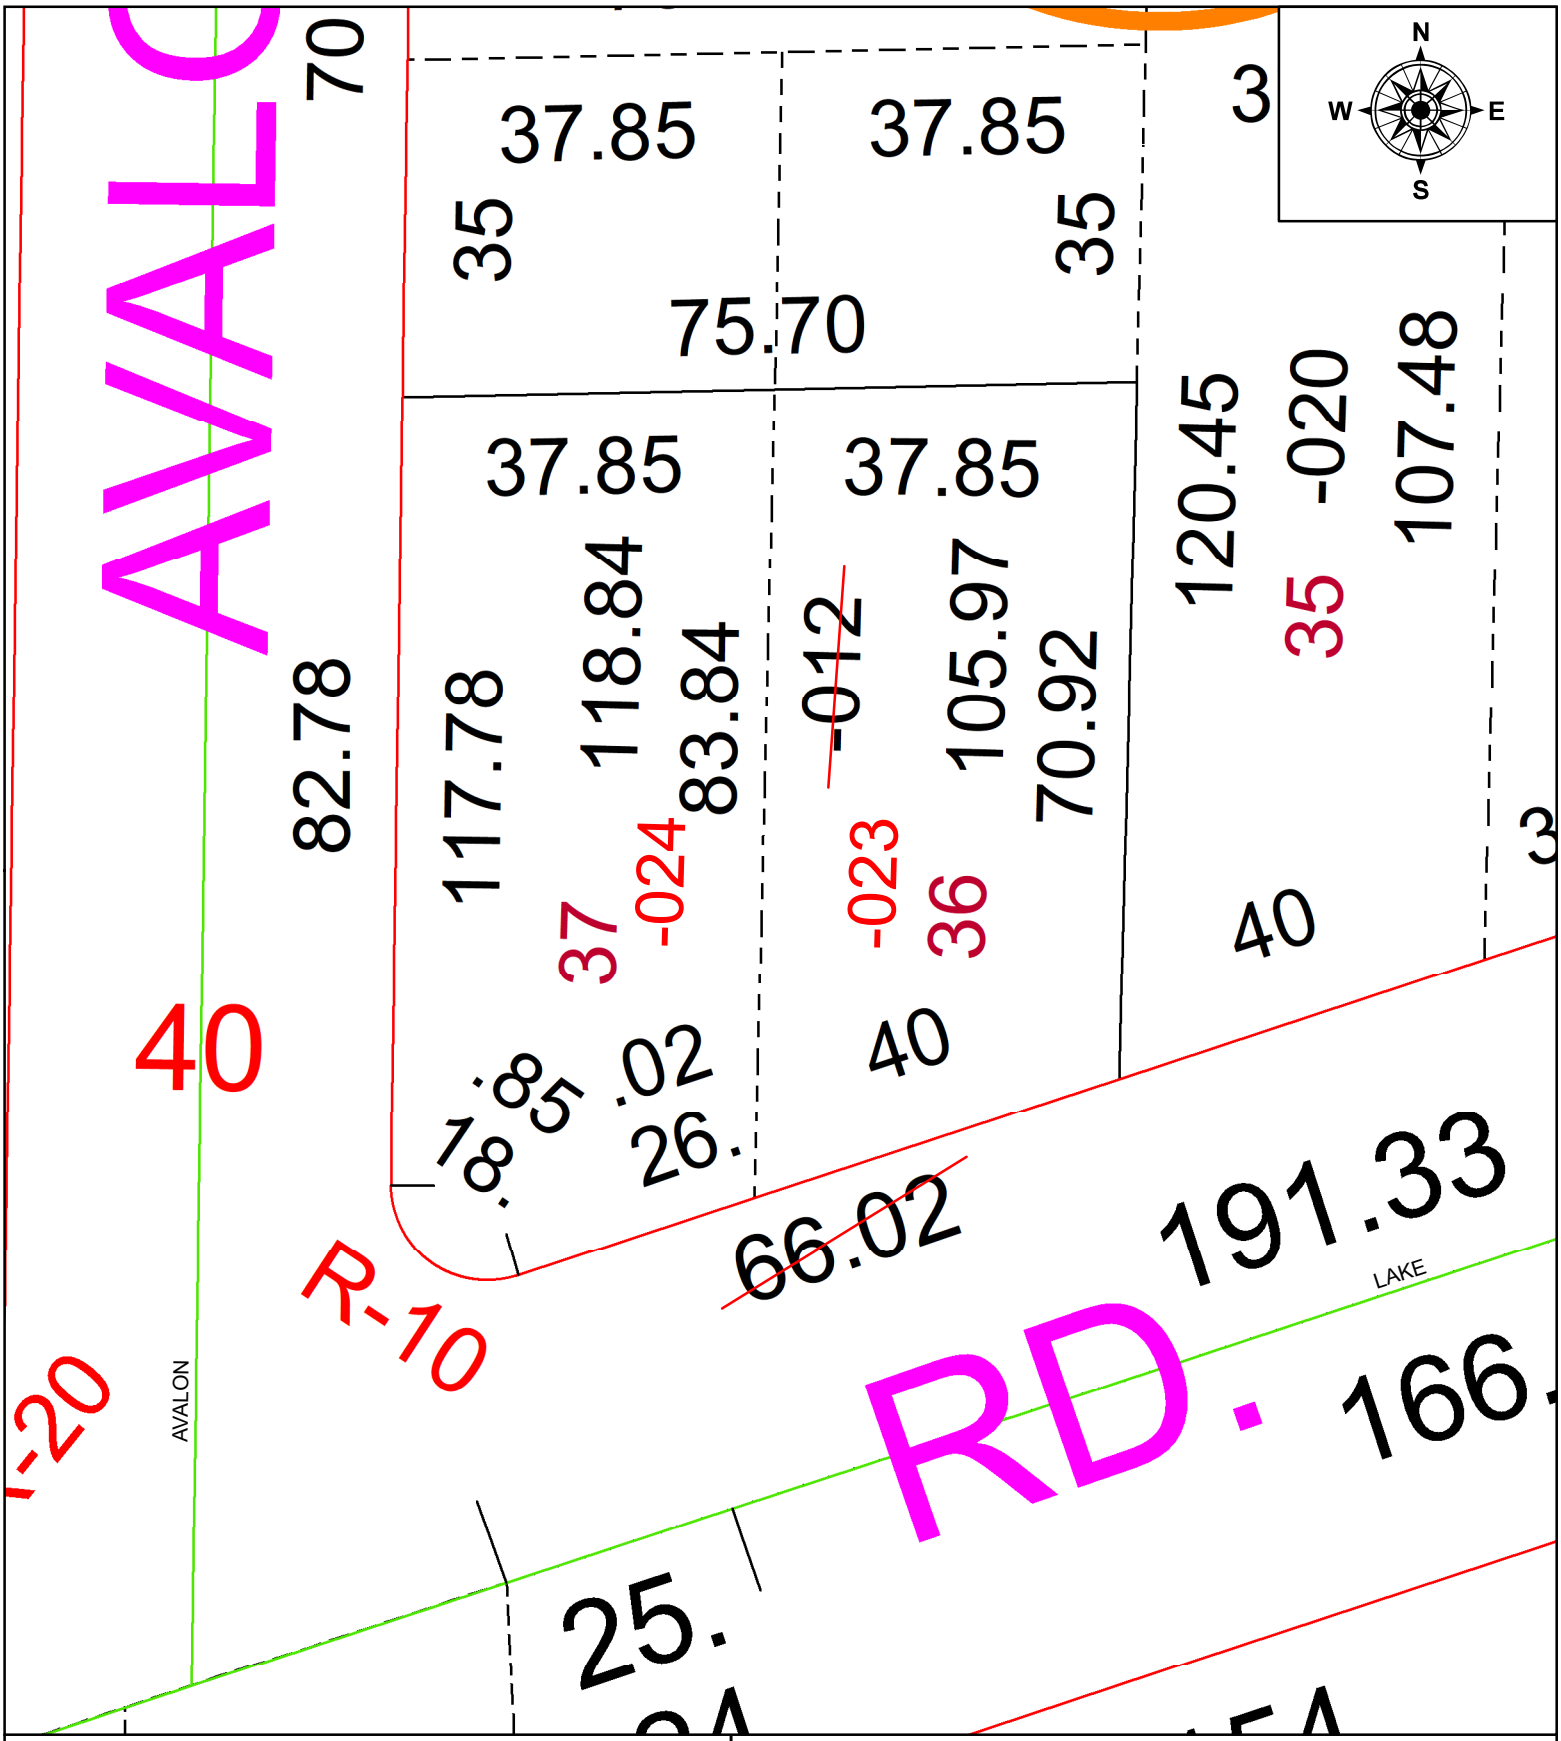

SPLITS/DEEDS PROCESSED

LORAIN COUNTY TAX MAP DEPARTMENT
226 MIDDLE AVE. ELYRIA, OH

SURVEYED BY: W.E HOLLAND ENGINEERING CO **SURVEY #:** N/A
CLOSURE: N/A
MAP PAGE(S): 04-00-006
APPOVED BY: BB **DATE:** 12/4/2024
SCALE: 1" = 20' **PRIOR INSTRUMENT:** #20000706156