PARENT PARCEL: 03-00-073-000-038 & 03-00-074-101-002(S.T.)

CHILD PARCEL: 03-00-073-000-082, -083 & 03-00-074-101-002(S.T.)

STARTING POINT: INTERSECTION OF C/L EAST RIVER RD & SOUTHERLY ROW OF THE L & WV RR

24-05423-U

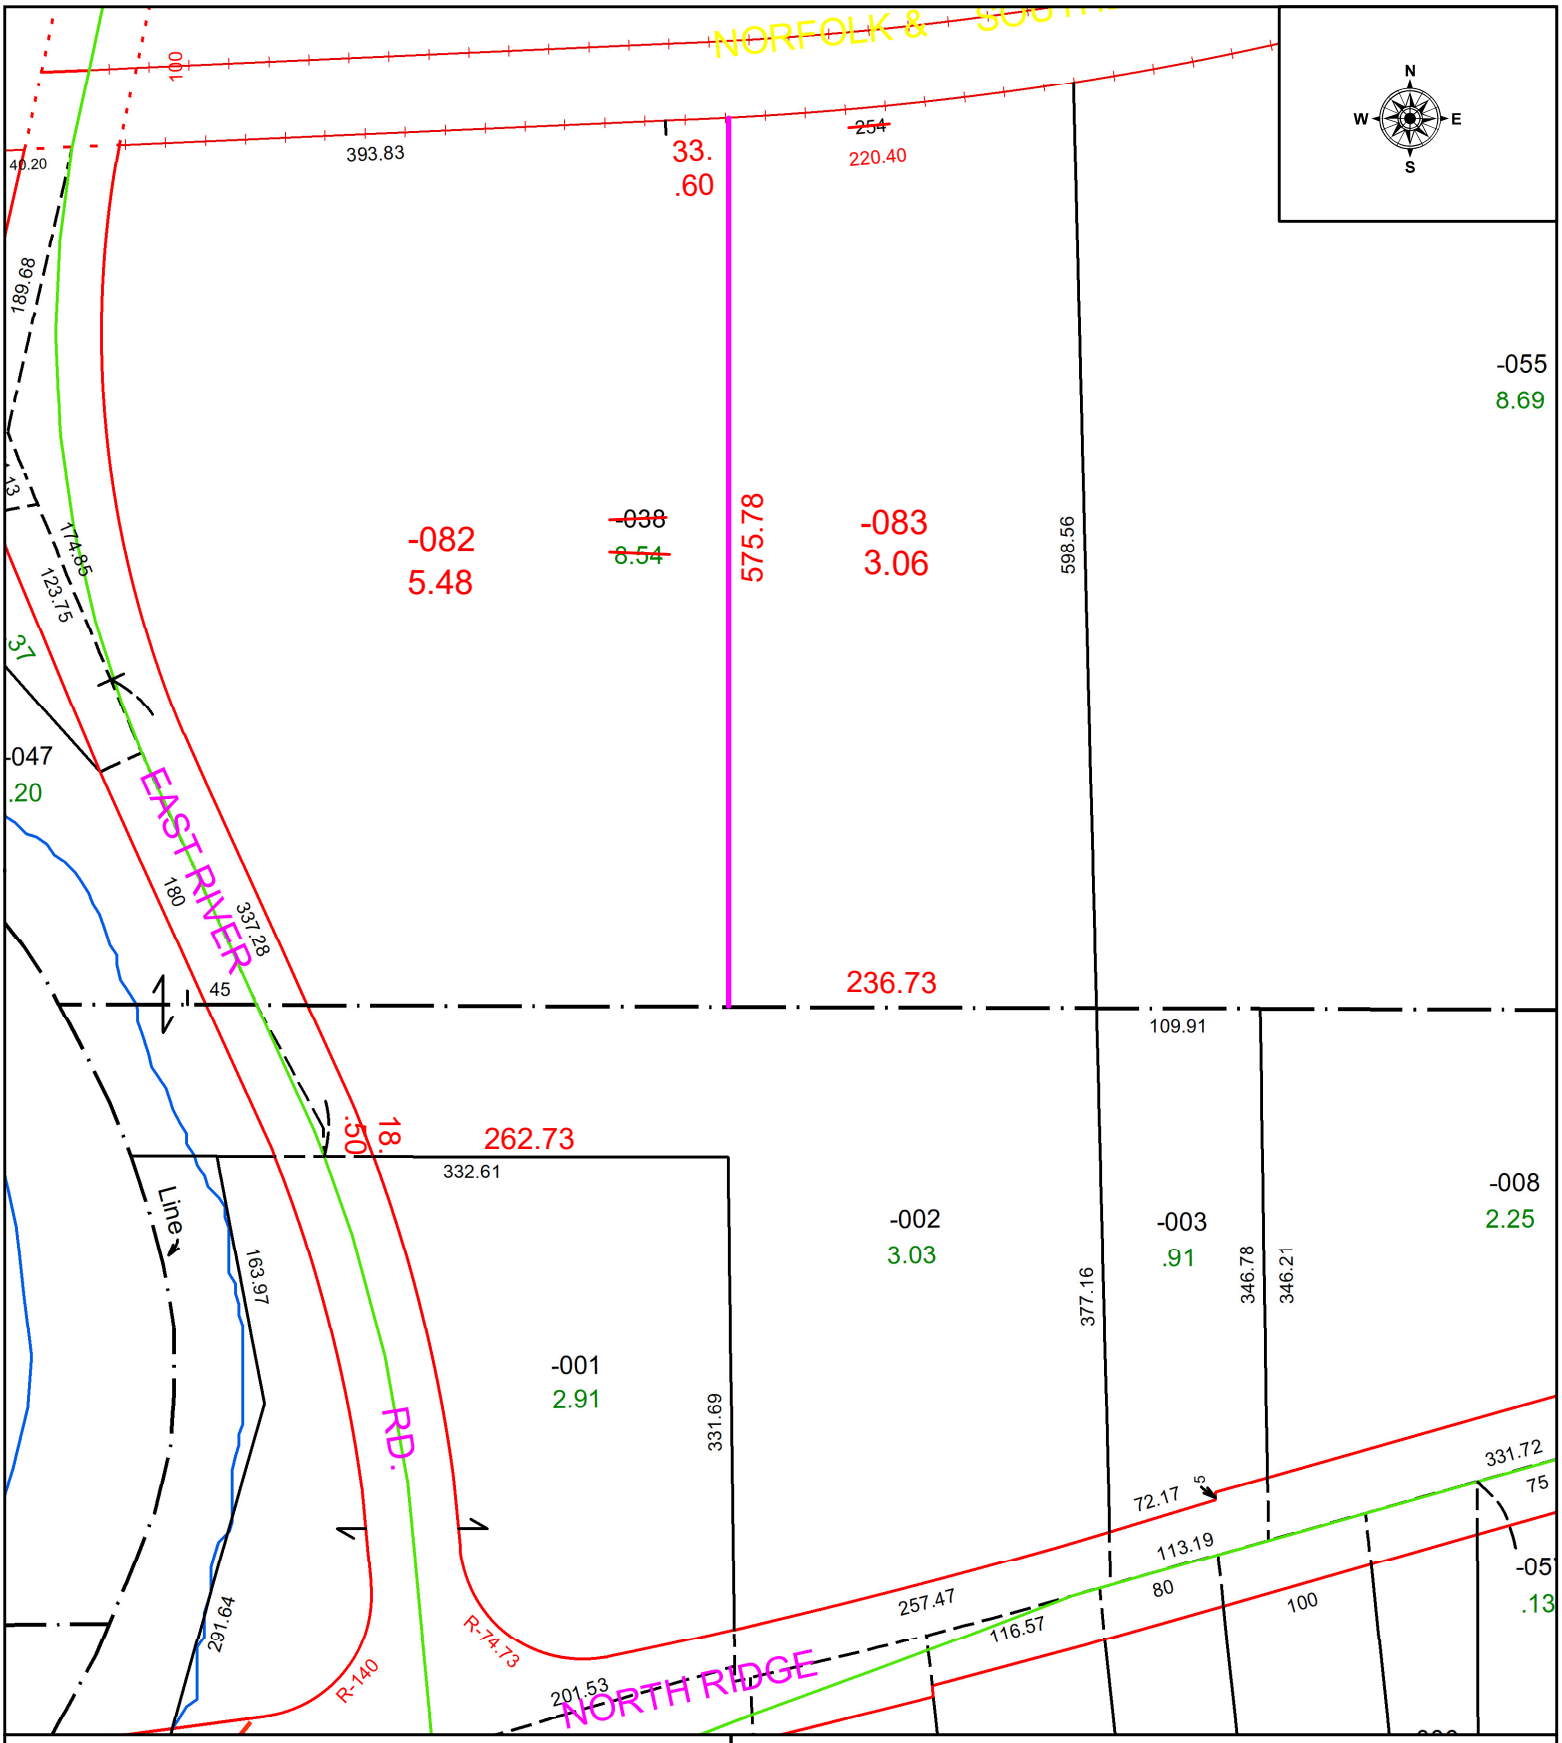

SPLITS/DEEDS PROCESSED

LORAIN COUNTY TAX MAP DEPARTMENT
226 MIDDLE AVE. ELYRIA, OH

SURVEYED BY: WARDEN & LAUDON SURVEY # N/A

CLOSURE: 1: 4115

MAP PAGE(S): 03-00-073 & 03-00-074

APPOVED BY: WRZ **DATE:** 12/18/2024

SCALE: 1" = 125 **PRIOR INSTRUMENT:** #2021-0844725