PARENT PARCEL: 06-25-020-101-002 & -003

CHILD PARCEL: 06-25-020-101-009

STARTING POINT: FRONT & DEPTH TO AC CORR PER SURV BY THOMAS A. SIMON

24-05428-D

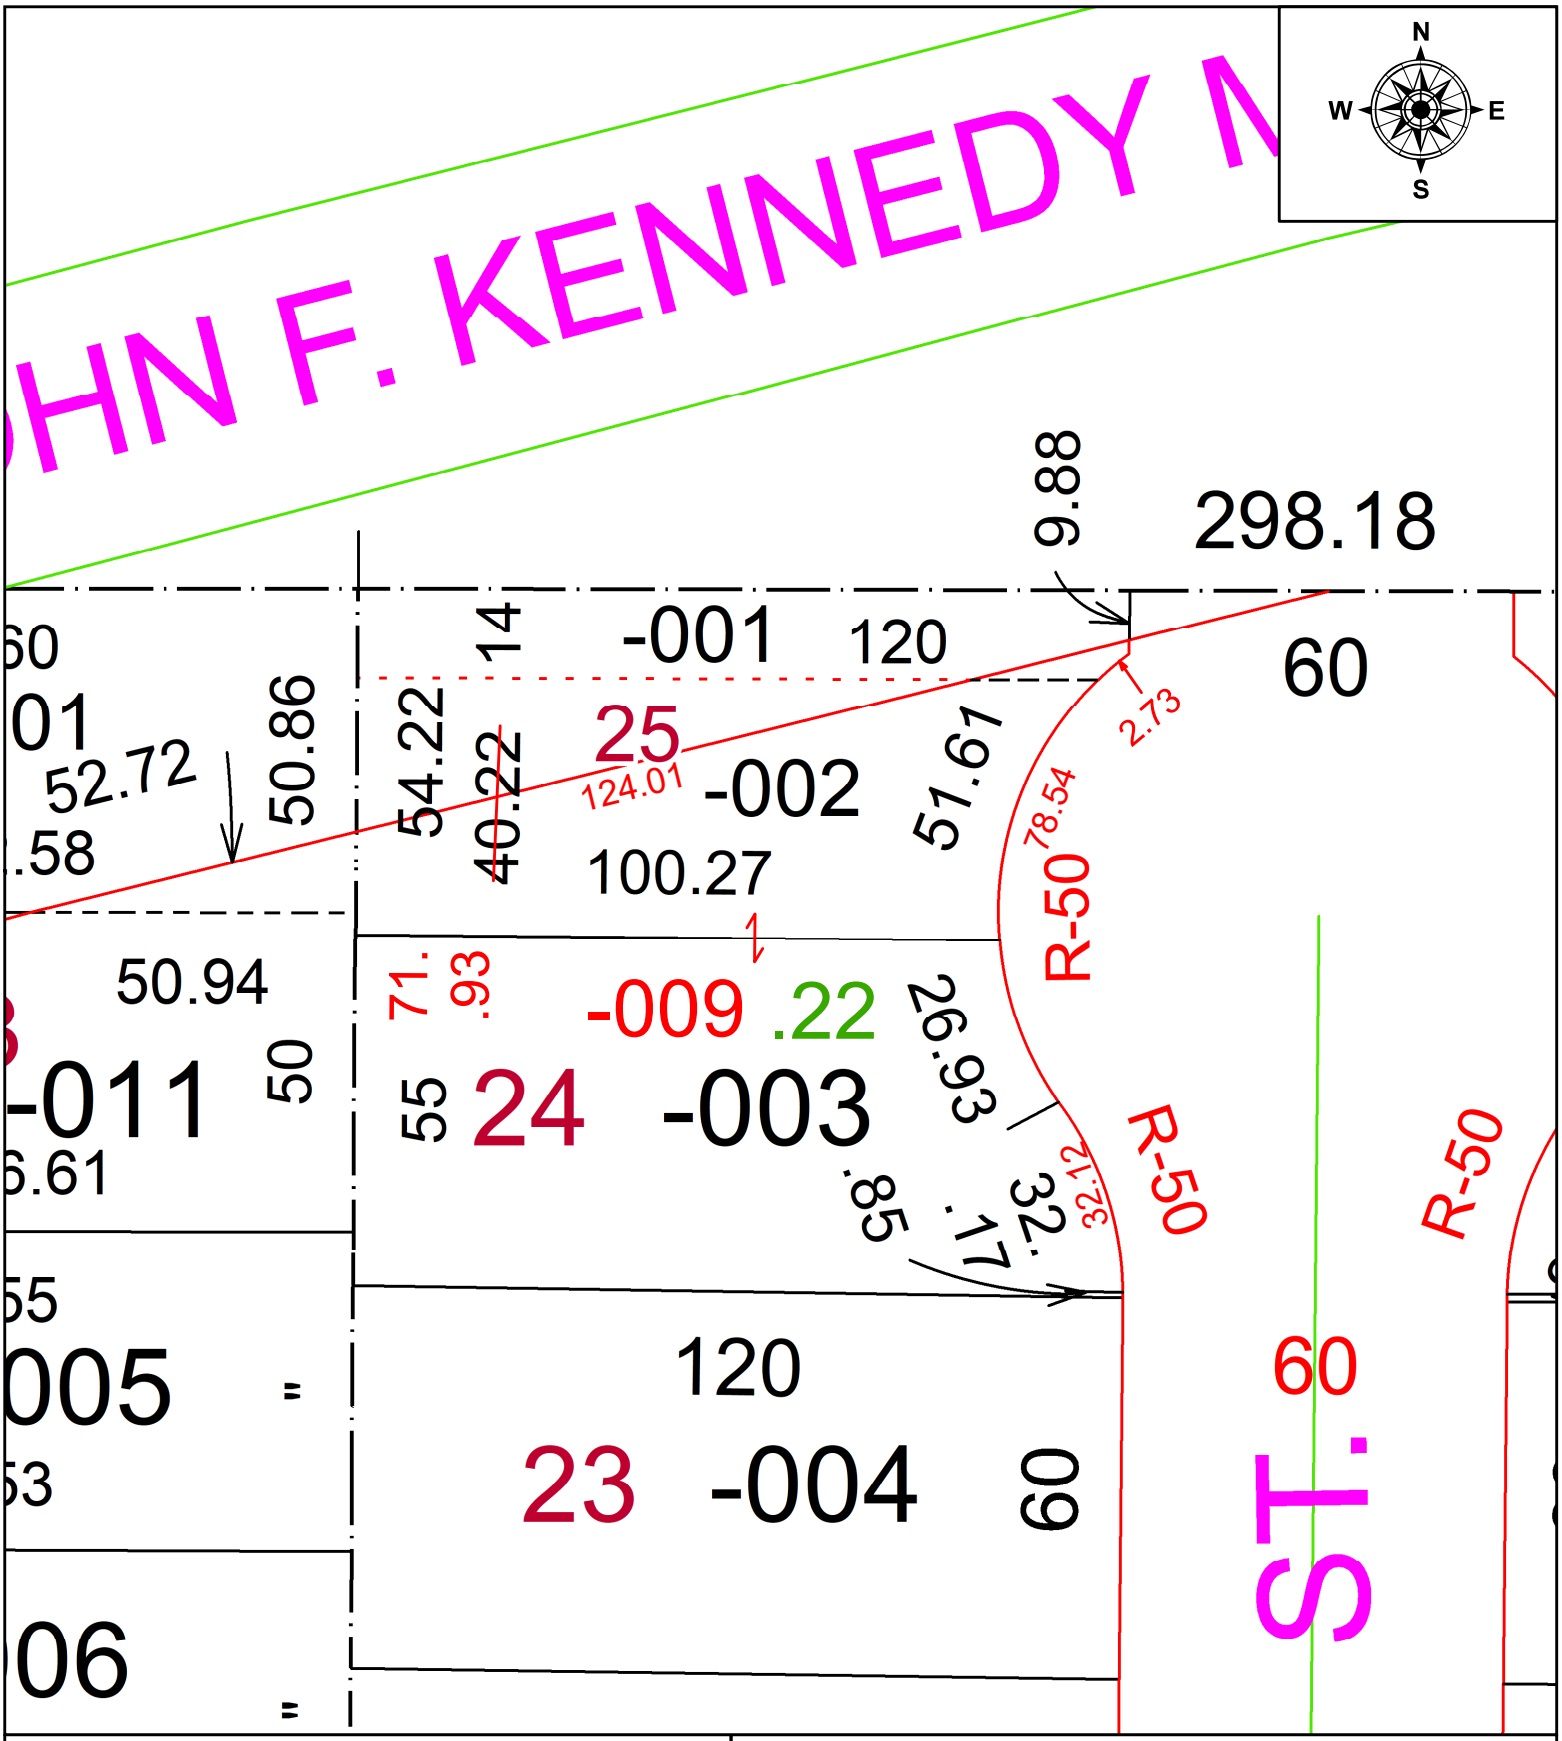

SPLITS/DEEDS PROCESSED

LORAIN COUNTY TAX MAP DEPARTMENT
226 MIDDLE AVE. ELYRIA, OH

SURVEYED BY: THOMAS A. SIMON **SURV # 51351**

CLOSURE: 1: 63591

MAP PAGE(S): 06-25

APPOVED BY: AC **DATE:** December 26, 2024

SCALE: 1 in = 30 ft **PRIOR INSTRUMENT:** 2016- 0581685