PARENT PARCEL: 10-00-004-124-023 & -033

CHILD PARCEL: MAP CORRECTION ONLY

STARTING POINT: W LINE OF S/L 48 AND S LINE OF OAKWOOD ST

24-05431-C

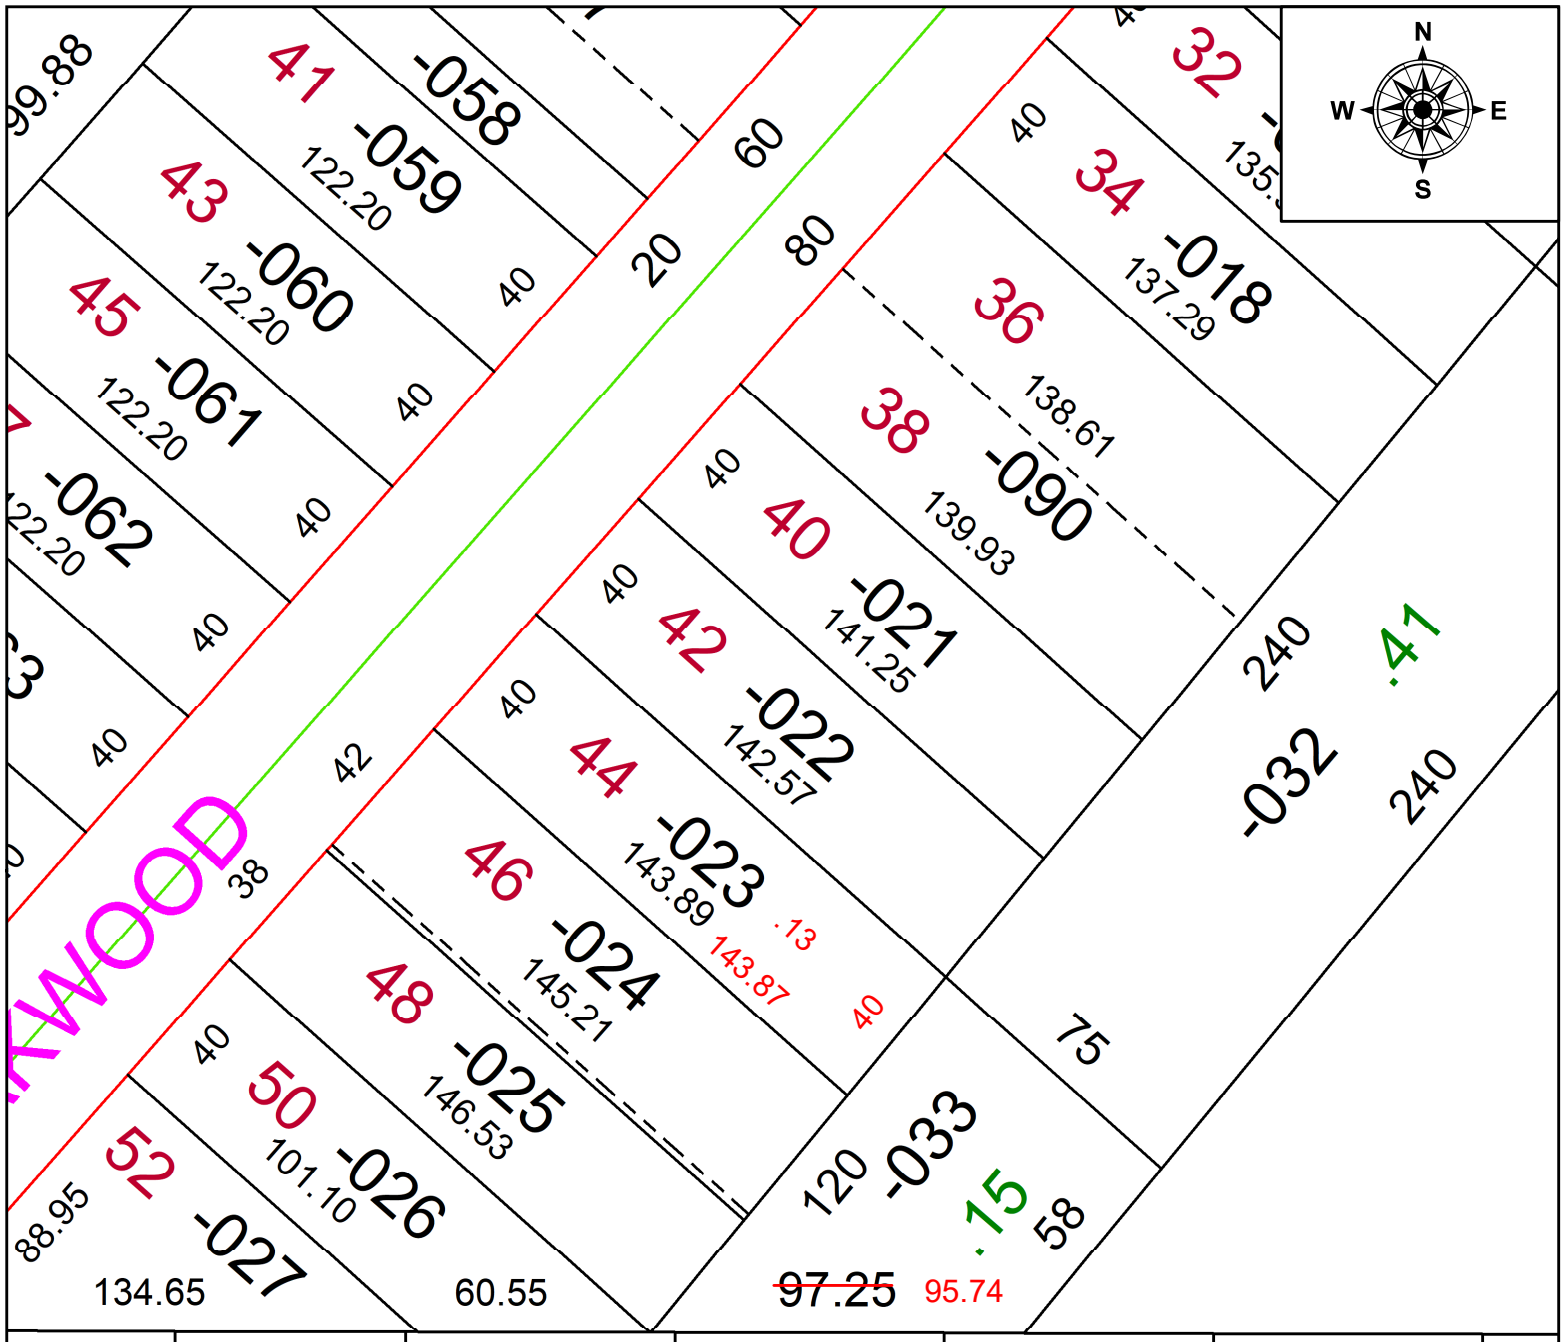

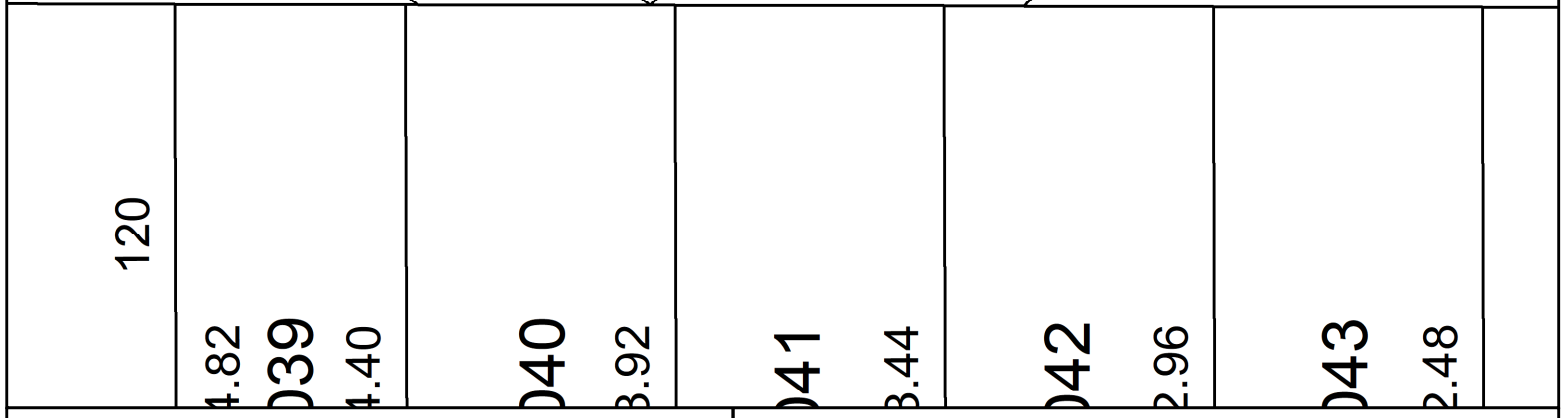

SPLITS/DEEDS PROCESSED

LORAIN COUNTY TAX MAP DEPARTMENT
226 MIDDLE AVE. ELYRIA, OH

SURVEYED BY: ROBERT M. RUFFING **SURV # 51351**

CLOSURE: 1: 100789

MAP PAGE(S): 10-00-004

APPOVED BY: AC **DATE:** December 27, 2024

SCALE: 1 in = 50 ft **PRIOR INSTRUMENT:** 2022- 0895091