PARENT PARCEL: 03-00-061-106-041

CHILD PARCEL: AC CORR PER PRIOR DEED #2020-0765749

STARTING POINT: INTERSECTION OF C/LS OF SR 611 & LAKE BREESE RD

25-05437-C

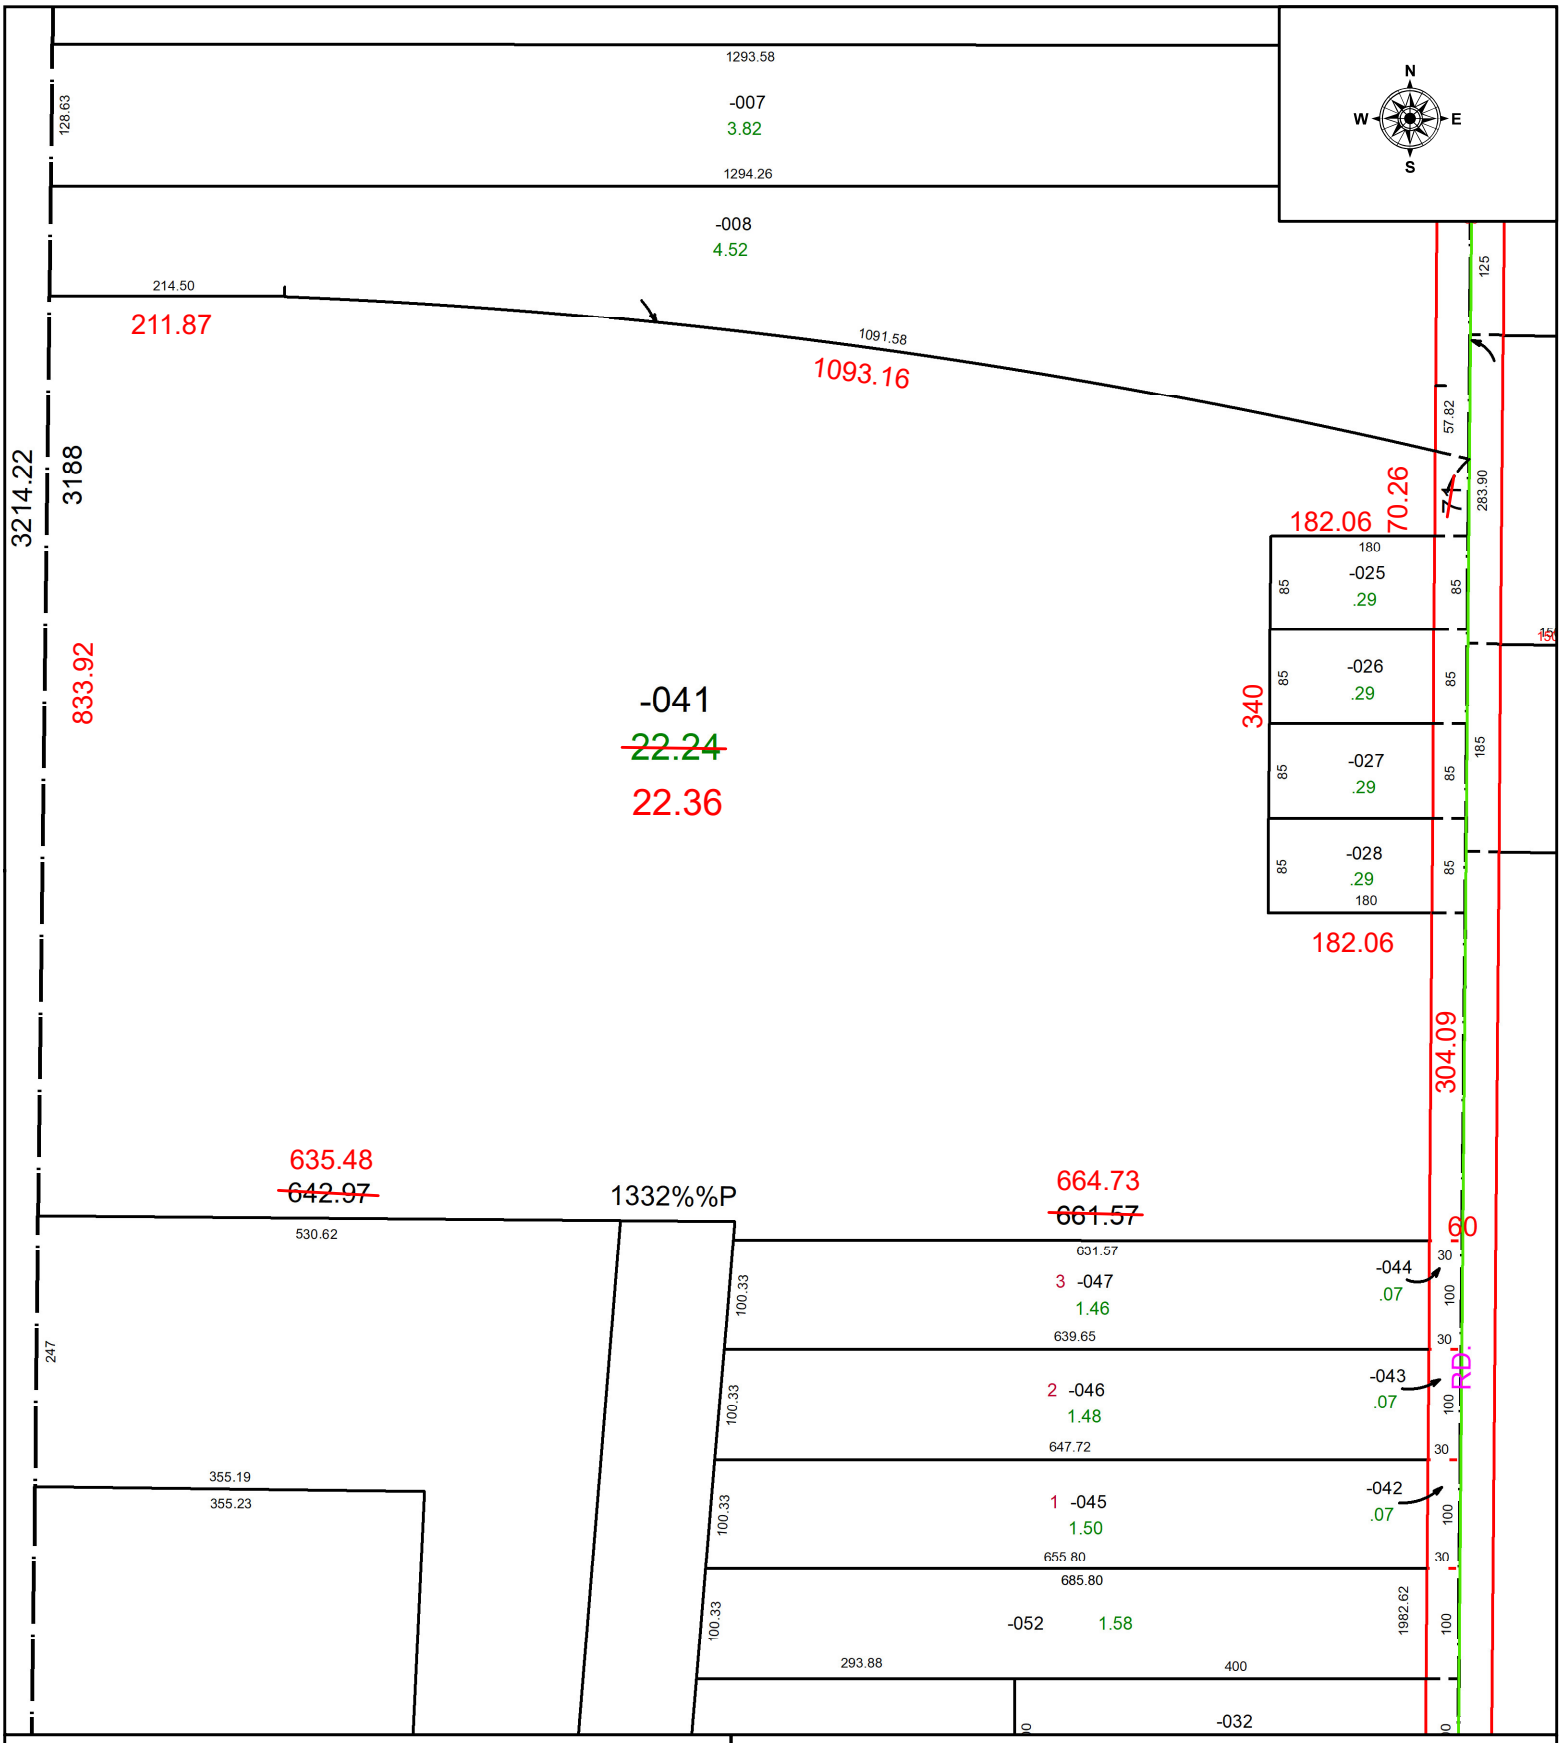

SPLITS/DEEDS PROCESSED

LORAIN COUNTY TAX MAP DEPARTMENT
226 MIDDLE AVE. ELYRIA, OH

SURVEYED BY: THOMAS SIMON SURVEY # 48817

CLOSURE: 1: 995677

MAP PAGE(S): 03-00-061

APPOVED BY: WRZ **DATE:** 1/7/2025

SCALE: 1" = 175 **PRIOR INSTRUMENT:** #2020-0765749