PARENT PARCEL: 10-00-004-139-002

CHILD PARCEL: AC CORR PER SURV BY THOMAS A. SIMON

STARTING POINT: SE CORNER OF S/L 27 IN CARL J. SMITH ADDITION

25-05446-C

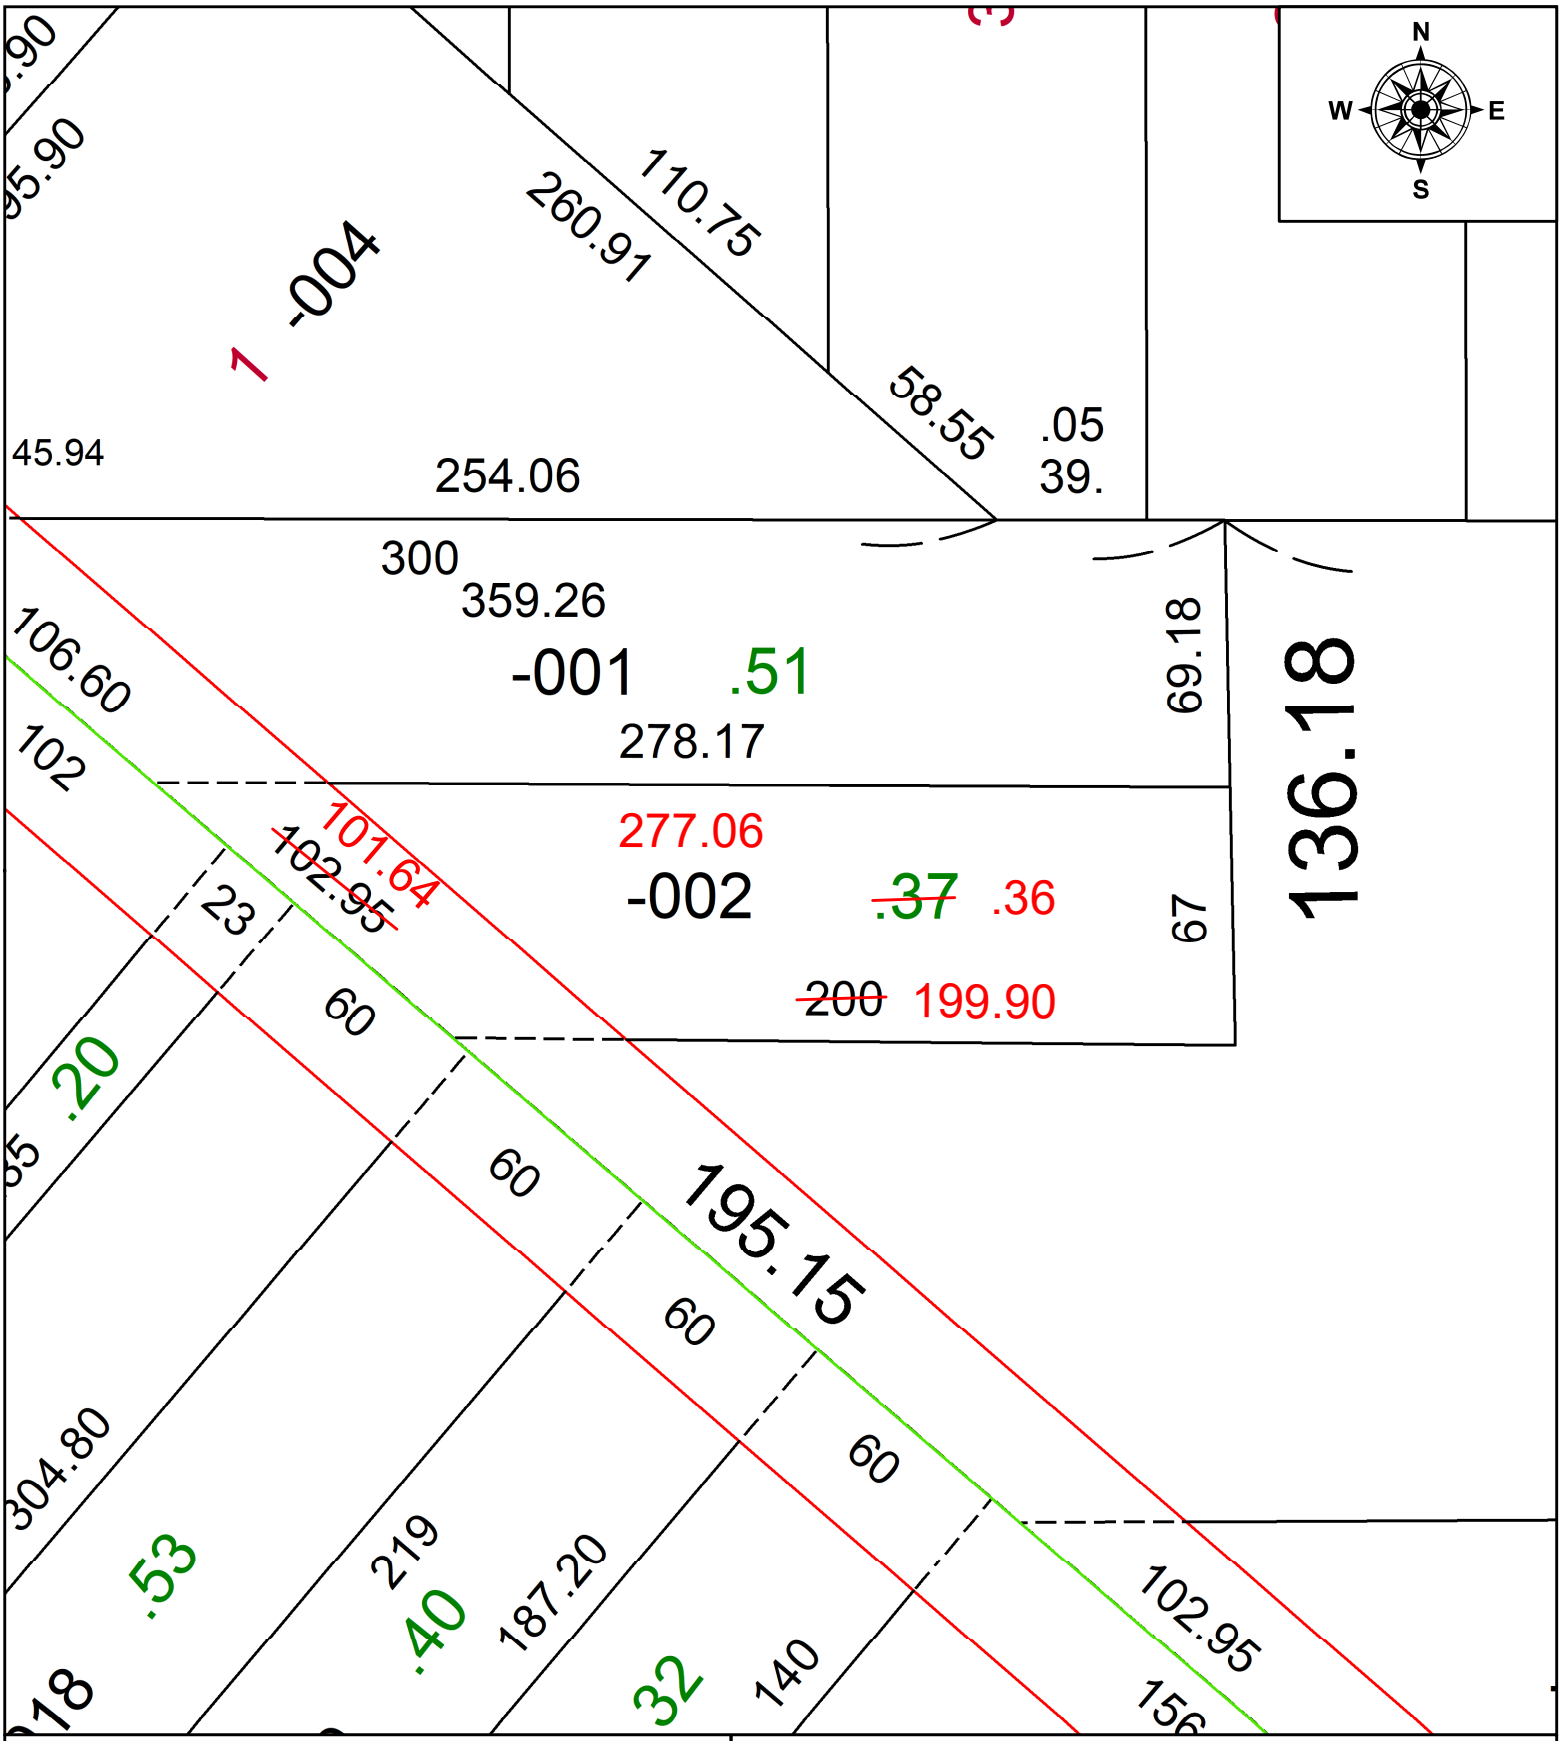

SPLITS/DEEDS PROCESSED

LORAIN COUNTY TAX MAP DEPARTMENT
226 MIDDLE AVE. ELYRIA, OH

SURVEYED BY: THOMAS A. SIMON **SURV # 51378**

CLOSURE: 1: 731624

MAP PAGE(S): 10-00-004

APPOVED BY: AC **DATE:** January 27, 2025

SCALE: 1 in = 50 ft **PRIOR INSTRUMENT:** 2001- 0798558