PARENT PARCEL: 04-00-010-116-033 & -034

CHILD PARCEL: AC CORR PER SURV BY SEAN A. BOLAND

STARTING POINT: C/L OF DETROIT AND STONEY RIDGE RD

25-05447-C

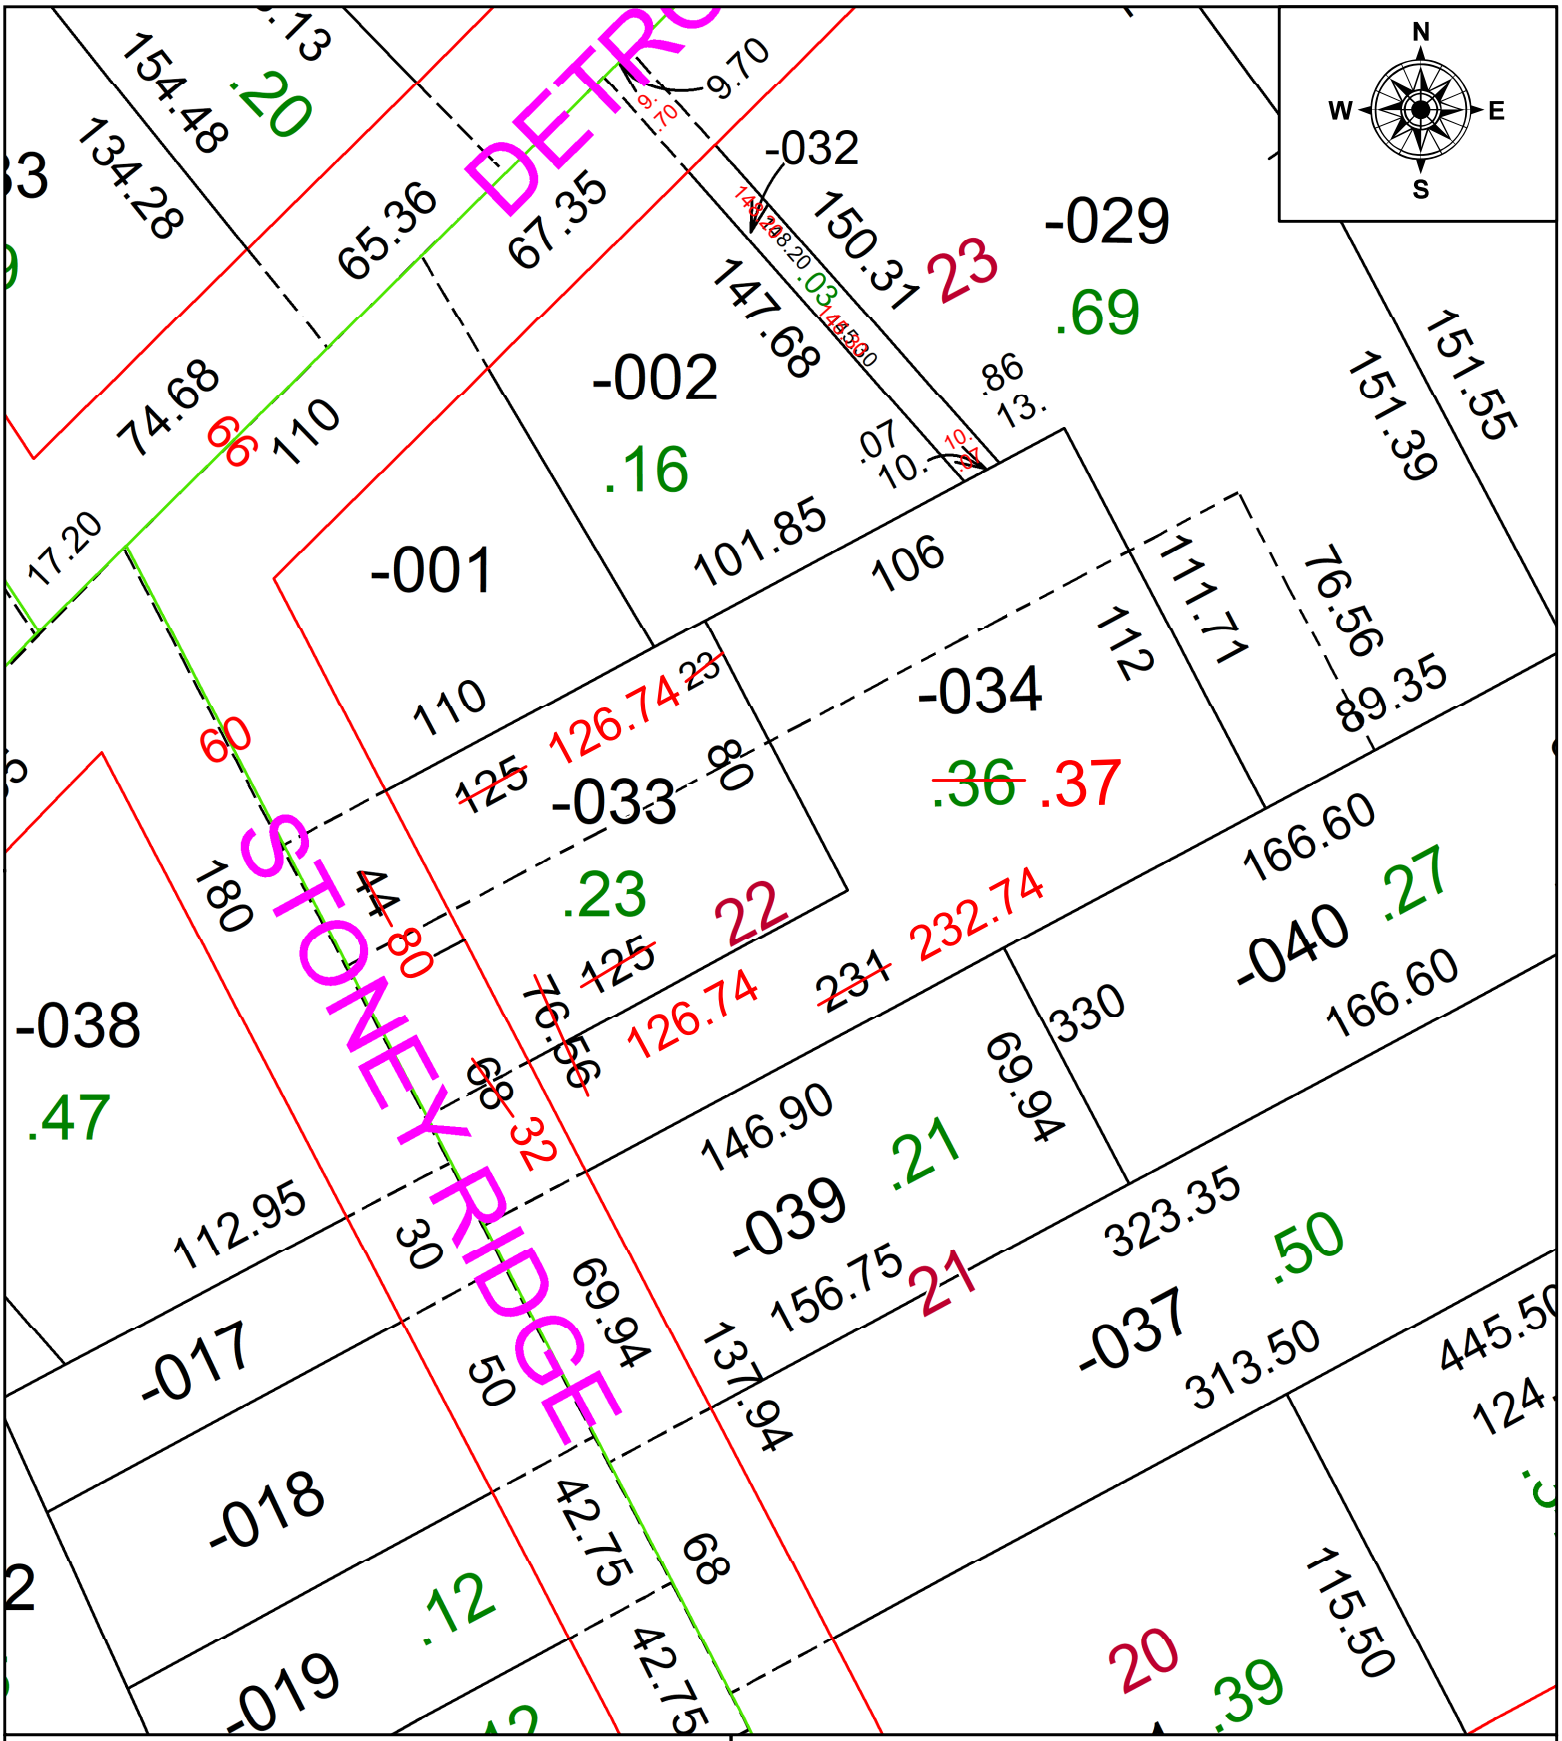

SPLITS/DEEDS PROCESSED

LORAIN COUNTY TAX MAP DEPARTMENT
226 MIDDLE AVE. ELYRIA, OH

SURVEYED BY: SEAN A. BOLAND **SURV # 51379**

CLOSURE: 1: INF

MAP PAGE(S): 04-00-010

APPOVED BY: AC **DATE:** January 27, 2025

SCALE: 1 in = 50 ft **PRIOR INSTRUMENT:** 2019- 0730548