PARENT PARCEL: 10-00-025-102-009 & -010

CHILD PARCEL: AC CORR PER SURV BY ROBERT M. RUFFING

STARTING POINT: C/L OF WHITEHEAD AND SR 303

25-05464-C

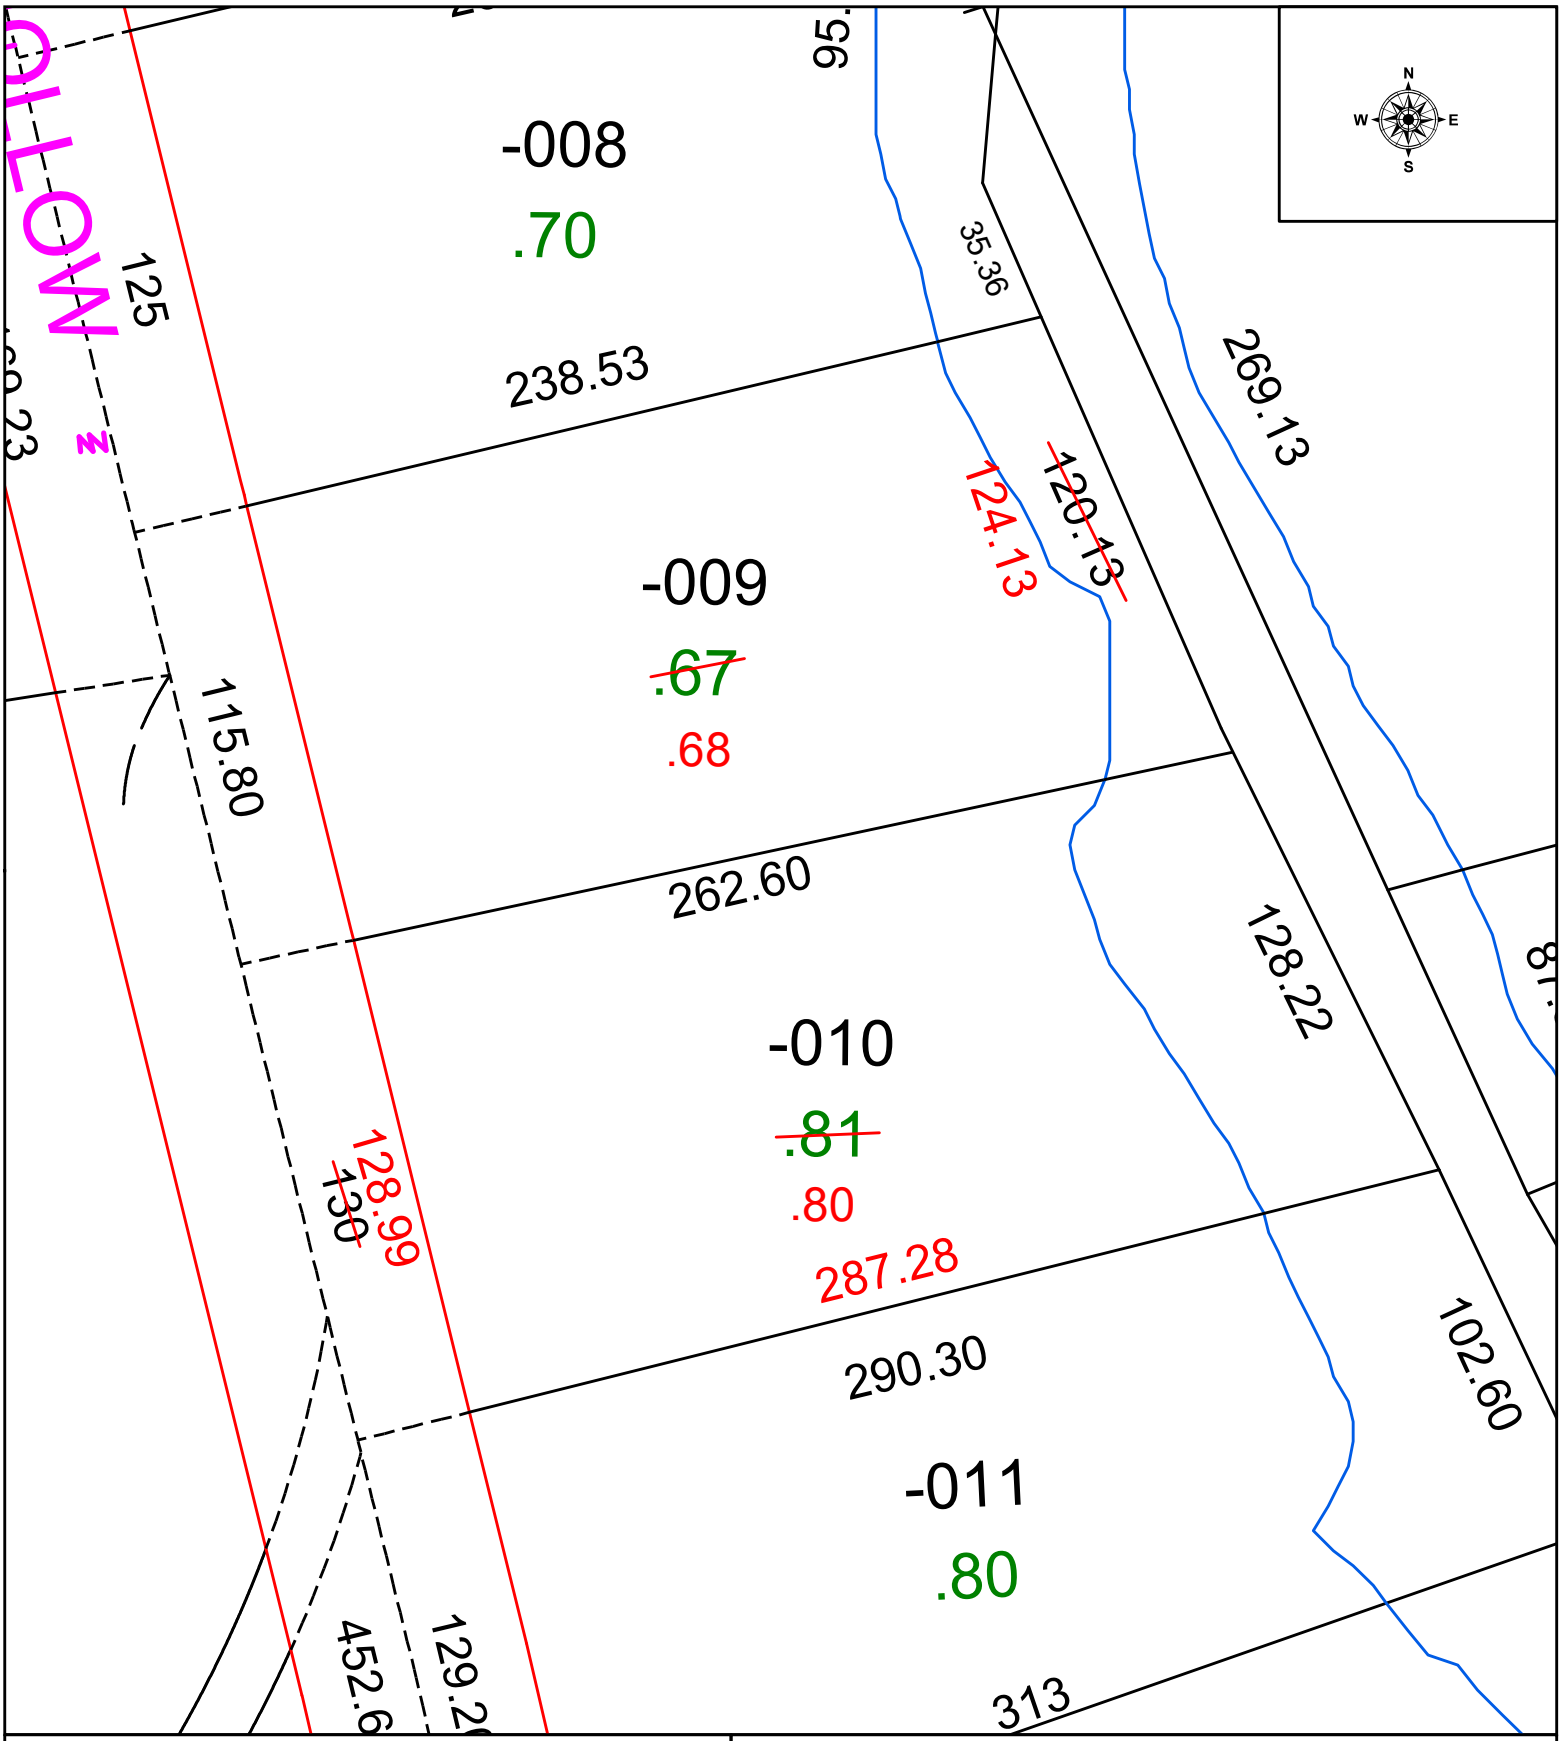

SPLITS/DEEDS PROCESSED

LORAIN COUNTY TAX MAP DEPARTMENT
226 MIDDLE AVE. ELYRIA, OH

SURVEYED BY: ROBERT M. RUFFING SURVEY # 51403

CLOSURE: 1: 47082

MAP PAGE(S): 10-00-025

APPOVED BY: WRZ **DATE:** 3/5/2025

SCALE: 1" = 50 **PRIOR INSTRUMENT:** 2019-0727378