PARENT PARCEL: 12-00-058-000-045

CHILD PARCEL: AC CORR PER SURV BY JOHN A. DCHANT JR.

STARTING POINT: C/L OF OSBORNE AND JAQUAY RD

25-05465-C

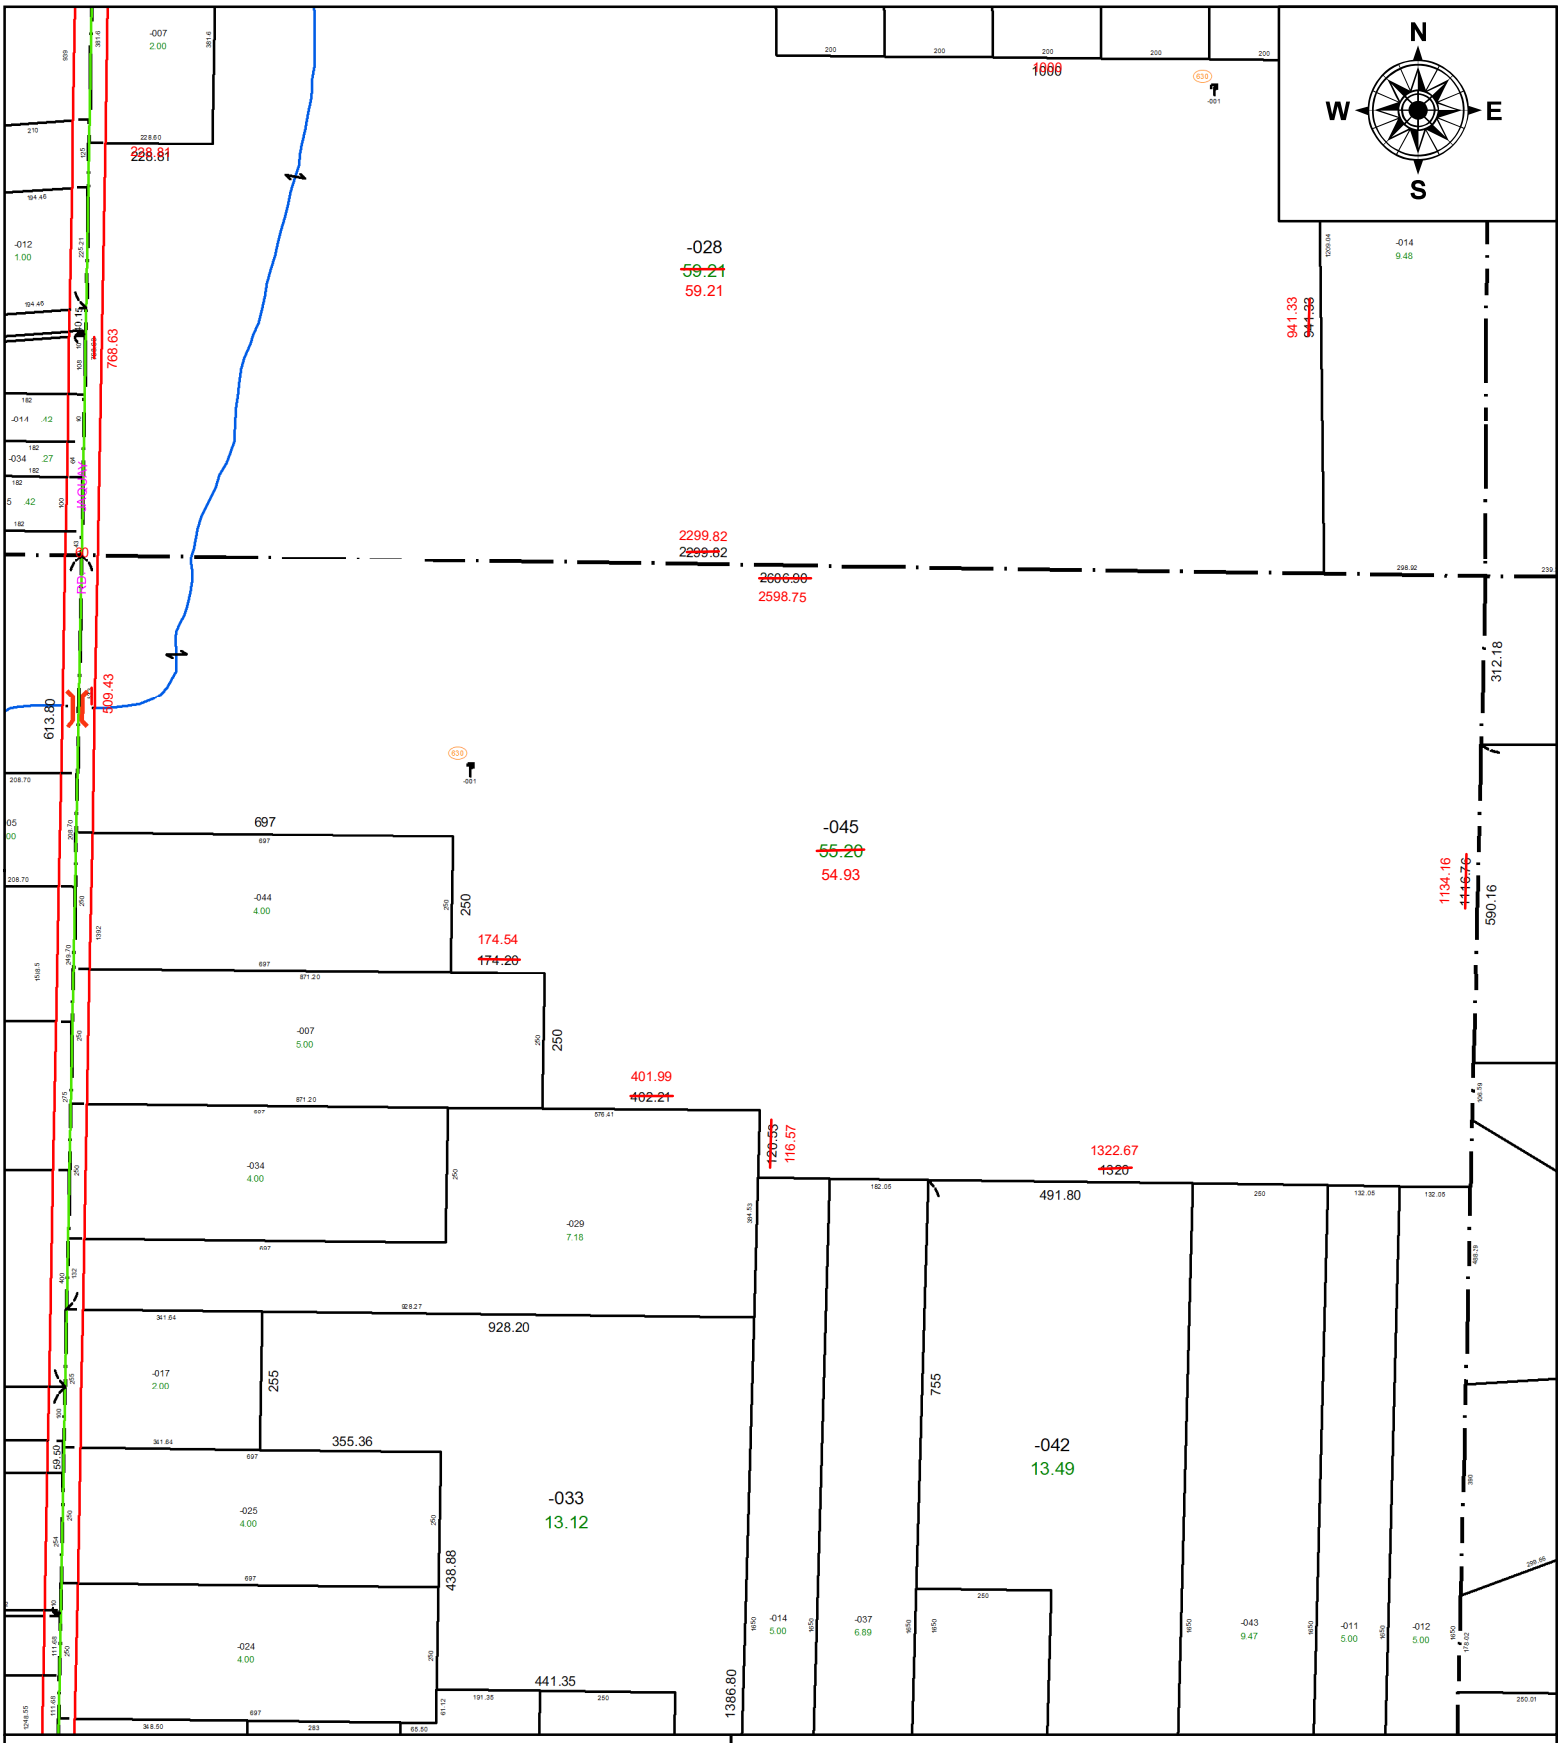

SPLITS/DEEDS PROCESSED

LORAIN COUNTY TAX MAP DEPARTMENT
226 MIDDLE AVE. ELYRIA, OH

SURVEYED BY: JOHN A. DECHANT JR. **SURV # 51406**

CLOSURE: 1: 715351

MAP PAGE(S): 12-00-058

APPOVED BY: AC **DATE:** March 07, 2025

SCALE: 1 in = 355 ft **PRIOR INSTRUMENT:** 2021- 0836911