**PARENT PARCEL:** 04-00-024-105-170

**CHILD PARCEL:** AC CORR PER SURV BY TIMOTHY D. HOZALSKI

**STARTING POINT:** C/L OF MAPLERIDGE BLVD AND W LINE OF MAPLERIDGE SUBDIVISION

# 25-05467-C

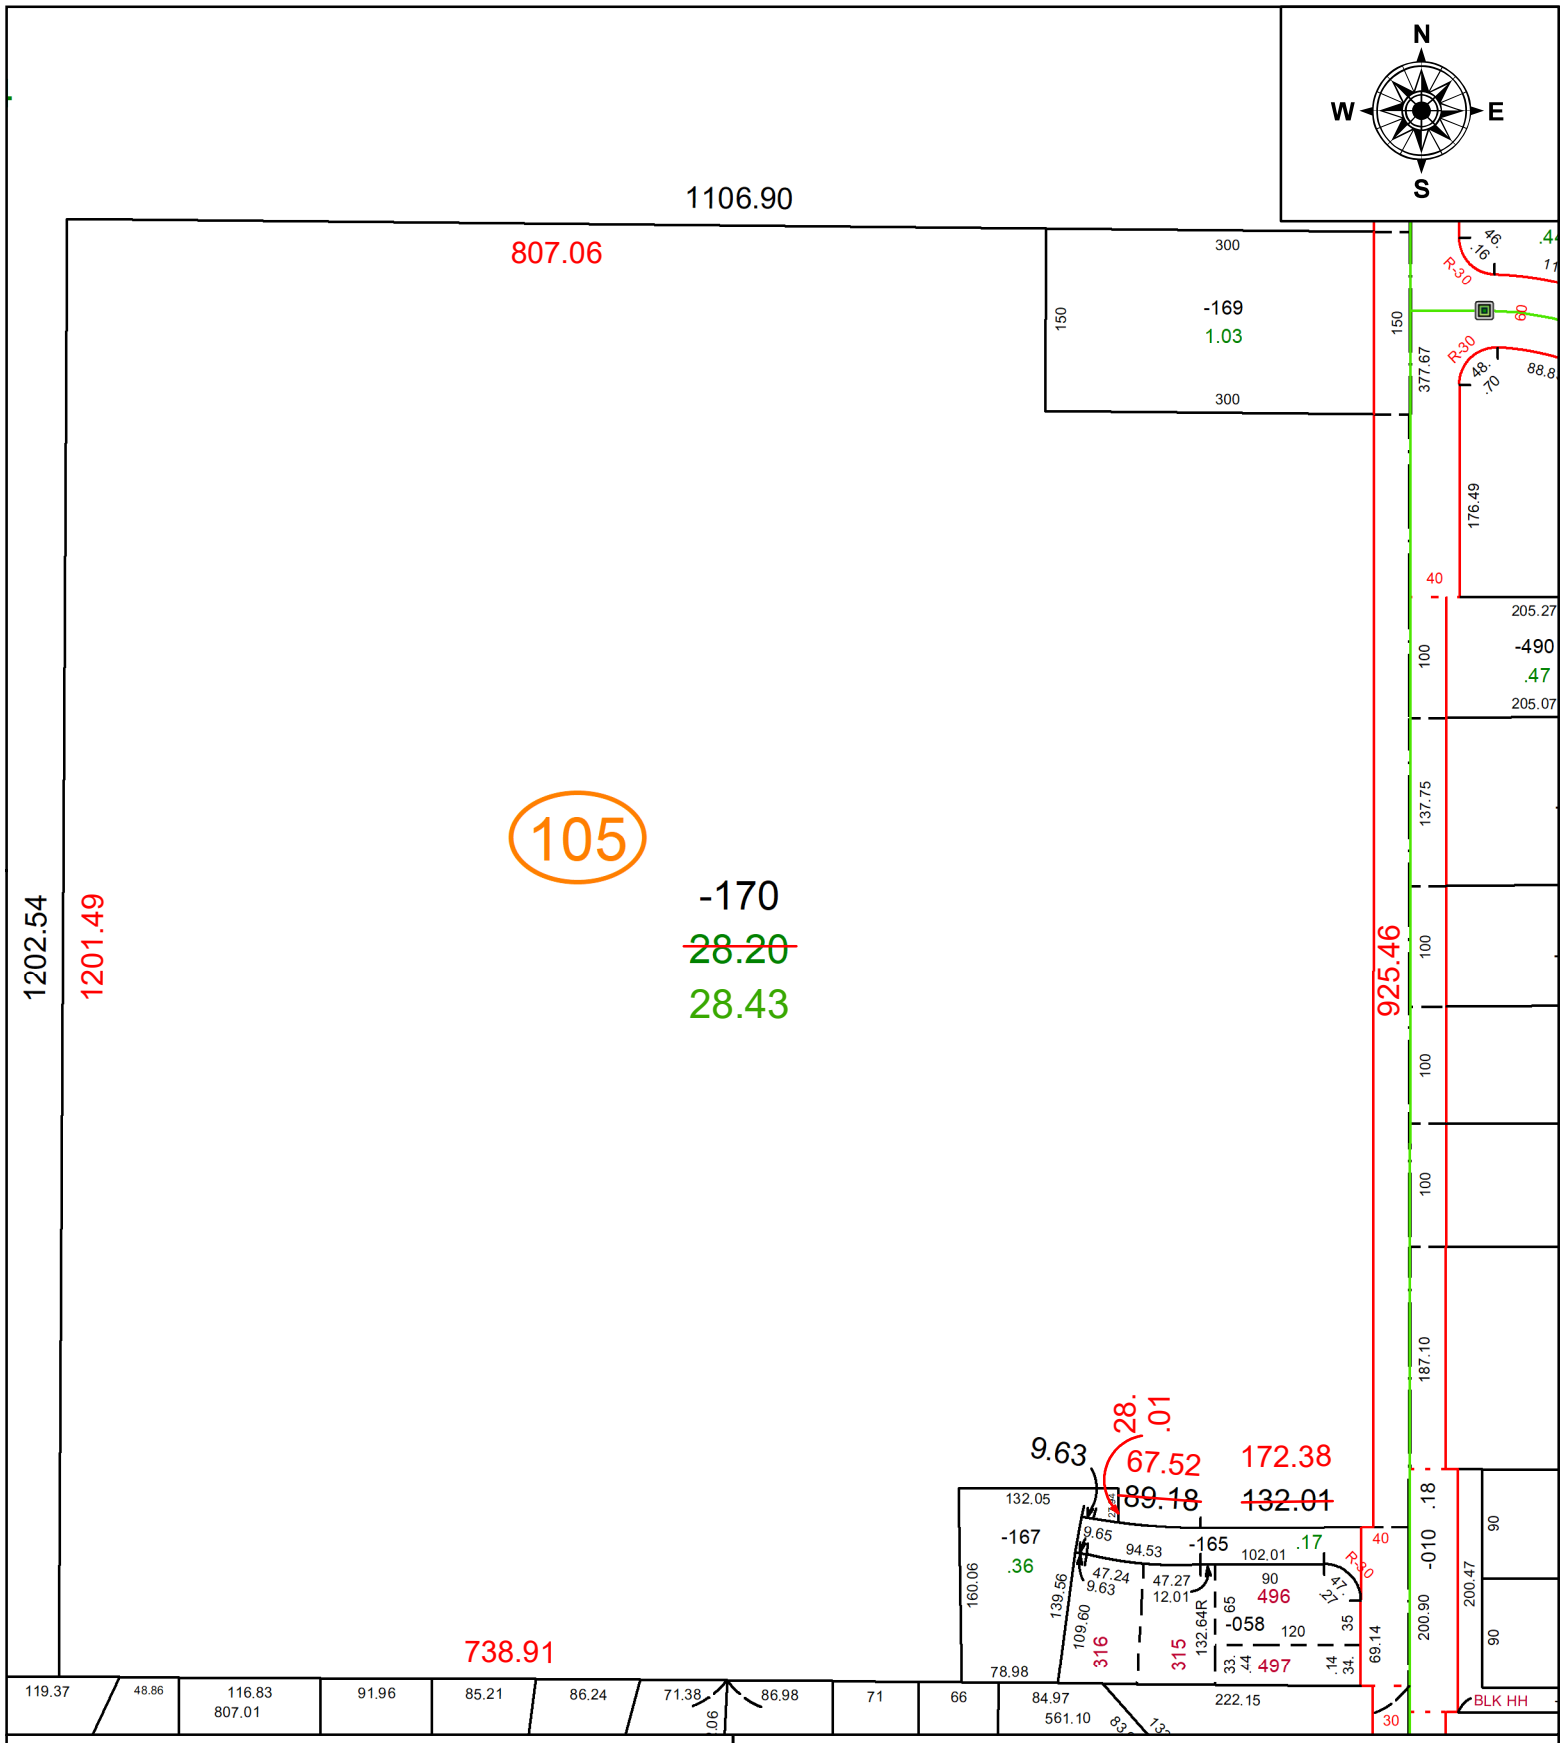


**SPLITS/DEEDS PROCESSED**

LORAIN COUNTY TAX MAP DEPARTMENT
226 MIDDLE AVE. ELYRIA, OH

**SURVEYED BY:** TIMOTHY D. HOZALSKI **SURV # 51407**

**CLOSURE:** 1: 100789

**MAP PAGE(S):** 04-00-024

**APPOVED BY:** AC **DATE:** March 11, 2025

**SCALE:** 1 in = 158 ft **PRIOR INSTRUMENT:** 2000- 0685729