PARENT PARCEL: 15-00-005-000-027

CHILD PARCEL: AC CORR PER SURV BY THOMAS A. SIMON

STARTING POINT: C/L OF PARSONS & NE CORNER OF O/L 05

25-05468-C

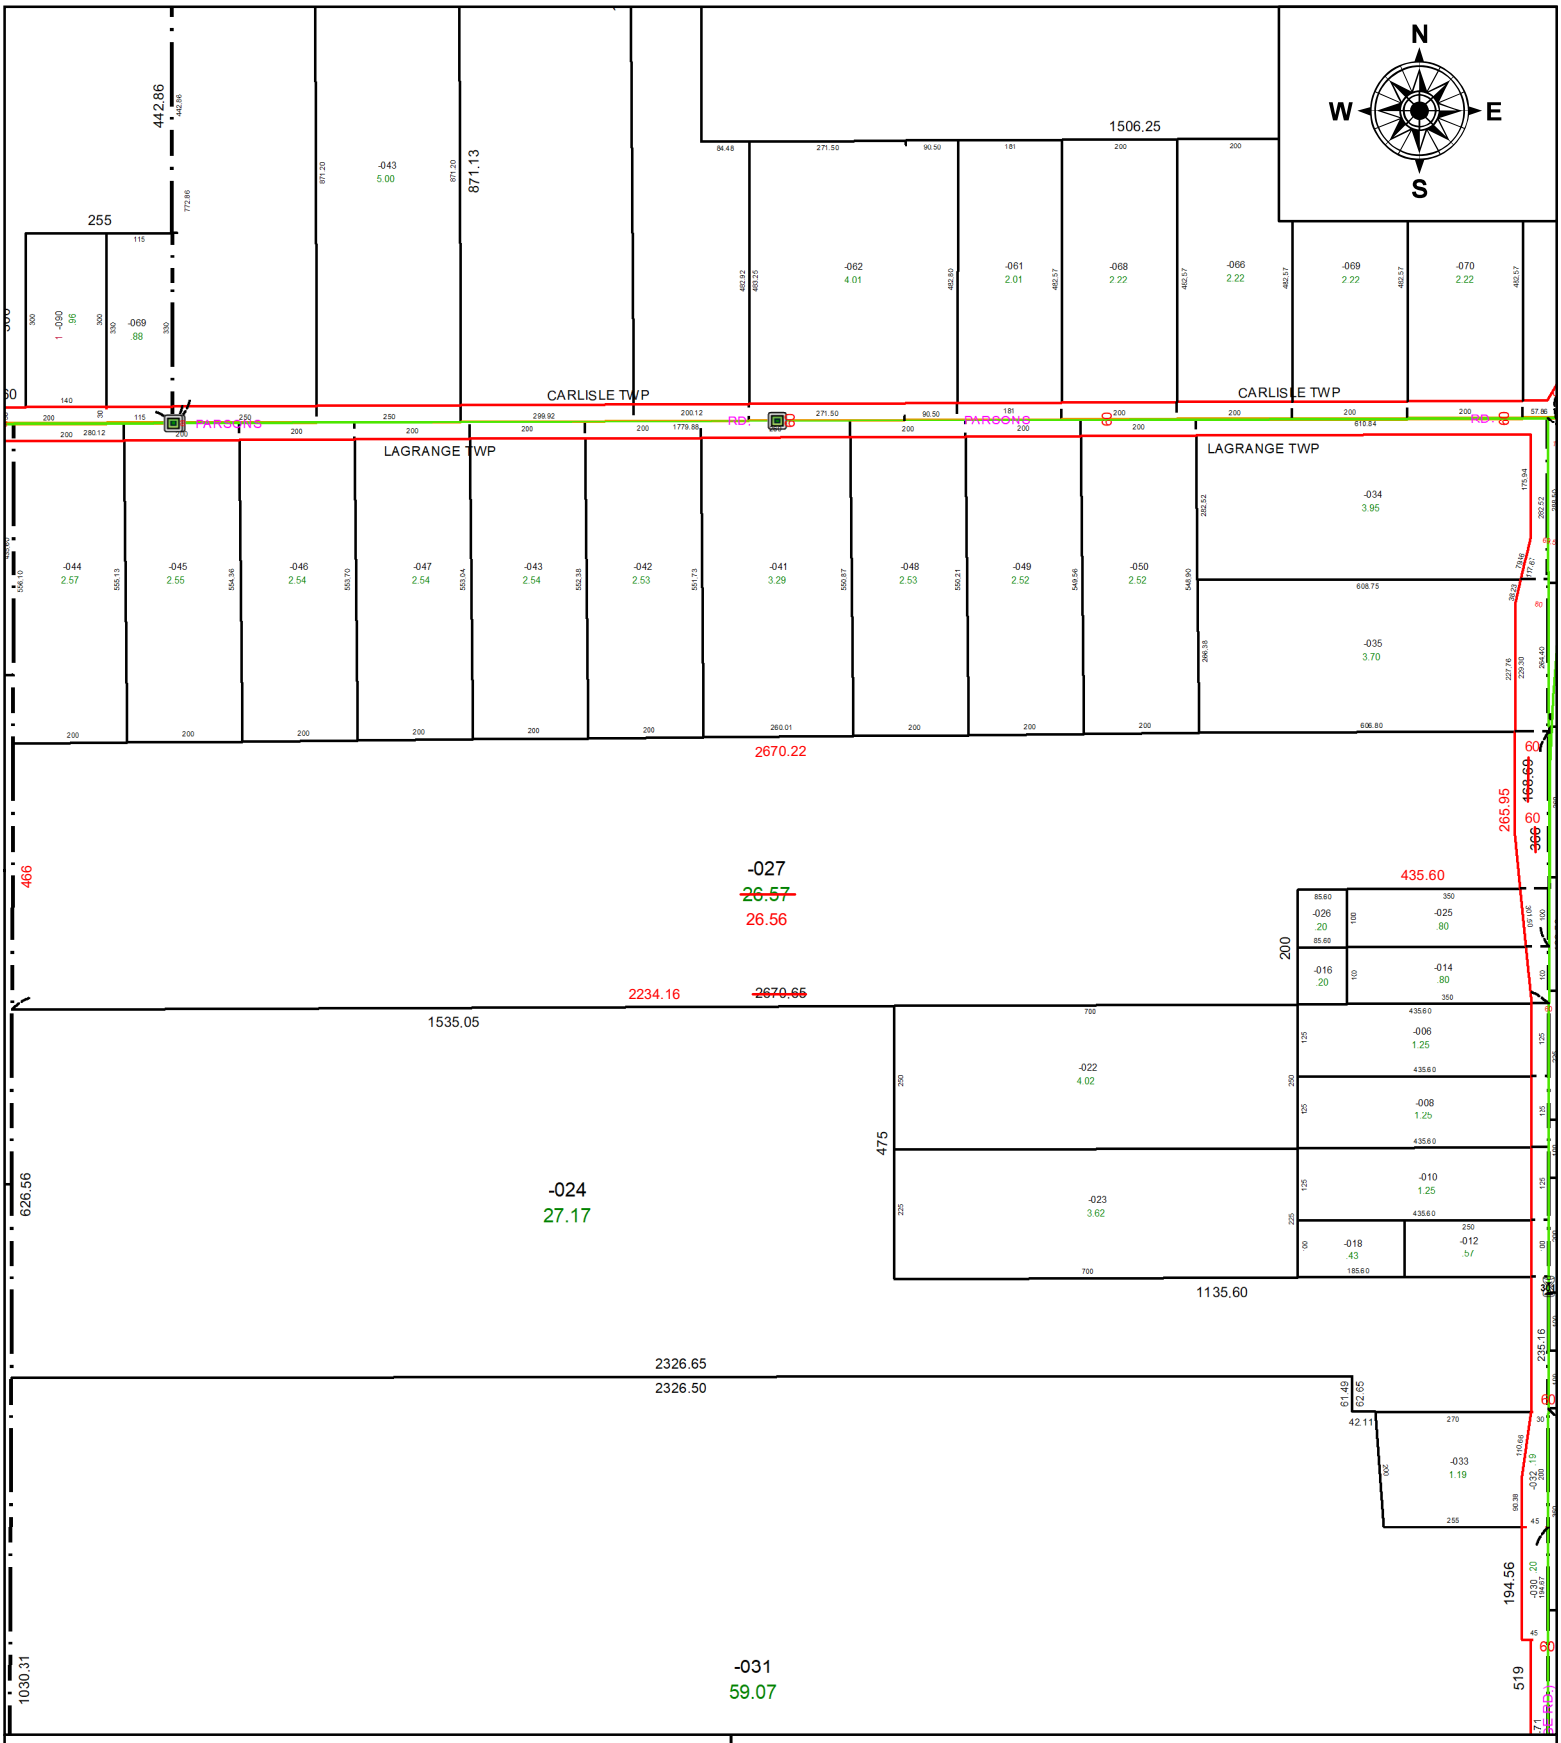

SPLITS/DEEDS PROCESSED

LORAIN COUNTY TAX MAP DEPARTMENT
226 MIDDLE AVE. ELYRIA, OH

SURVEYED BY: THOMAS A. SIMON **SURV # 51408**

CLOSURE: 1: 637620

MAP PAGE(S): 15-00-005

APPOVED BY: AC **DATE:** March 11, 2025

SCALE: 1 in = 333 ft **PRIOR INSTRUMENT:** 2017- 0641687