**PARENT PARCEL:** 06-25-011-103-004

**CHILD PARCEL:** AC CORR PER SURVEYOR TIMOTHY FINKE

**STARTING POINT:** MONUMENT BOX @ INSTERSECTION OF C/LS OF EAST BROAD ST & SR 57

# 25-05484-C

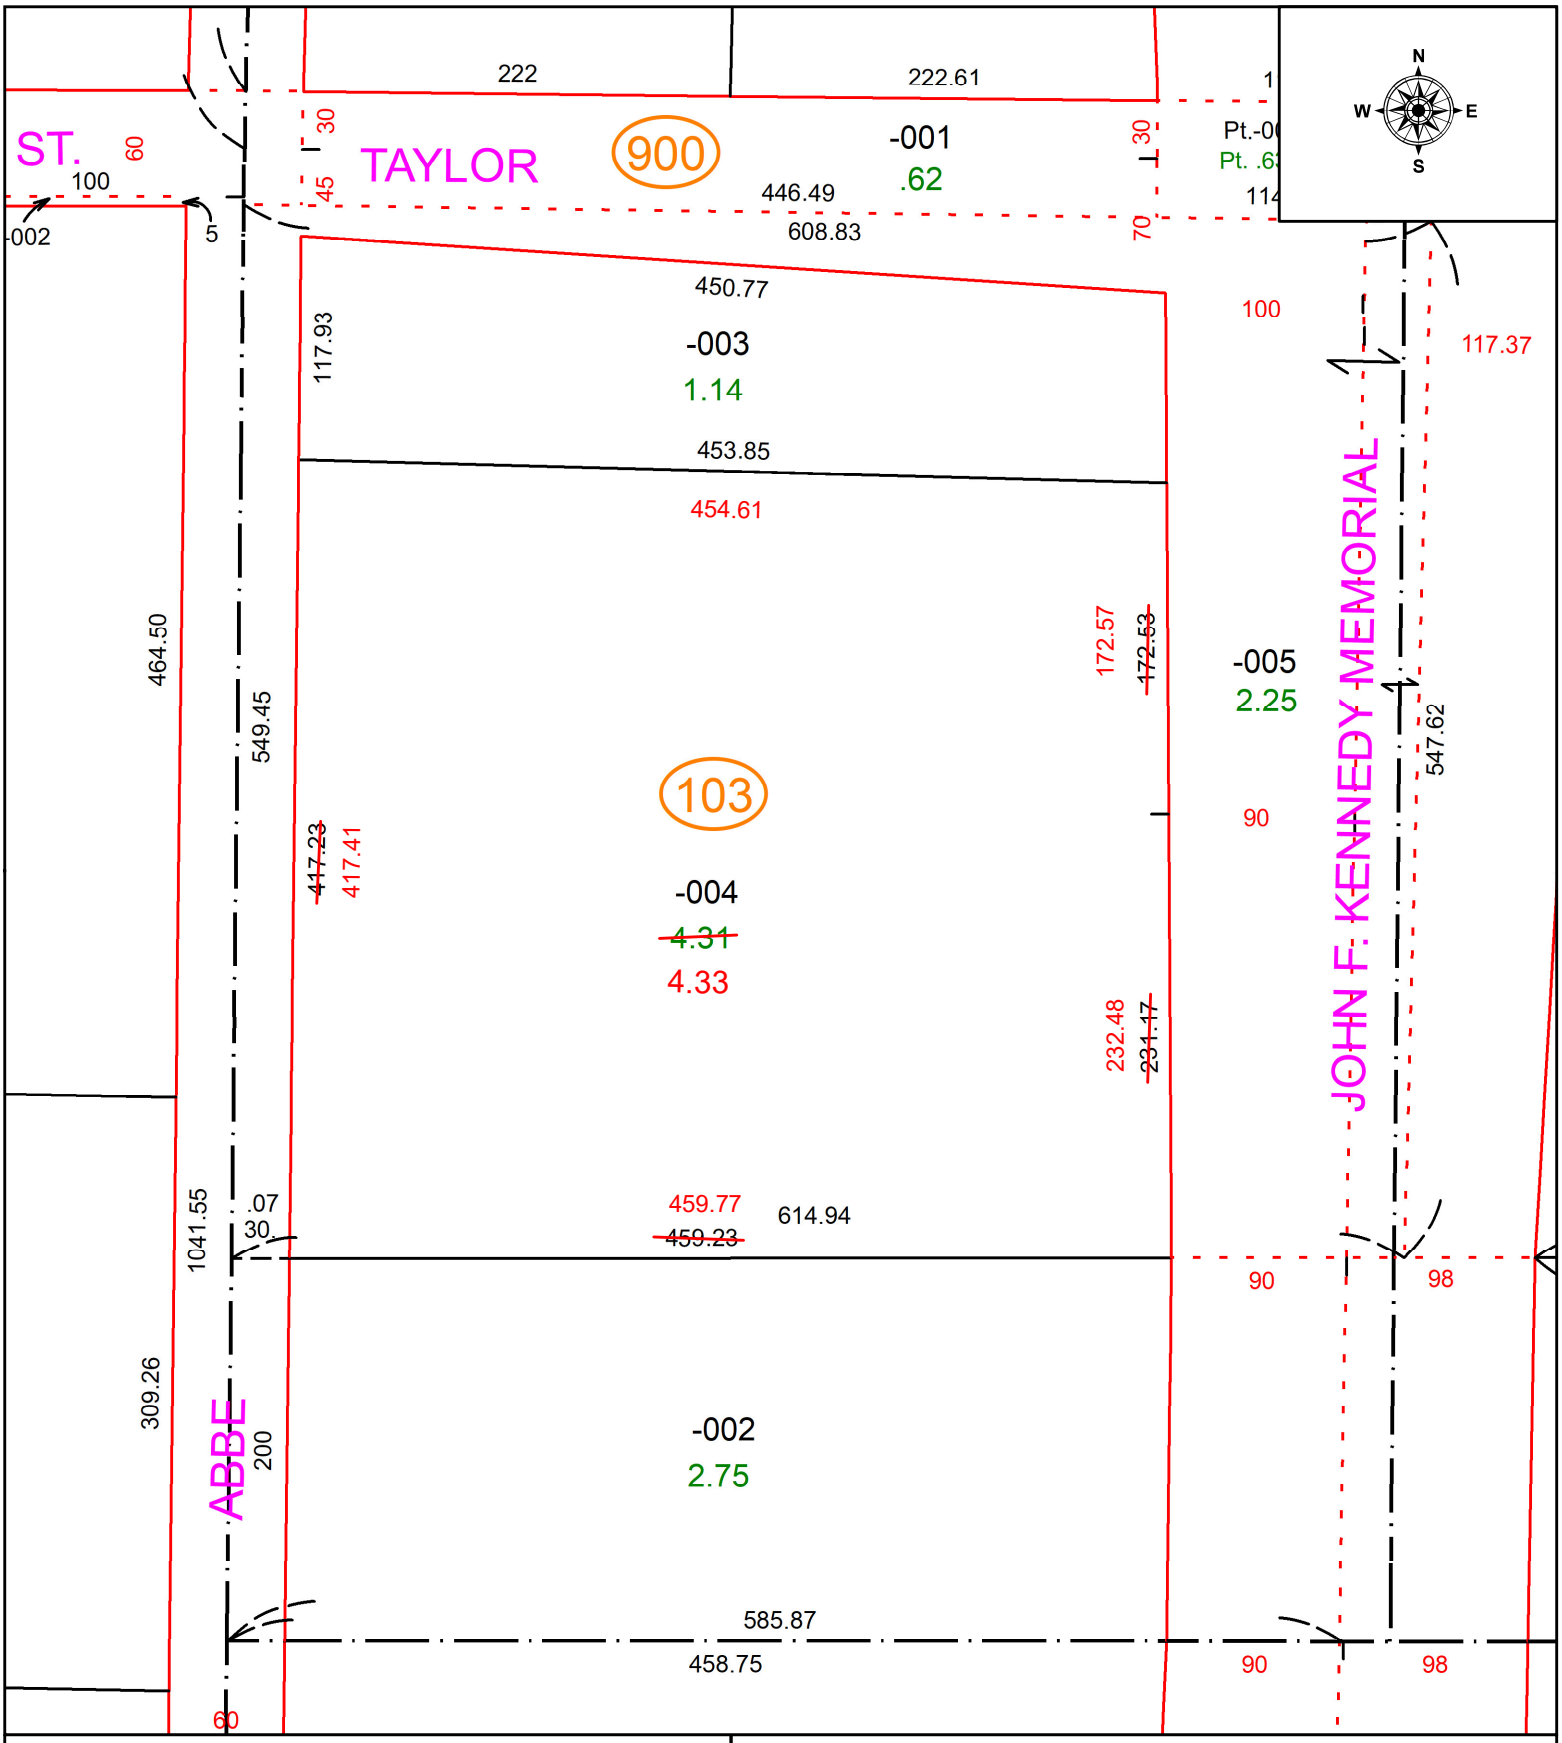


**SPLITS/DEEDS PROCESSED**

LORAIN COUNTY TAX MAP DEPARTMENT
226 MIDDLE AVE. ELYRIA, OH

**SURVEYED BY:** TIMOTHY FINKE SURVEY # 51426

**CLOSURE:** 1: 1272665

**MAP PAGE(S):** 06-25-011

**APPOVED BY:** WRZ **DATE:** 4/16/2025

**SCALE:** 1" = 100 **PRIOR INSTRUMENT:** #2023-0921290