PARENT PARCEL: 11-00-023-000-029

CHILD PARCEL: AC CORR PER SURV BY PATRICK A. MCGANNON

STARTING POINT: C/L OF CAPEL AND ISLAND RD

25-05486-C

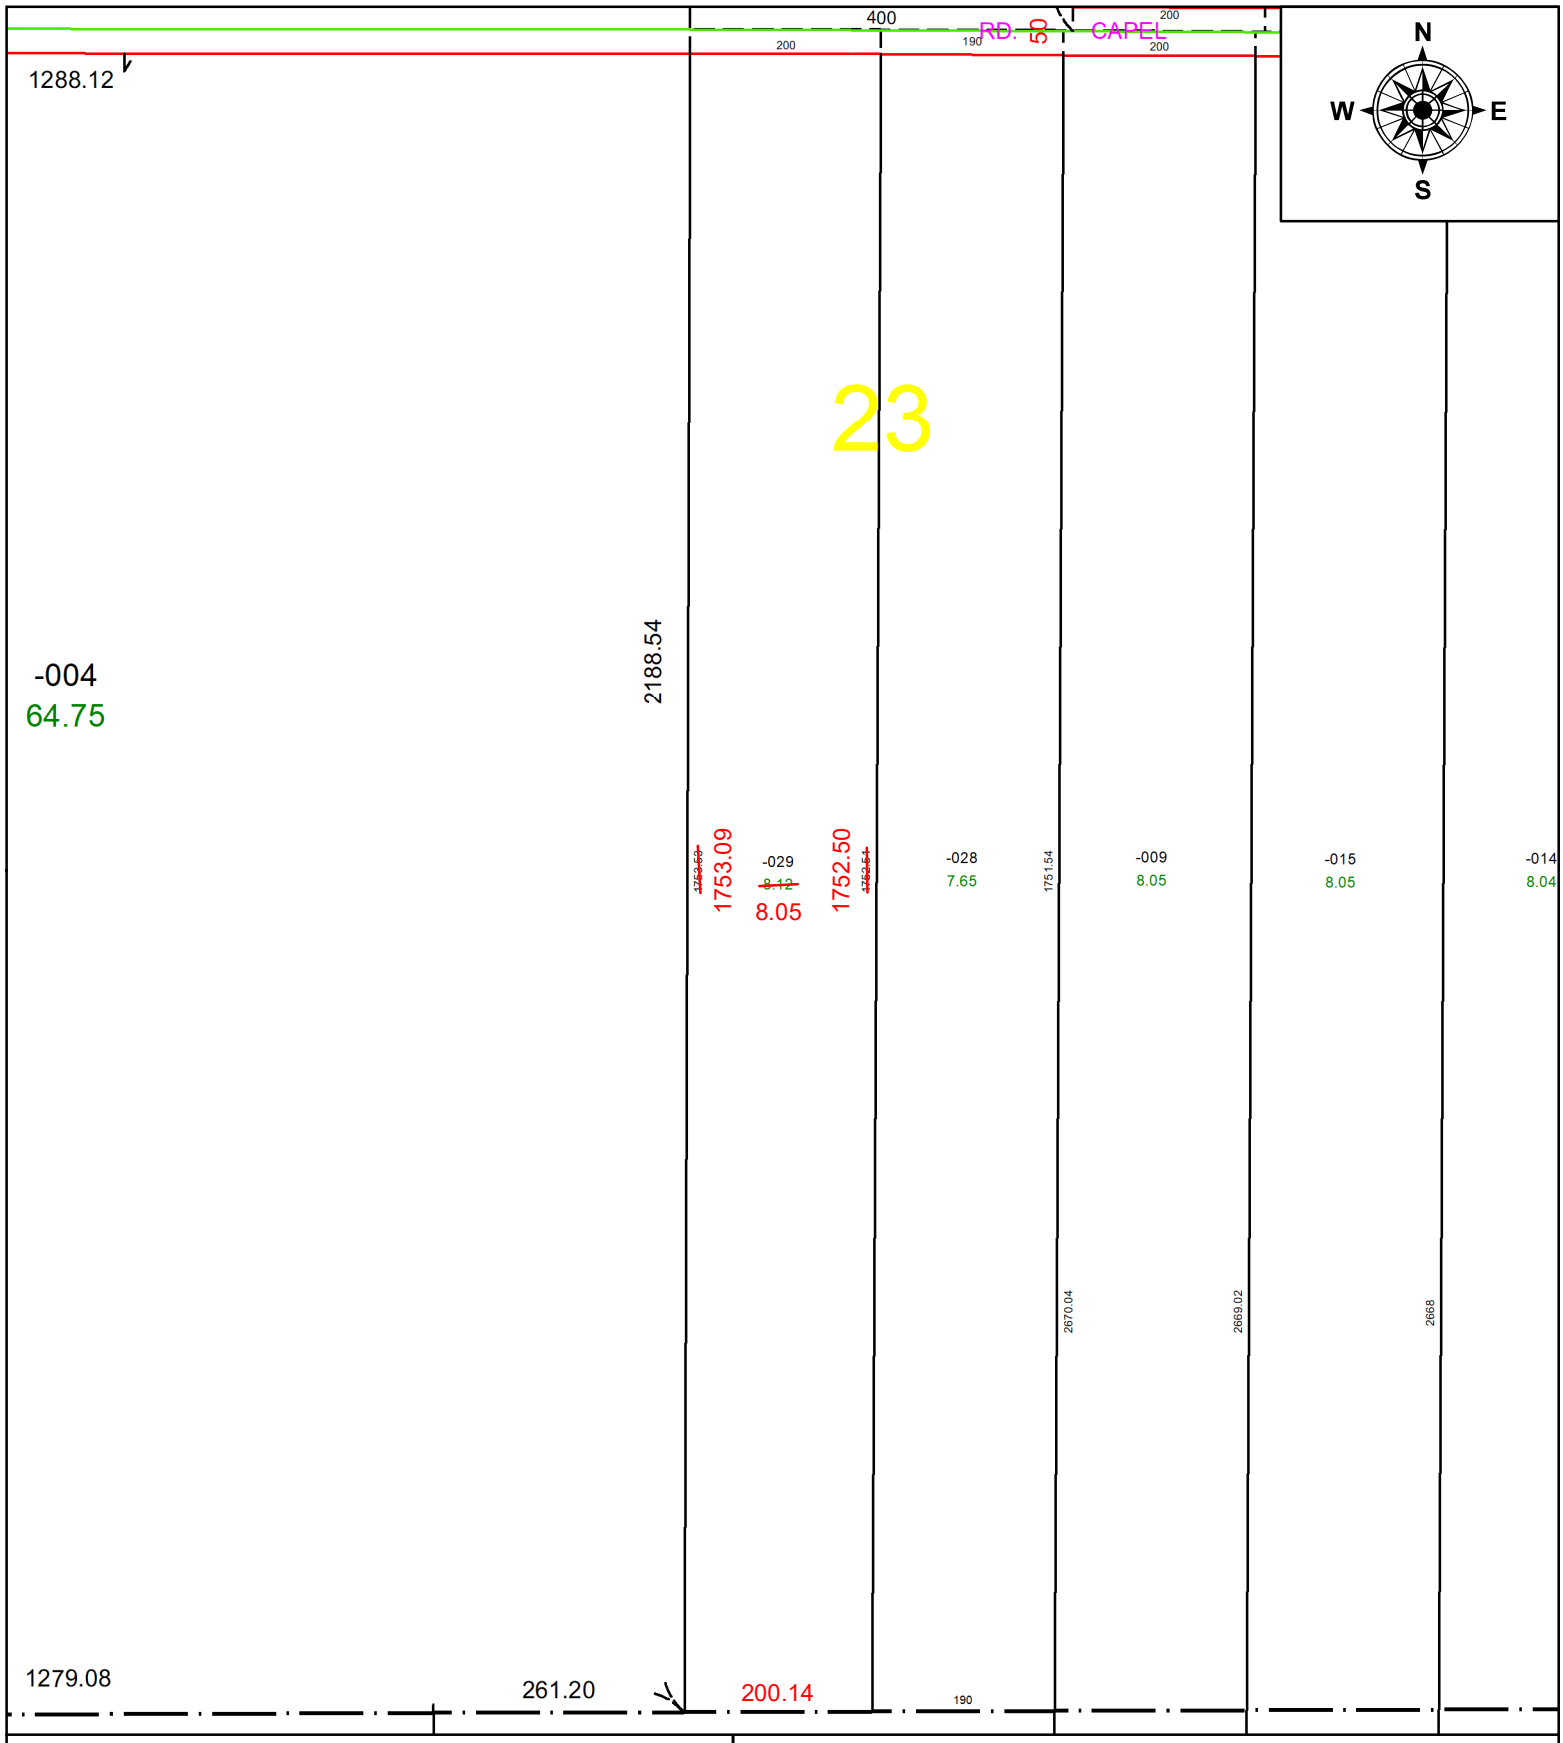

SPLITS/DEEDS PROCESSED

LORAIN COUNTY TAX MAP DEPARTMENT
226 MIDDLE AVE. ELYRIA, OH

SURVEYED BY: PATRICK A. MCGANNON **SURV # 51428**

CLOSURE: 1: 413750

MAP PAGE(S): 11-00-023

APPOVED BY: AC **DATE:** April 16, 2025

SCALE: 1 in = 200 ft **PRIOR INSTRUMENT:** 2024- 0024646