PARENT PARCEL: ANNEXATION OF 09-00-066-000-015, -016, & -017
CHILD PARCEL: ORD. # 25-19 AC CMS & RES. # 24-755
STARTING POINT: CL OF MAPLE ST. & CL OF NORTH PLEASANT ST.

25-05500-X

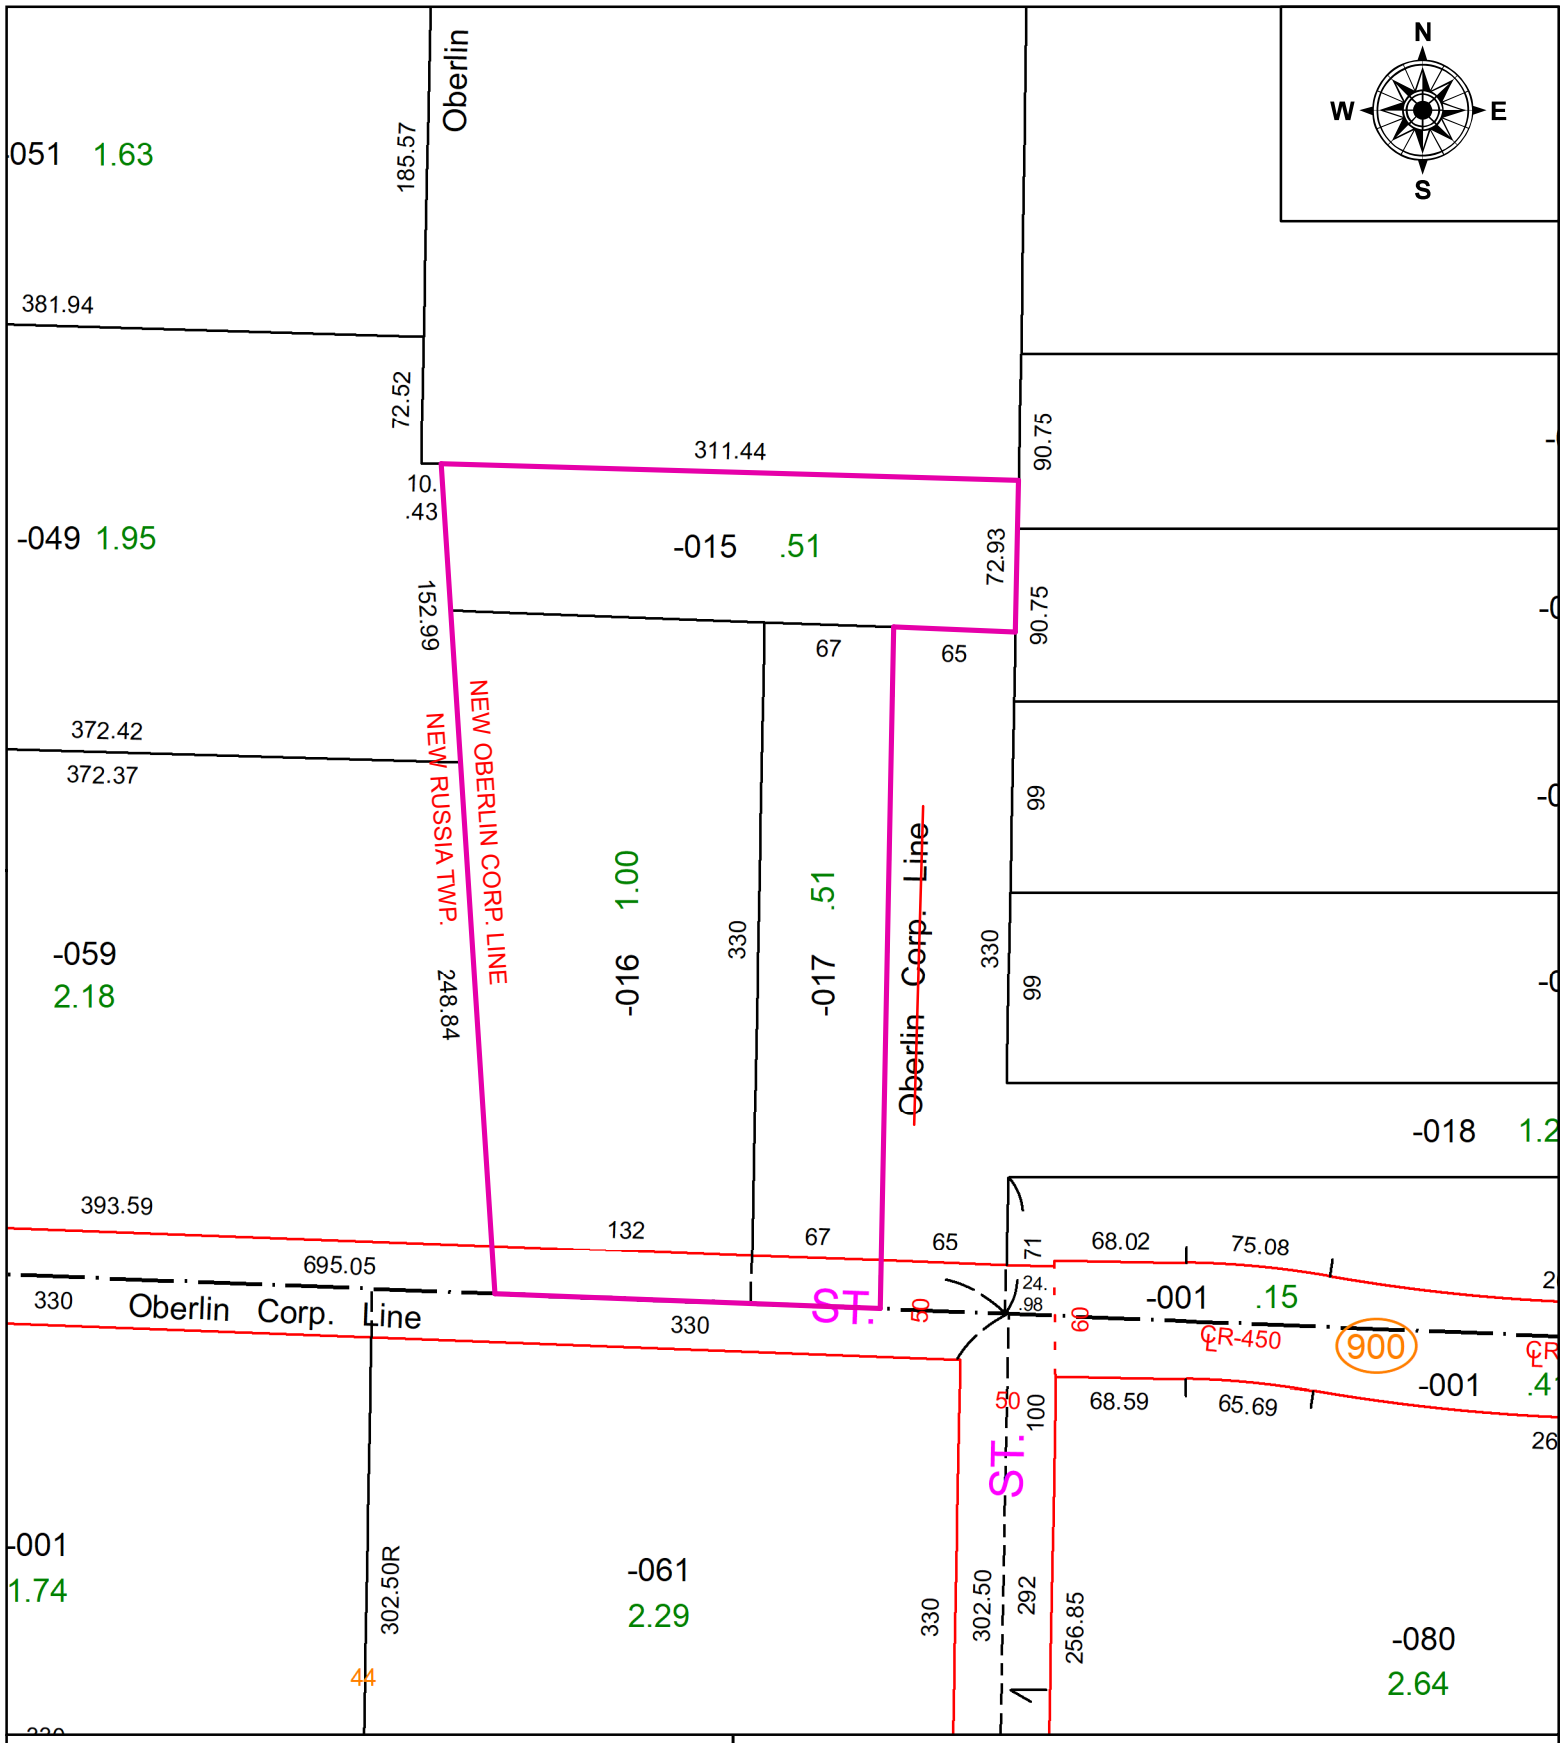

SPLITS/DEEDS PROCESSED
LORAIN COUNTY TAX MAP DEPARTMENT
226 MIDDLE AVE. ELYRIA, OH

SURVEYED BY: T. SIMON
CLOSURE: 1: INF
MAP PAGE(S): 09-00-066
APPOVED BY: TJS **DATE:** 11/1/2024
SCALE: 1" = 100' **PRIOR INSTRUMENT:** NA