PARENT PARCEL: 10-00-006-109-009

CHILD PARCEL: AC. CORR. PER INSTR. # 2000-0670341

STARTING POINT: N/A

25-05502-A

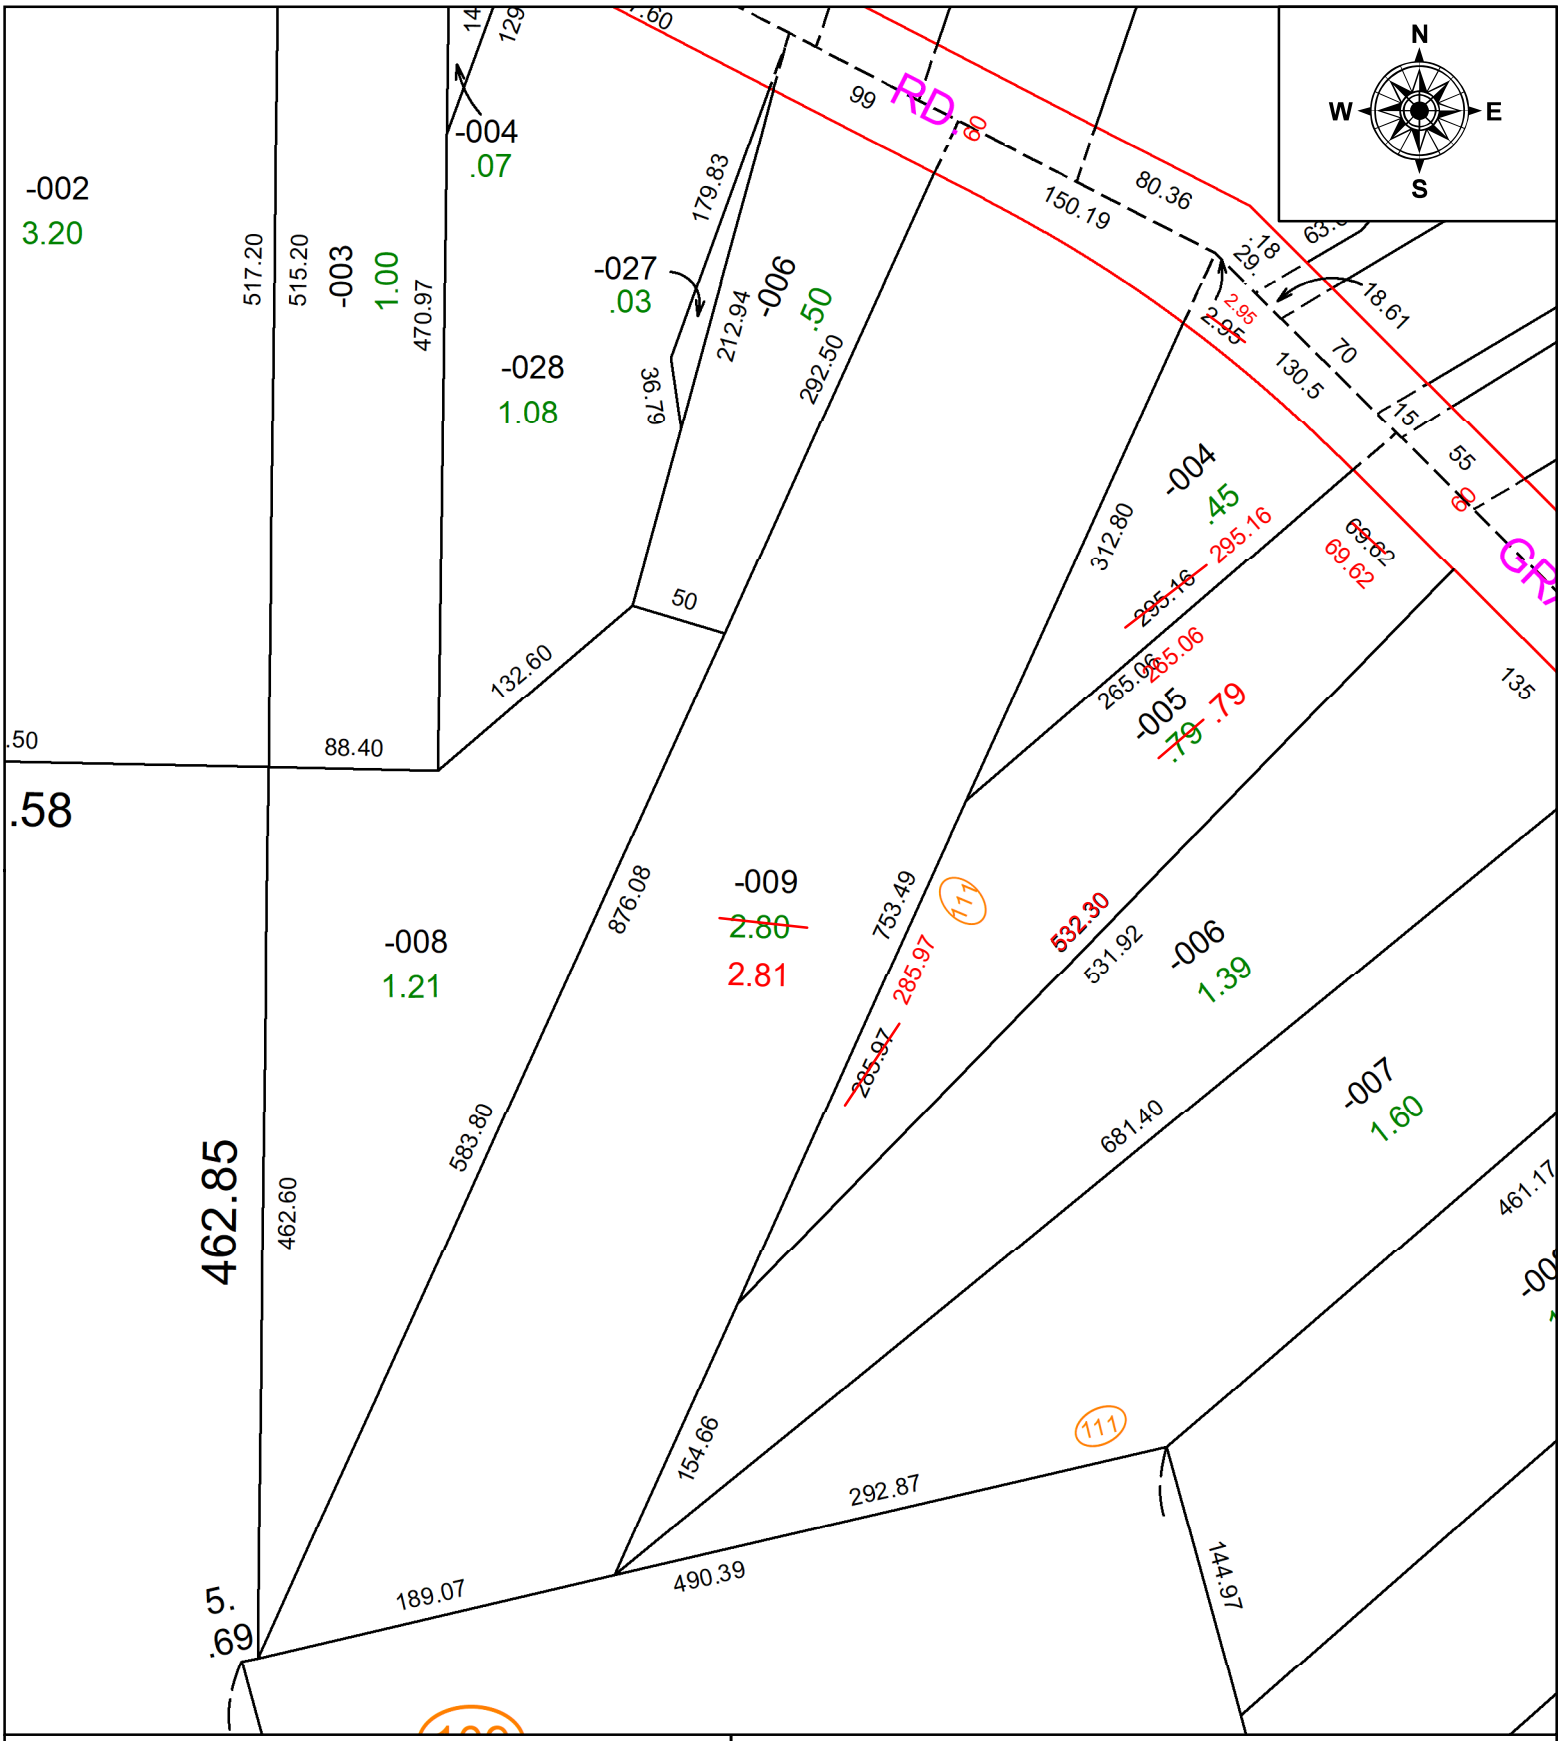

SPLITS/DEEDS PROCESSED

LORAIN COUNTY TAX MAP DEPARTMENT
226 MIDDLE AVE. ELYRIA, OH

SURVEYED BY: N/A **SURVEY #:** N/A

CLOSURE: N/A

MAP PAGE(S): 10-00-006

APPOVED BY: DMA **DATE:** 5/8/2025

SCALE: 1" = 50' **PRIOR INSTRUMENT:** 2000-0670341