PARENT PARCEL: 18-00-027-106-026

CHILD PARCEL: FRONT & DEPTH TO AC CORR PER SURV BY THOMAS M. SNEZEK

STARTING POINT: NE CORNER OF O/L 27

25-05506-C

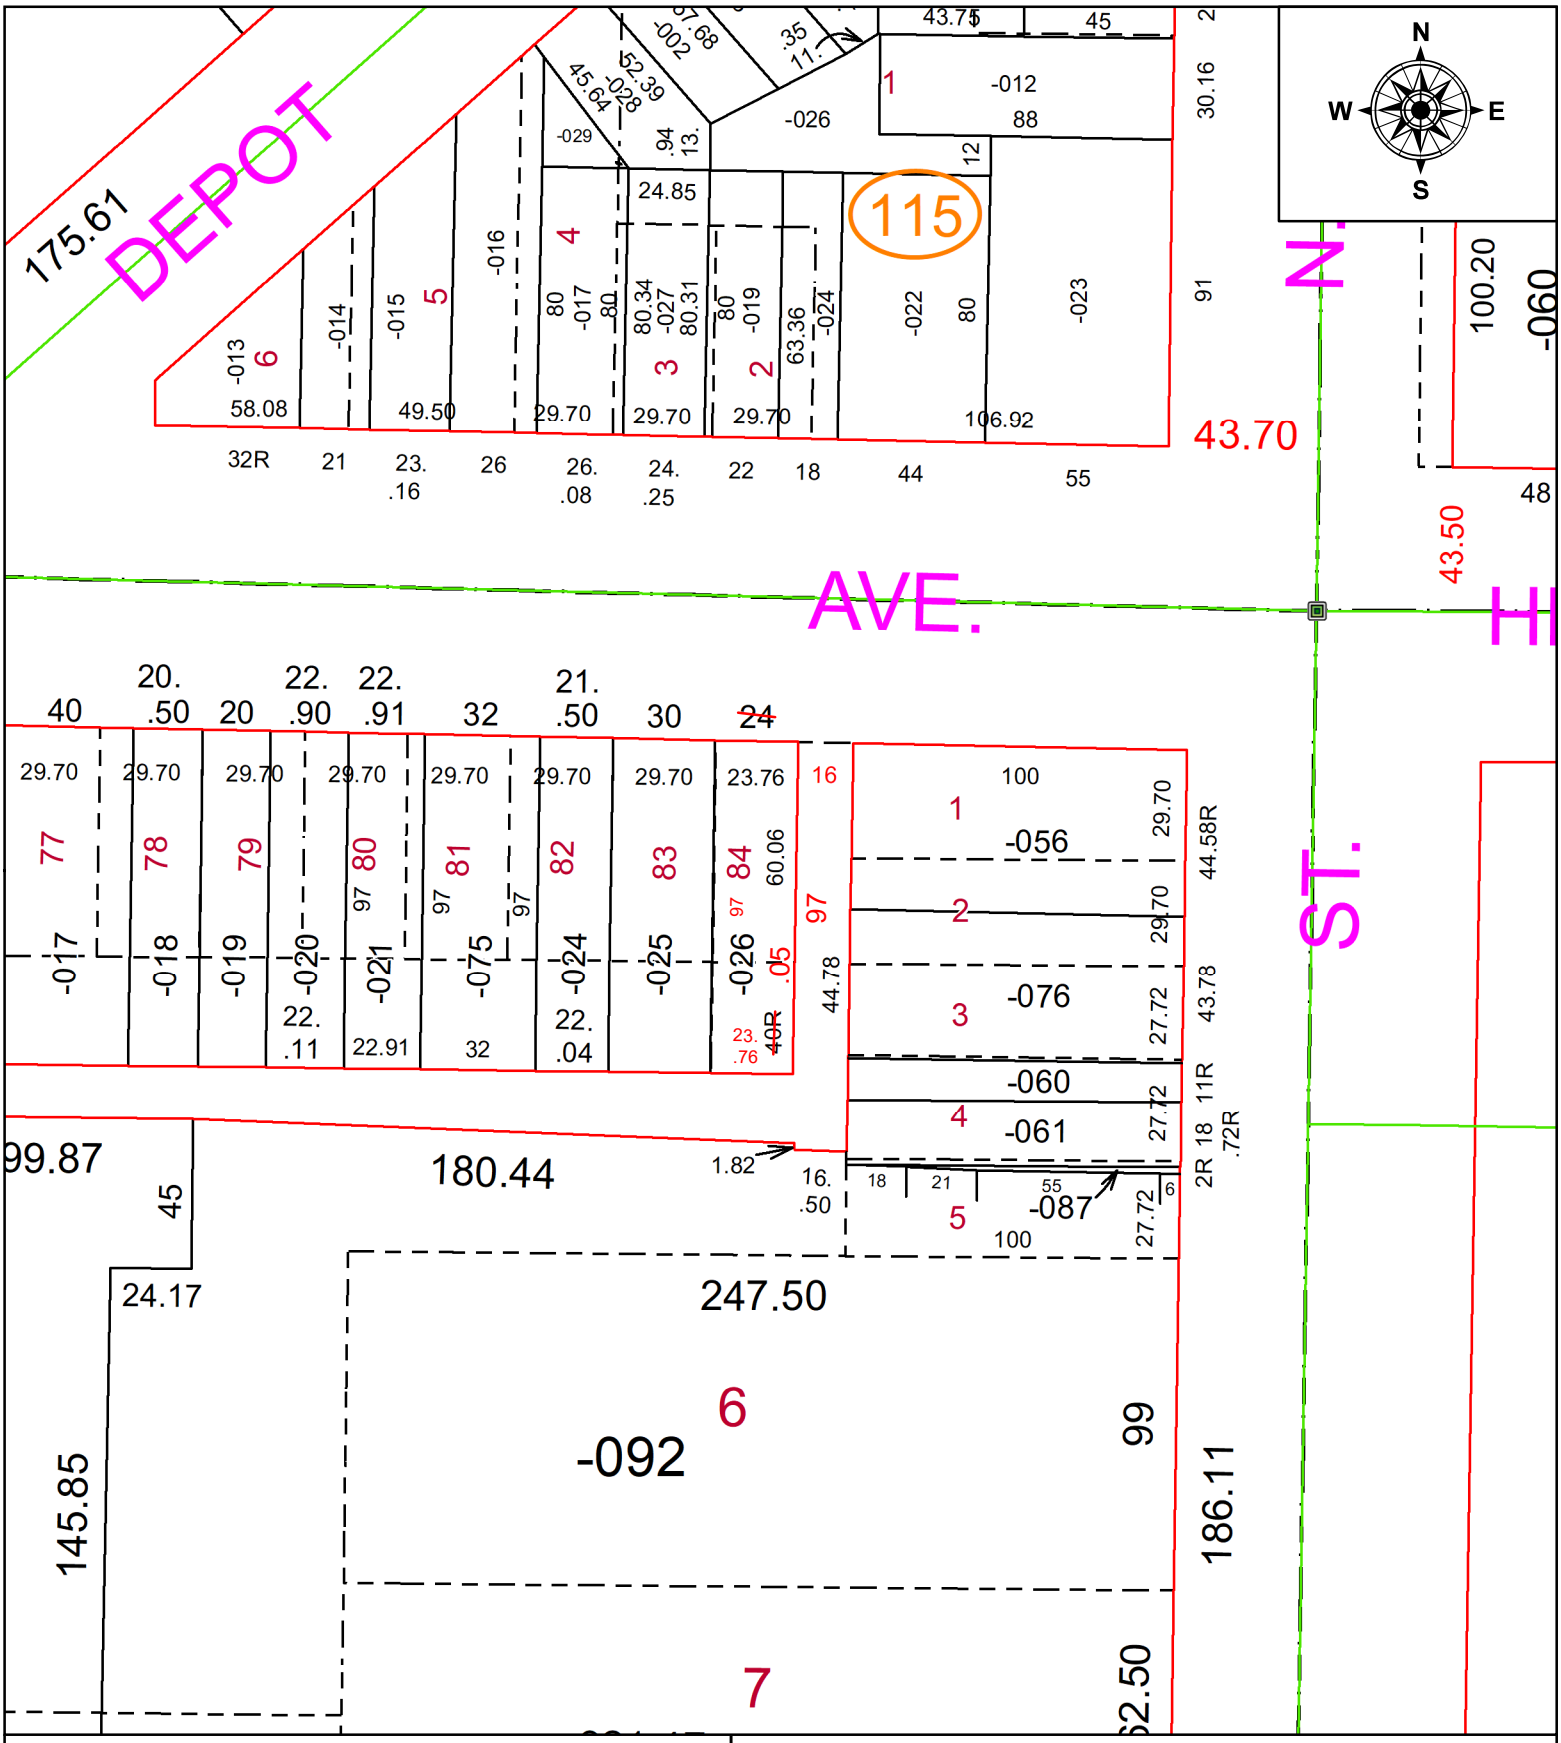

SPLITS/DEEDS PROCESSED

LORAIN COUNTY TAX MAP DEPARTMENT
226 MIDDLE AVE. ELYRIA, OH

SURVEYED BY: THOMAS M. SNEZEK **SURV # 51448**

CLOSURE: 1: INF

MAP PAGE(S): 18-00-027

APPOVED BY: AC **DATE:** May 19, 2025

SCALE: 1 in = 58 ft **PRIOR INSTRUMENT:** 2022- 0881025