PARENT PARCEL: 03-00-111-119-007, -008, 03-00-110-104-005

CHILD PARCEL: FR & DPTH TO AC CORR PER SURVEYOR RONALD HINTON

STARTING POINT: INTERSECTION OF C/LS OF ELYRIA AVE & NORTH RIDGE RD

25-05565-C

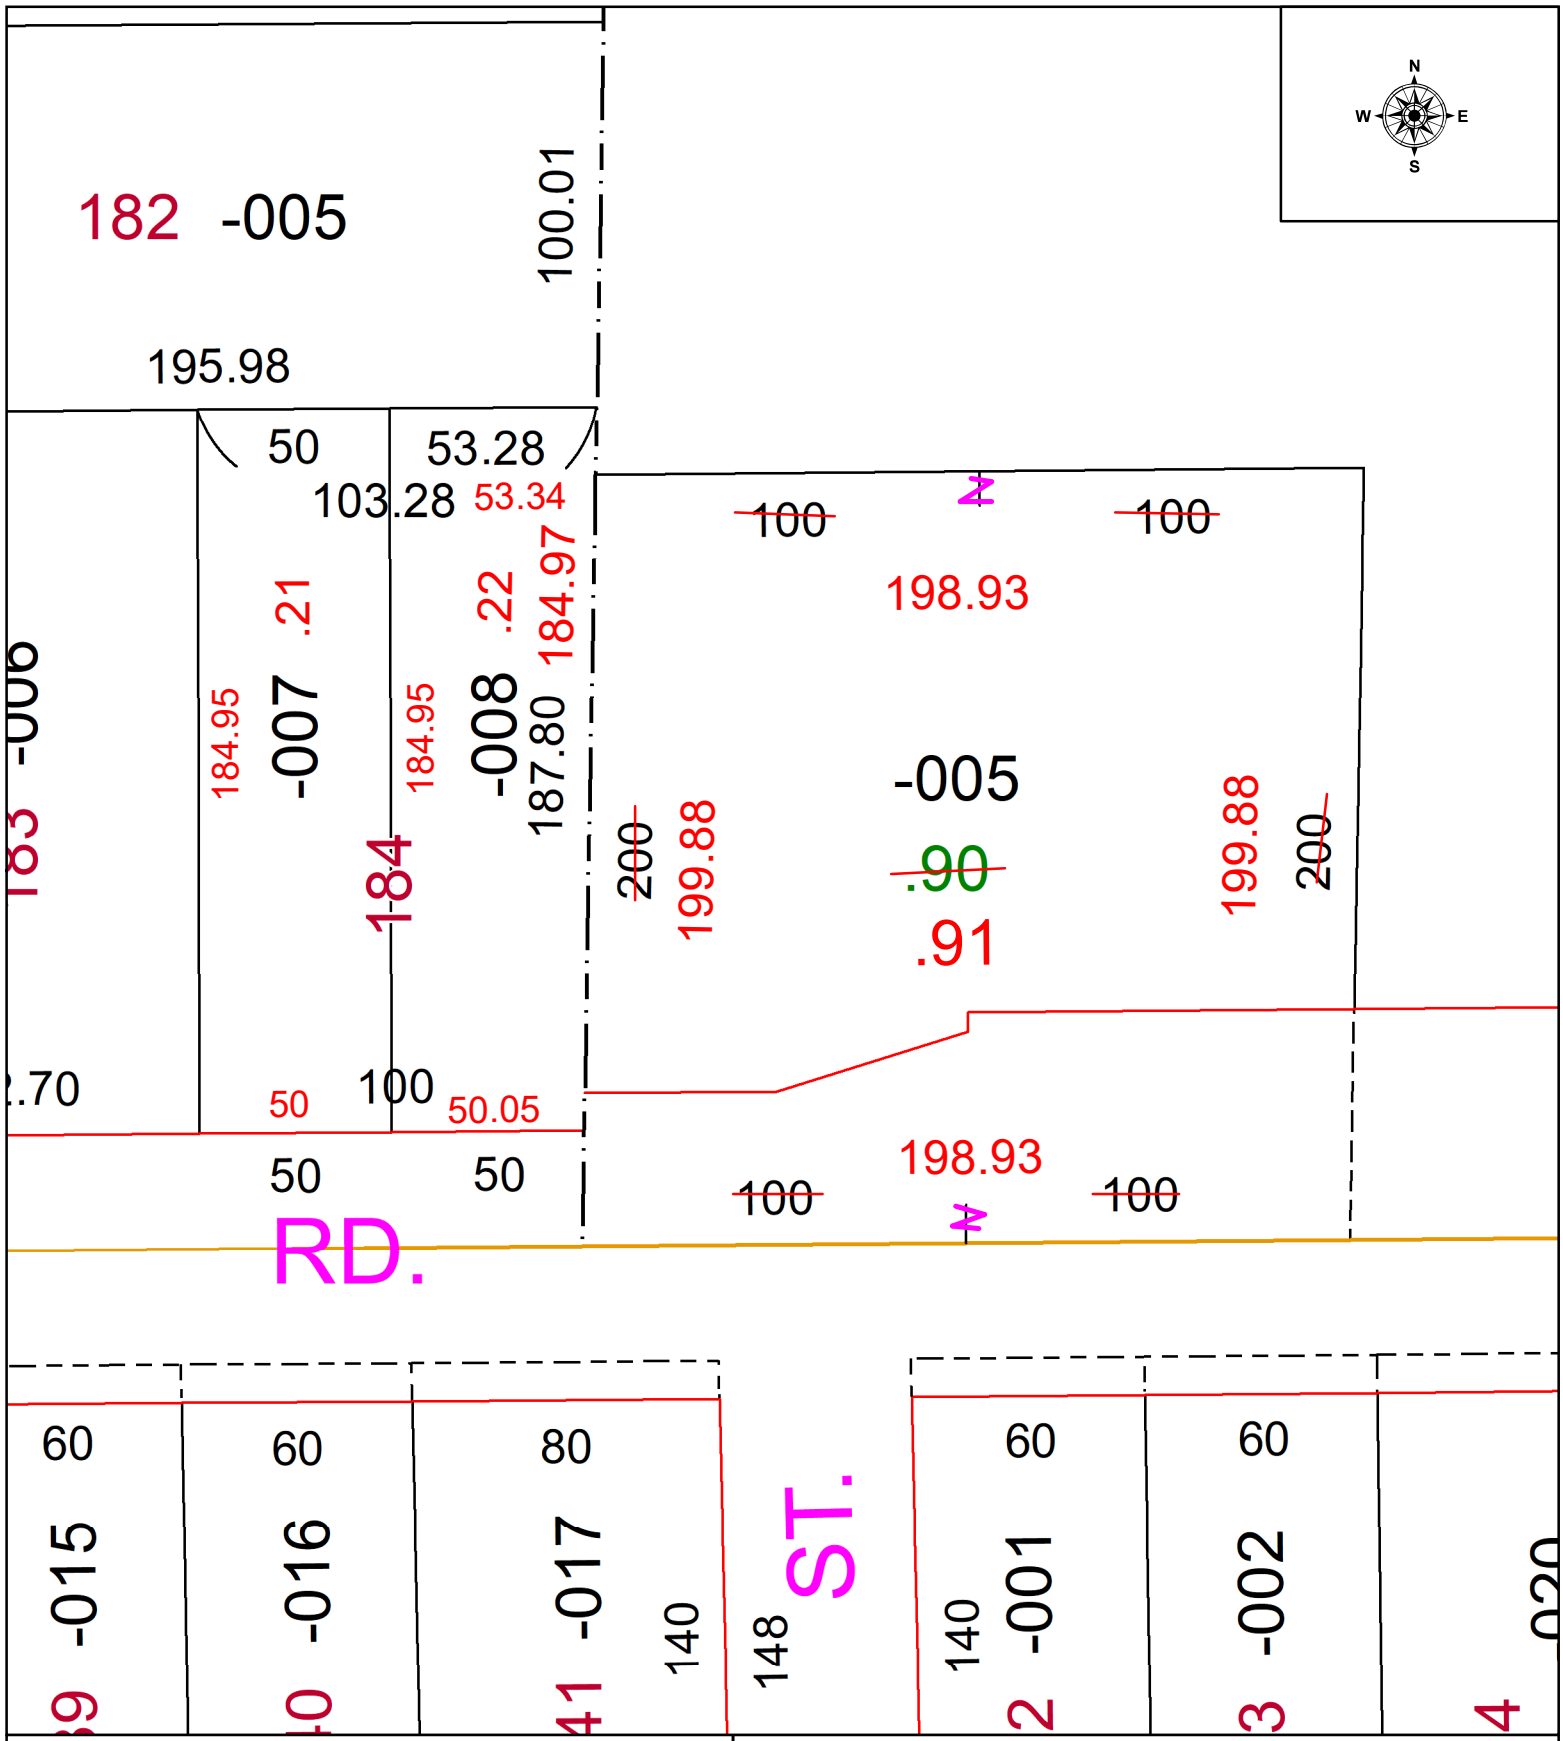

SPLITS/DEEDS PROCESSED

LORAIN COUNTY TAX MAP DEPARTMENT
226 MIDDLE AVE. ELYRIA, OH

SURVEYED BY: RONALD HINTON — SURVEY # 51526

CLOSURE: 1: INF

MAP PAGE(S): 03-00-111 & 03-00-110

APPOVED BY: WRZ **DATE:** 10/16/2025

SCALE: 1" = 50 **PRIOR INSTRUMENT:** #2017-0622192