PARENT PARCEL: 10-00-006-109-001
CHILD PARCEL: AC CORR PER SURV BY SEAN A. BOLAND
STARTING POINT: C/L OF GRAFTON RD AND JERROL CT

25-05582-C

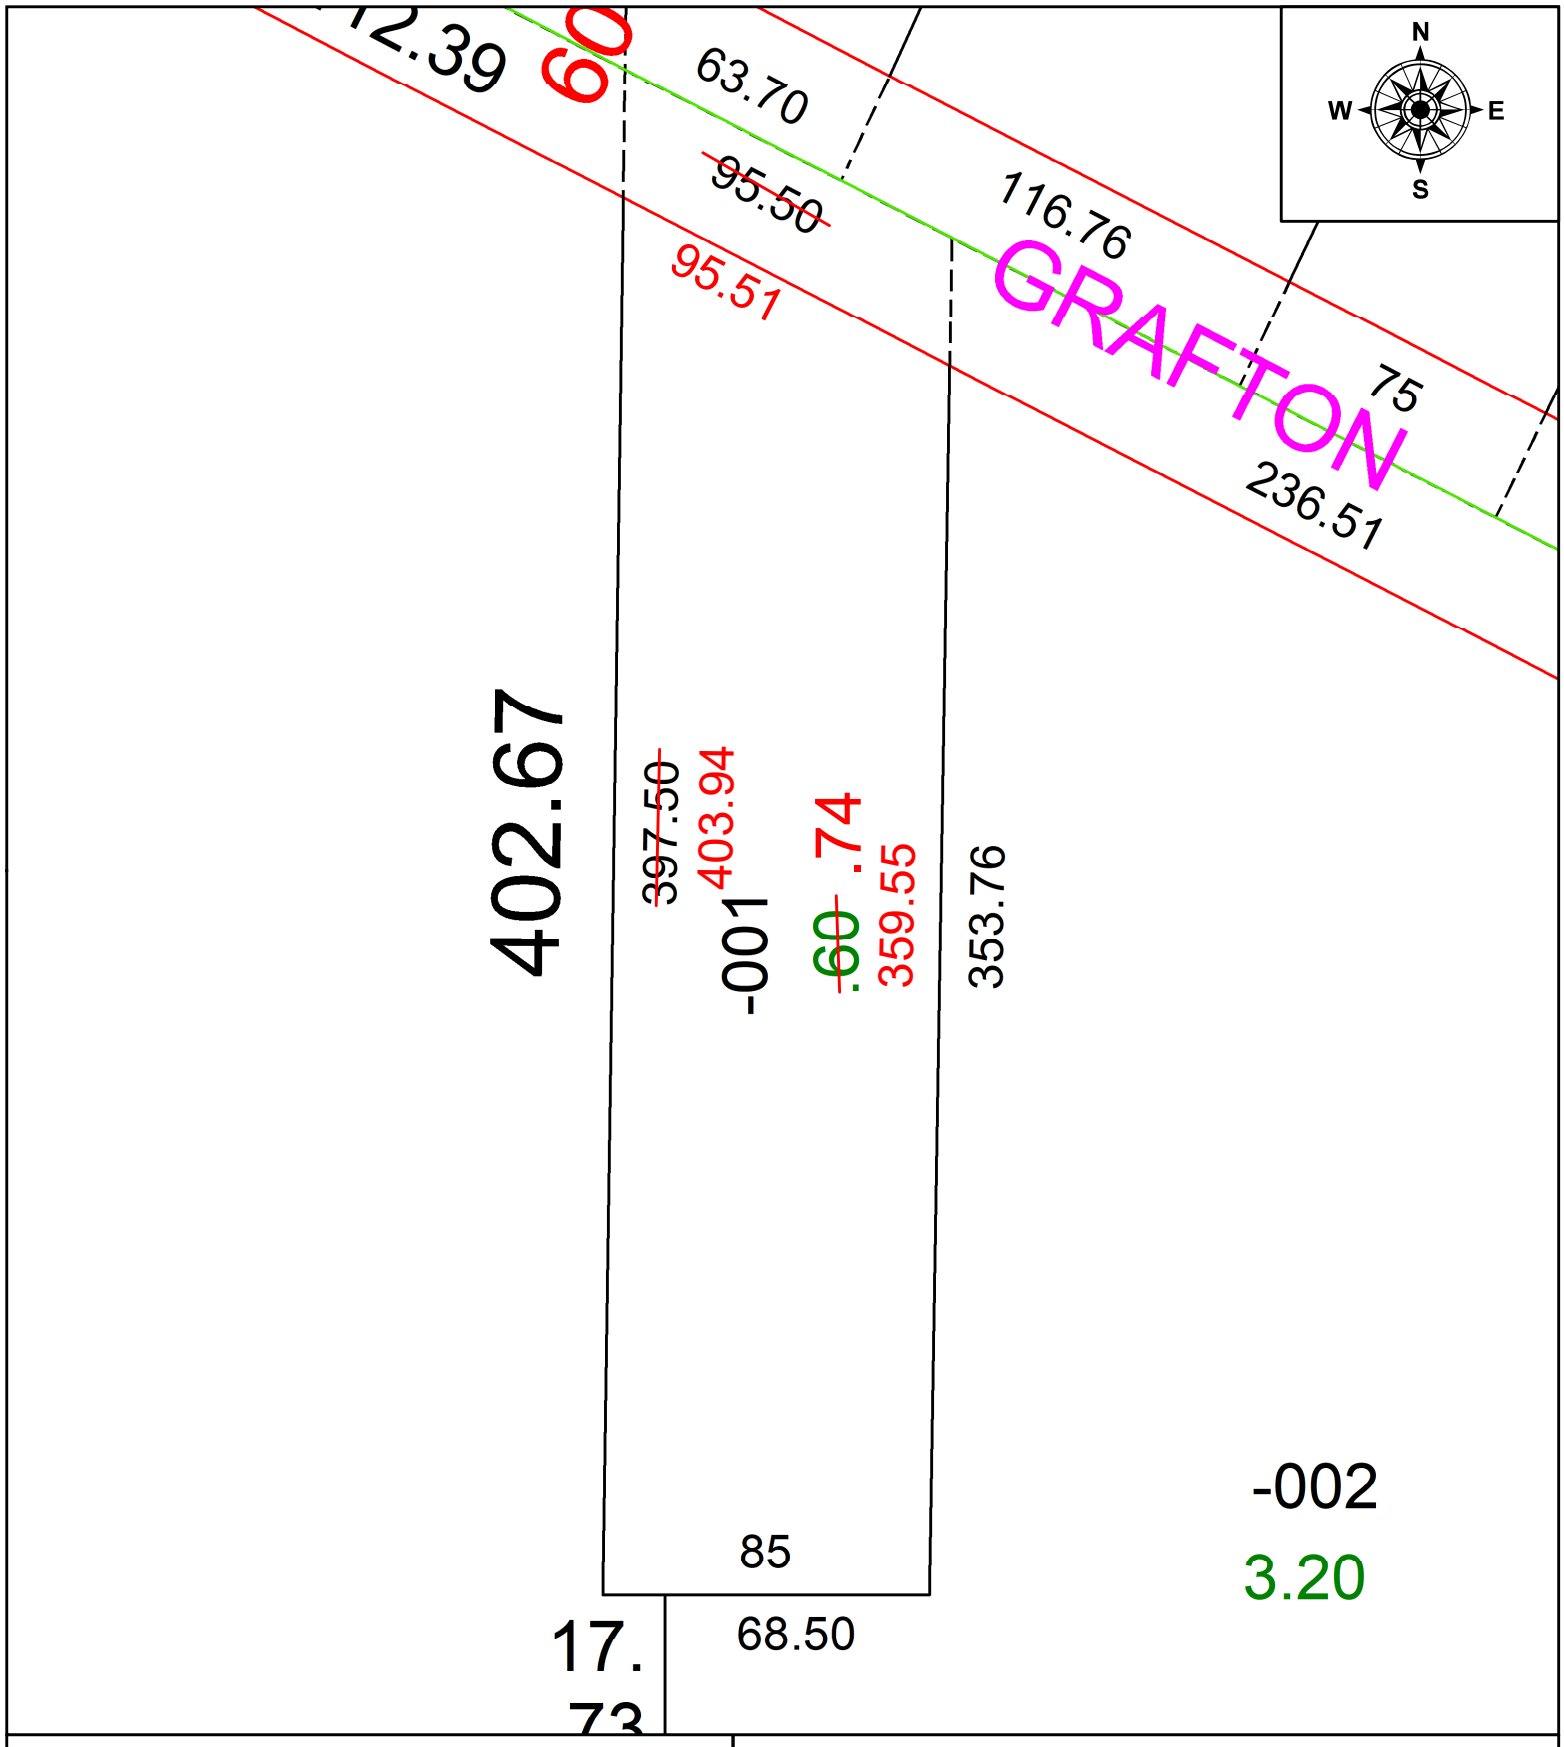

SPLITS/DEEDS PROCESSED
LORAIN COUNTY TAX MAP DEPARTMENT
226 MIDDLE AVE. ELYRIA, OH

SURVEYED BY: SEAN A. BOLAND **SURV # 51543**
CLOSURE: 1: 76128
MAP PAGE(S): 10-00-006
APPOVED BY: AC **DATE:** September 16, 2025
SCALE: 1 in = 50 ft **PRIOR INSTRUMENT:** 2024- 0027371