PARENT PARCEL: 10-00-004-124-089

CHILD PARCEL: 10-00-004-124-091 & -092

STARTING POINT: UNCOMBINATION PER PIROR 20190743232

25-05587-U

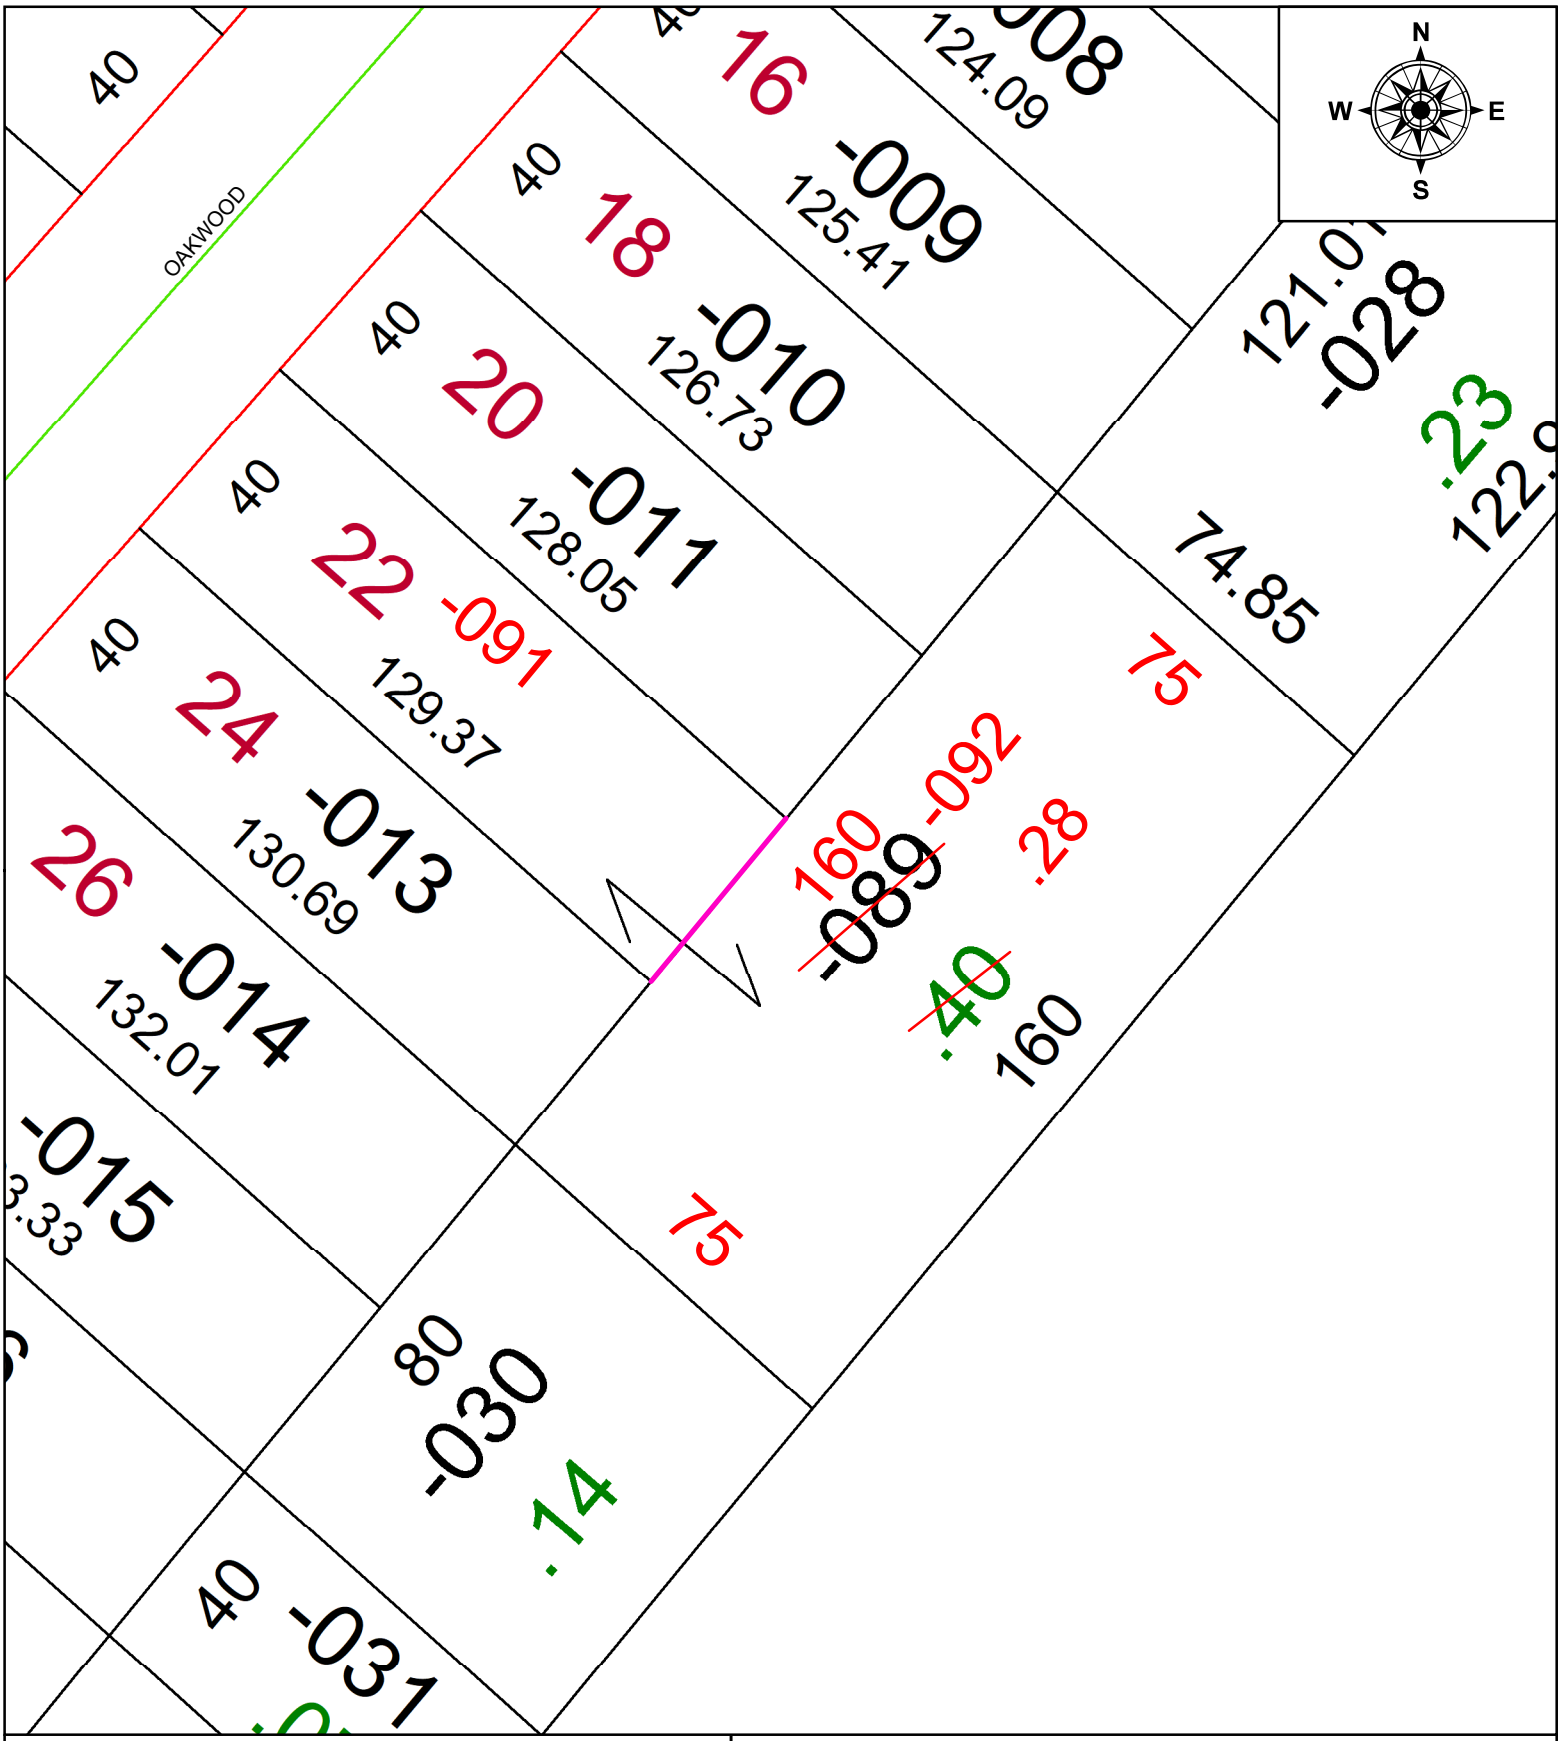

SPLITS/DEEDS PROCESSED

LORAIN COUNTY TAX MAP DEPARTMENT
226 MIDDLE AVE. ELYRIA, OH

SURVEYED BY: N/A **SURVEY #:** N/A

CLOSURE: 1: INF

MAP PAGE(S): 10-00-004

APPOVED BY: BB **DATE:** 9/24/2025

SCALE: 1" = 60' **PRIOR INSTRUMENT:** #20190743232