PARENT PARCEL: 11-00-096-000-022 & -023 (ST 11-00-096-000-021)

CHILD PARCEL: AC CORRECTION PER PIROR 20250052673

STARTING POINT: WESTERLY LINE OF LO 96 AND SW CORNER OF BETTY L. ODONNEL

25-05599-C

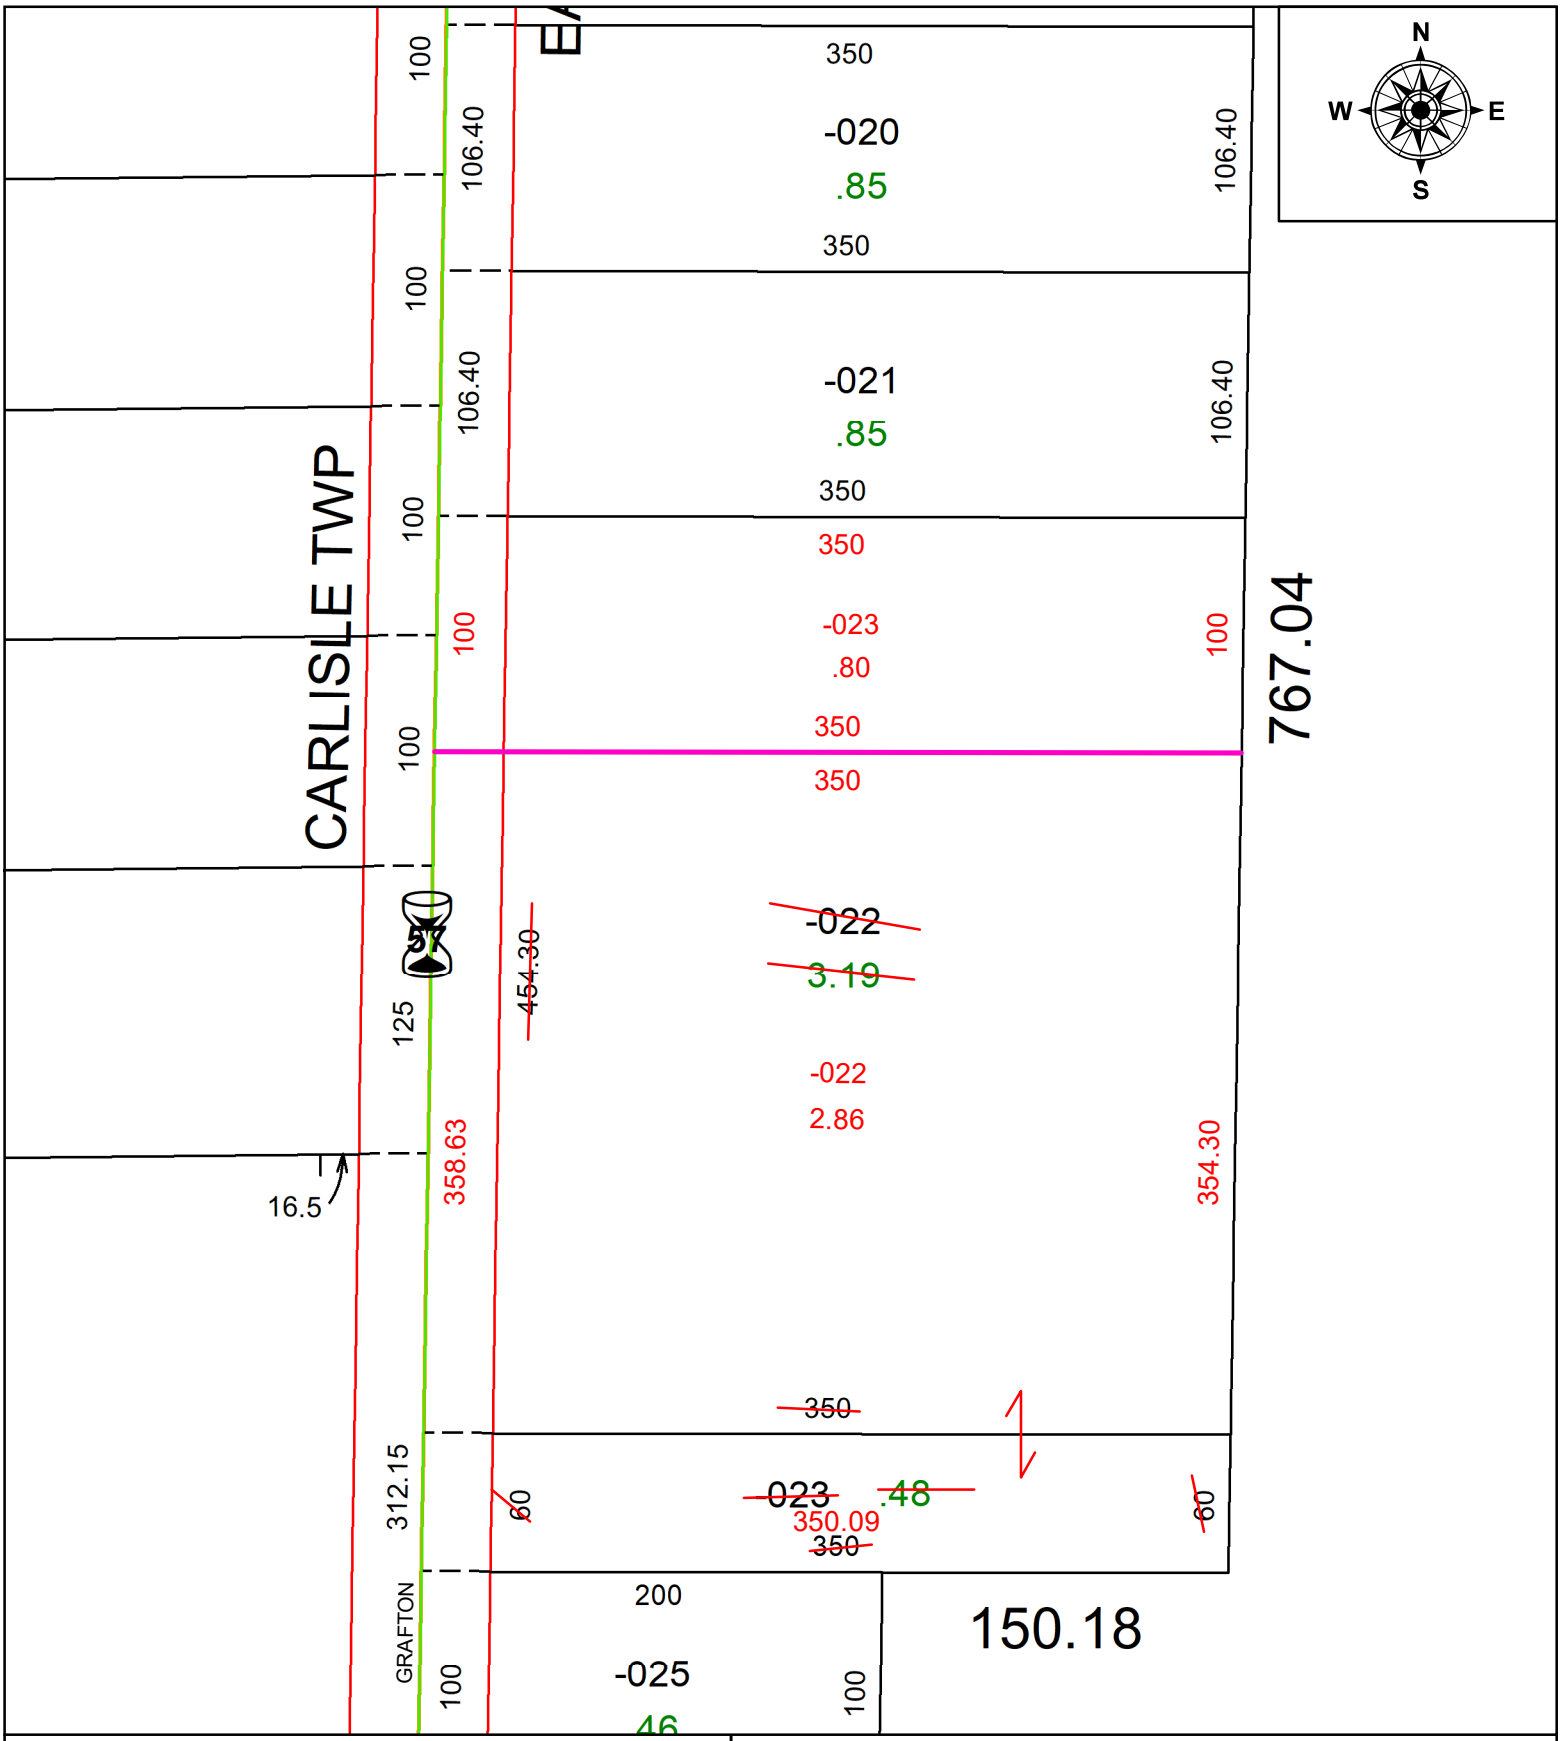

SPLITS/DEEDS PROCESSED

LORAIN COUNTY TAX MAP DEPARTMENT
226 MIDDLE AVE. ELYRIA, OH

SURVEYED BY: N/A **SURVEY #:** N/A
CLOSURE: 1: 630849
MAP PAGE(S): 11-00-096
APPOVED BY: BB **DATE:** 10/9/2025
SCALE: 1" = 120' **PRIOR INSTRUMENT:** #20250052673