PARENT PARCEL: 05-00-002-000-023

CHILD PARCEL: AC CORR PER SURVYEOR ROBBERT M. RUFFING

STARTING POINT: INTERSECTION OF EAGLE CIRCLE AND COOPER FOSTER

25-05624-C

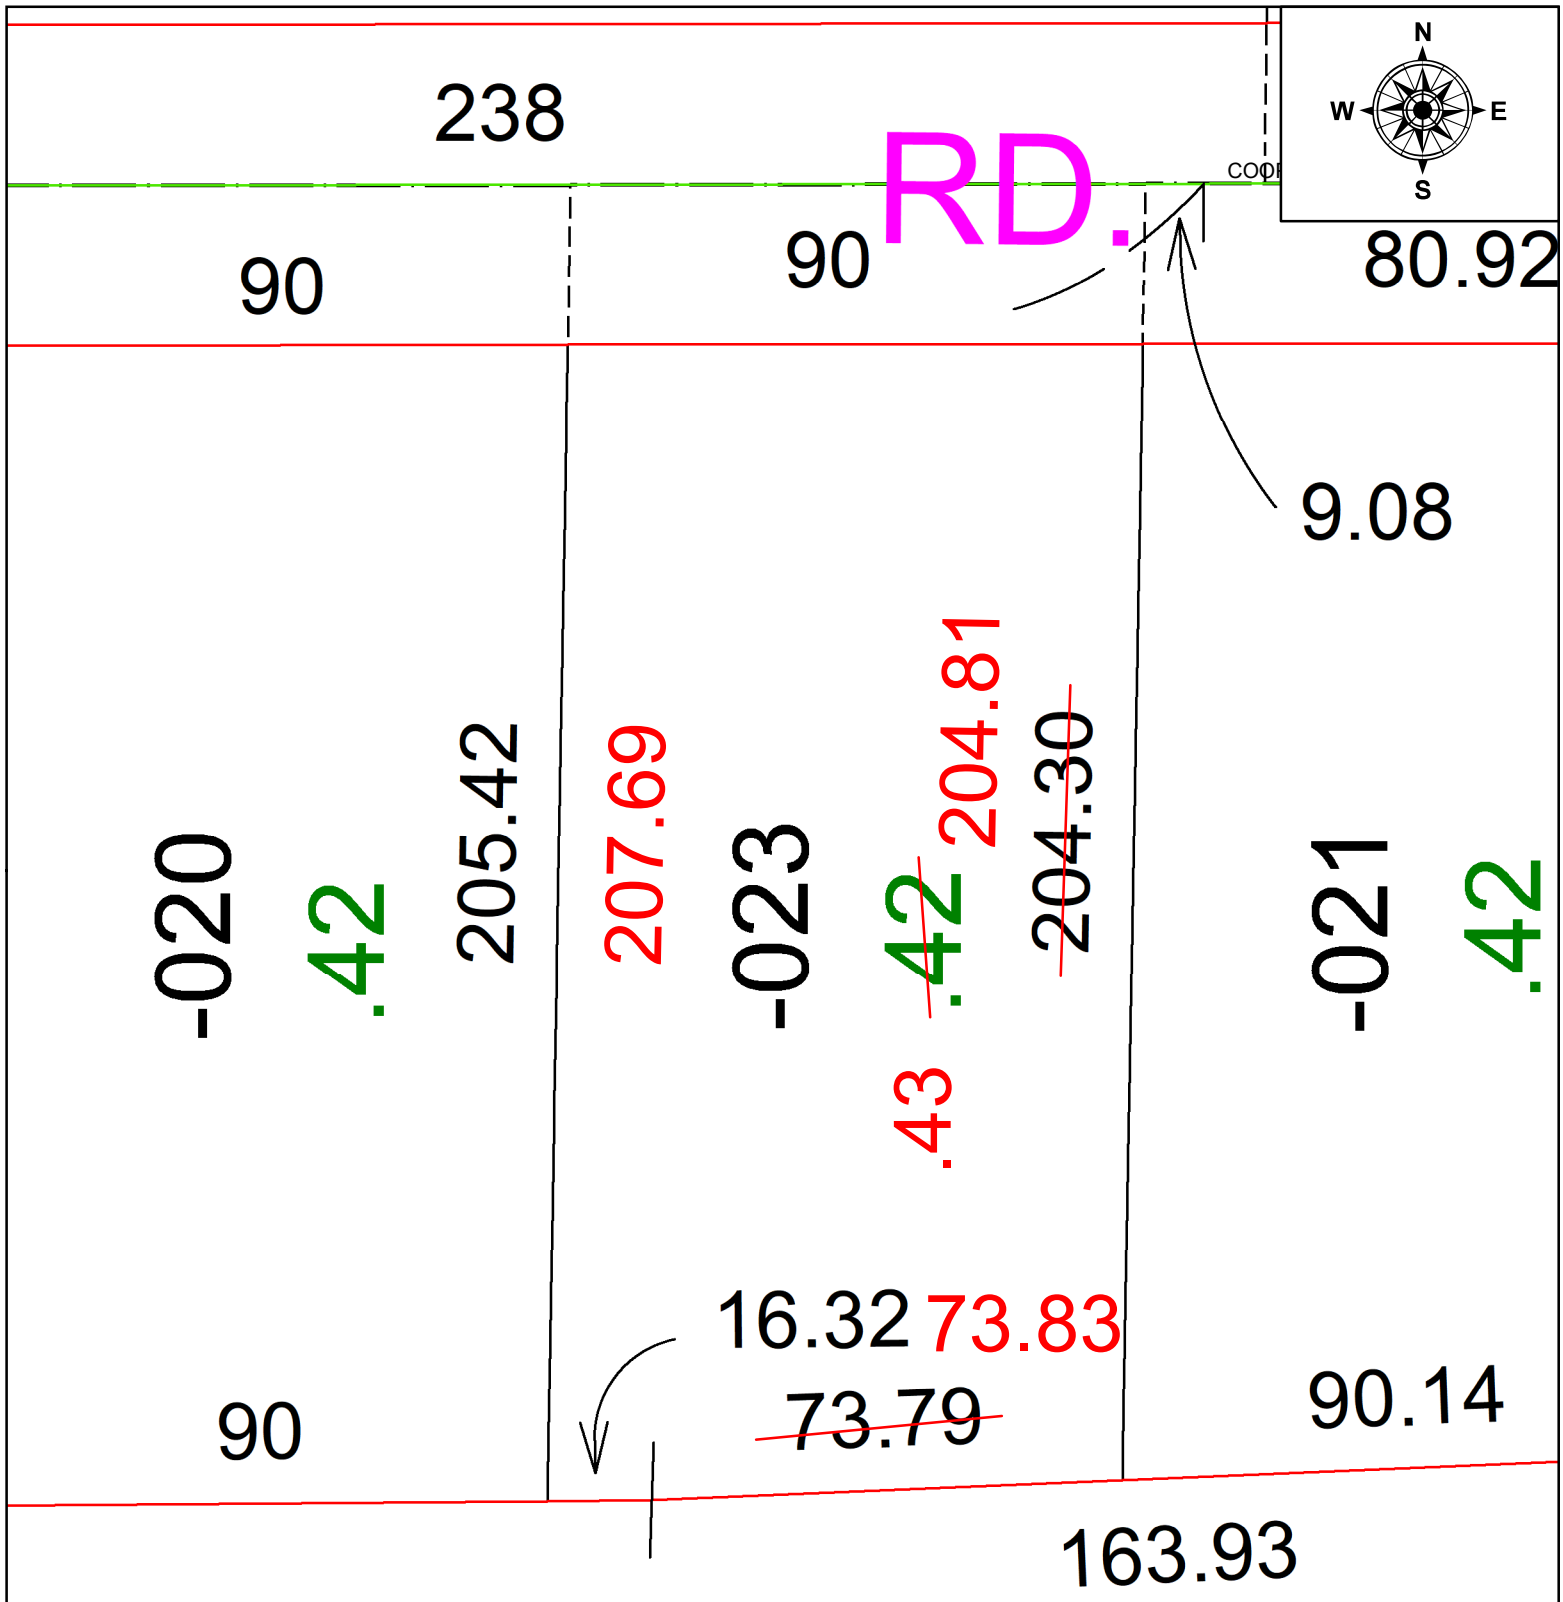

SPLITS/DEEDS PROCESSED

LORAIN COUNTY TAX MAP DEPARTMENT
226 MIDDLE AVE. ELYRIA, OH

SURVEYED BY: ROBBERT M. RUFFING **SURVEY #:** 51597

CLOSURE: INF

MAP PAGE(S): 05-00-002

APPOVED BY: BB **DATE:** 11/18/2025

SCALE: 1" = 30' **PRIOR INSTRUMENT:** #20180685552