PARENT PARCEL: 02-01-003-174-005
CHILD PARCEL: 02-01-003-174-033 & -034
STARTING POINT: UNCOMBINATION PER DEED

25-05625-U

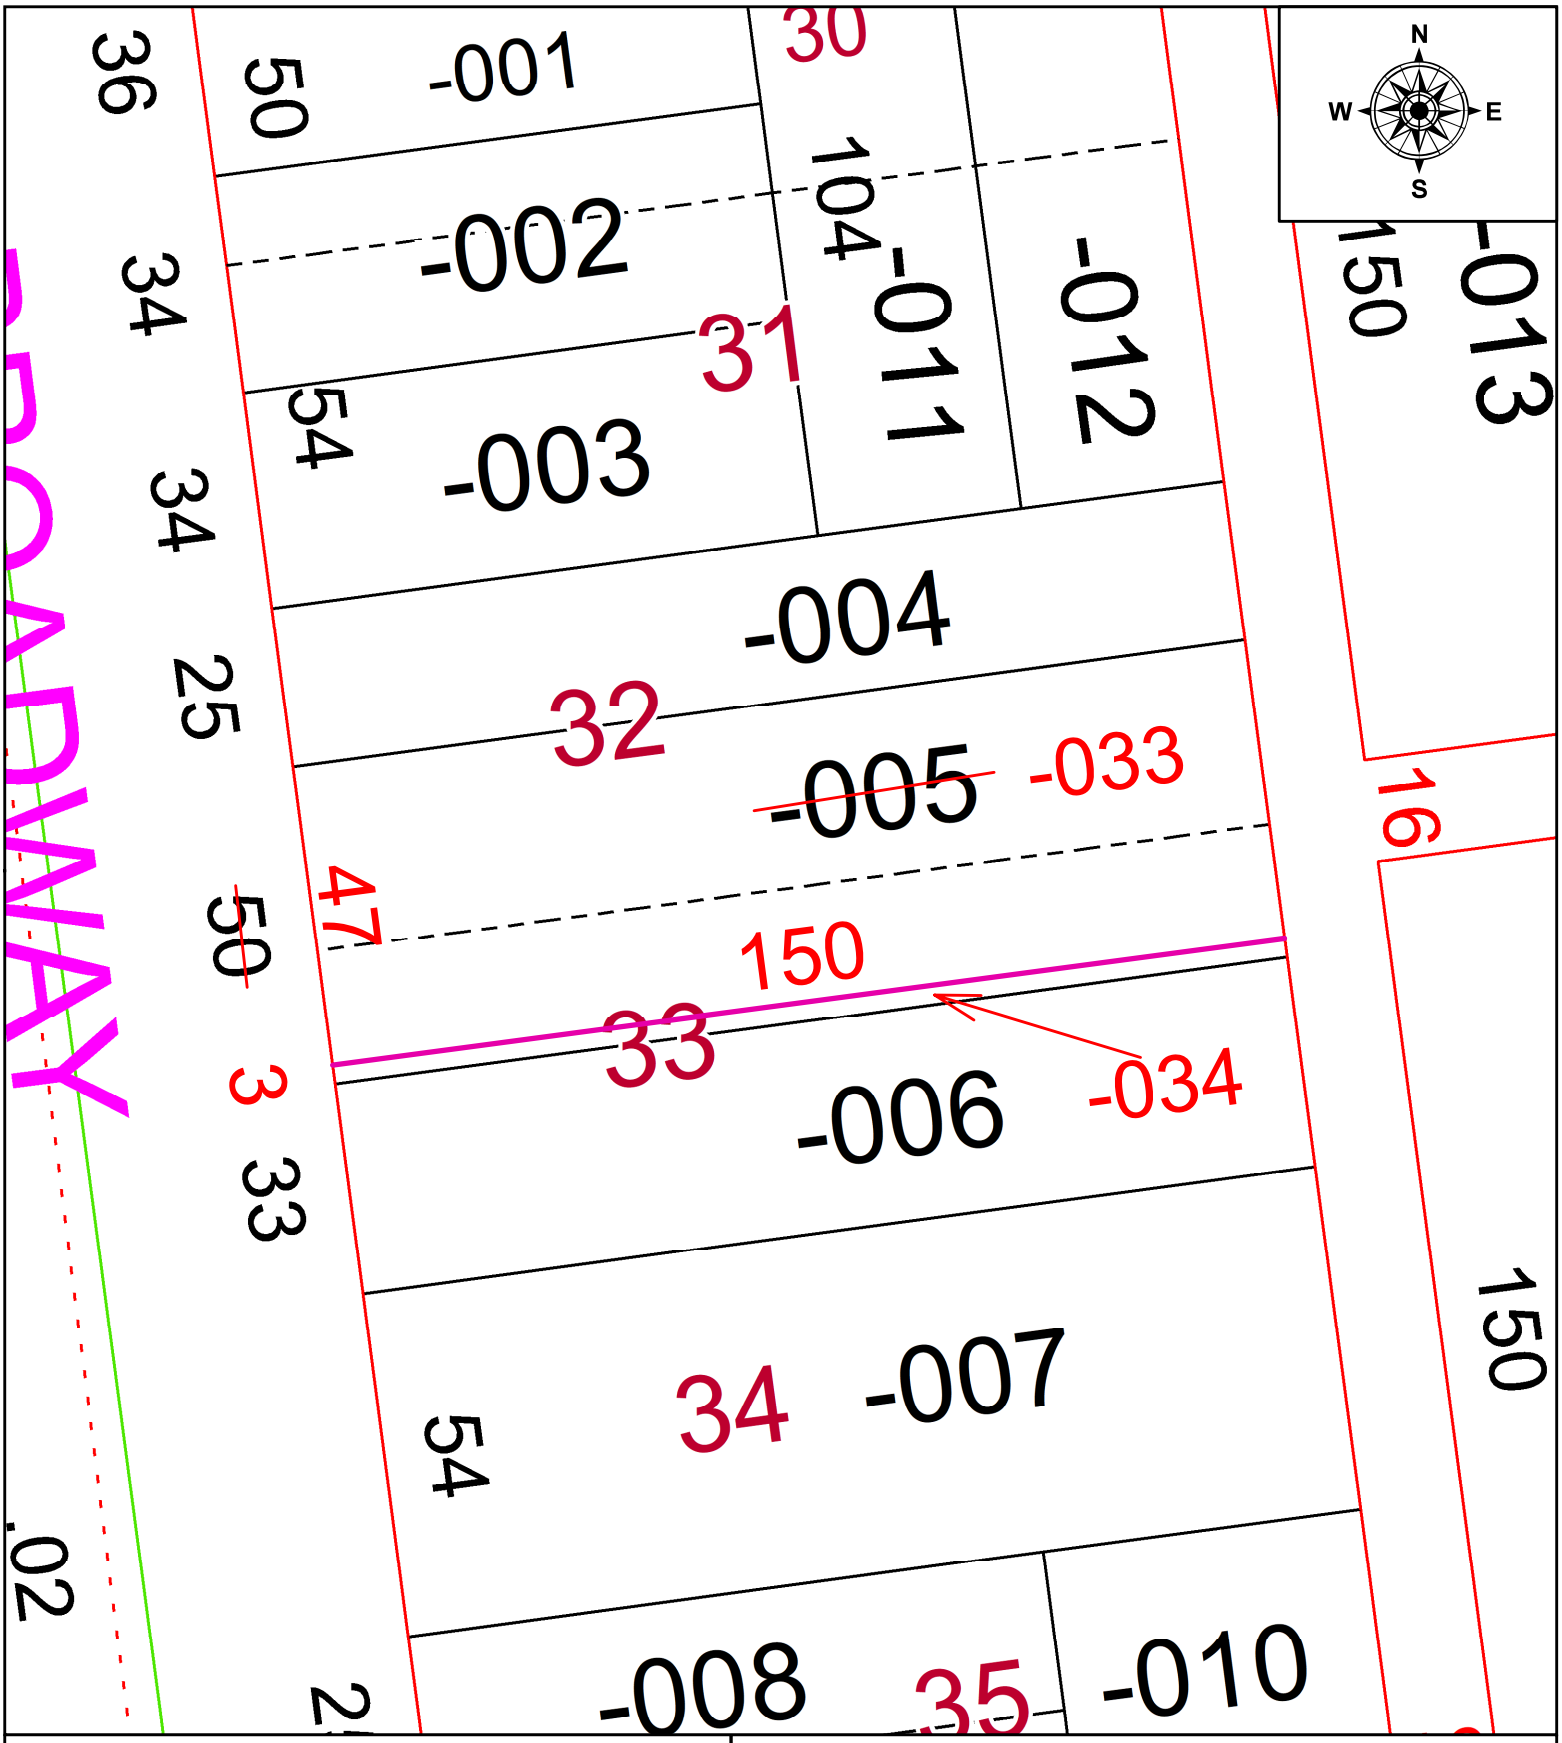

SPLITS/DEEDS PROCESSED
LORAIN COUNTY TAX MAP DEPARTMENT
226 MIDDLE AVE. ELYRIA, OH

SURVEYED BY: N/A **SURV # N/A**
CLOSURE: 1: N/A
MAP PAGE(S): 02-01-003
APPOVED BY: AC **DATE:** November 19, 2025
SCALE: 1 in = 30 ft **PRIOR INSTRUMENT:** 2023- 0935784