PARENT PARCEL: 06-24-108-000-011

CHILD PARCEL: AC CORR PER SURV BY THOMAS A. SIMON

STARTING POINT: C/L OF FRENCH CREEK AND ABBE RD

25-05641-C

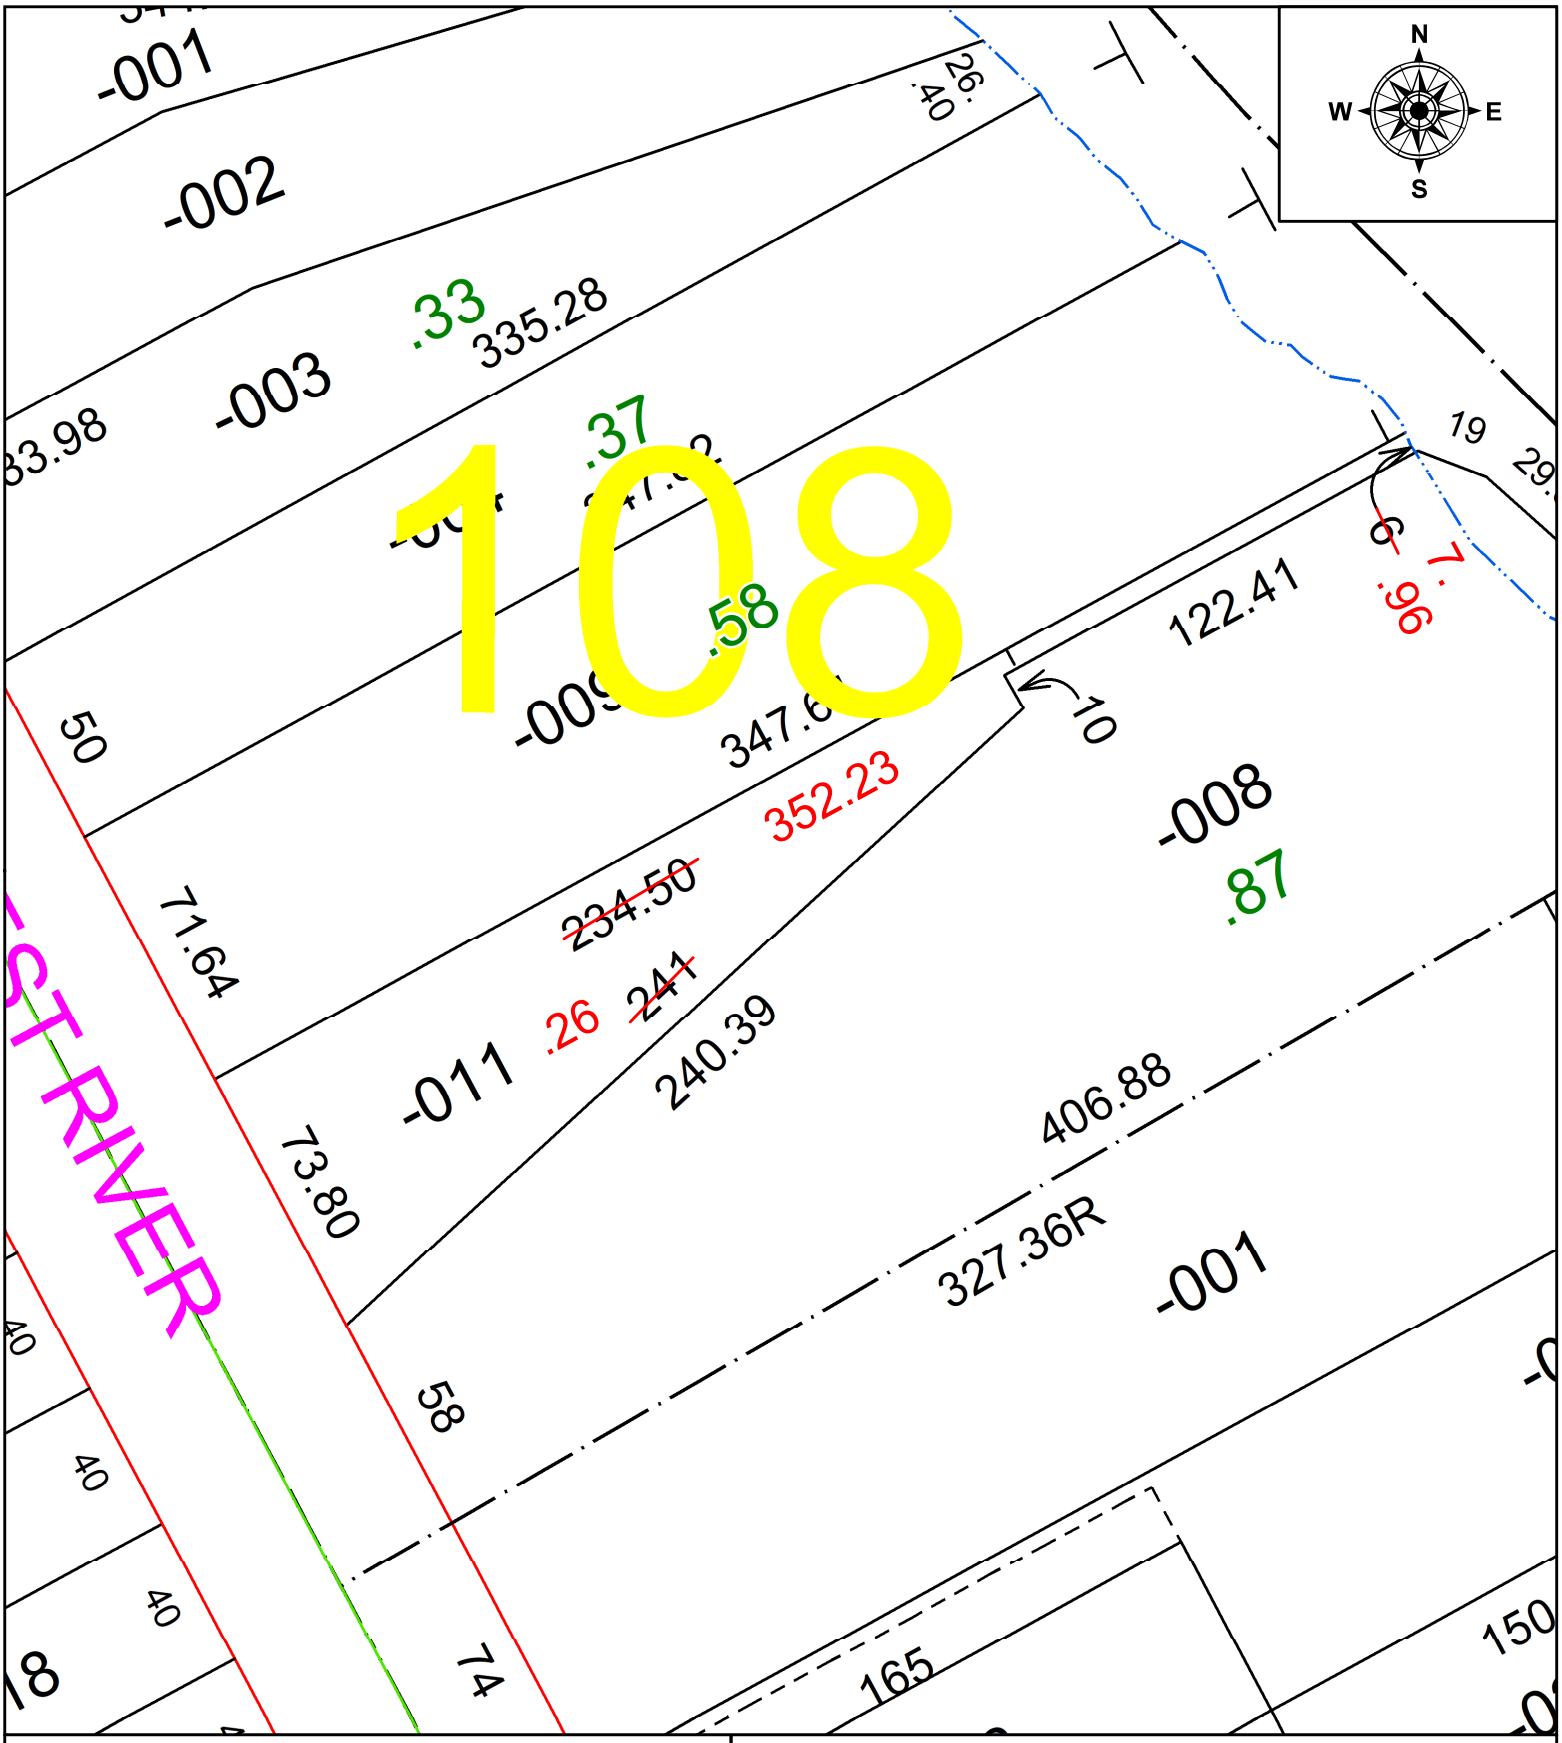

SPLITS/DEEDS PROCESSED

LORAIN COUNTY TAX MAP DEPARTMENT
226 MIDDLE AVE. ELYRIA, OH

SURVEYED BY: SEAN A. BOLAND **SURV # 51625**

CLOSURE: 1: 469306

MAP PAGE(S): 06-24

APPOVED BY: AC **DATE:** December 22, 2025

SCALE: 1 in = 50 ft **PRIOR INSTRUMENT:** 2023- 0915189