PARENT PARCEL: 16-00-001-108-028

CHILD PARCEL: AC CORR PER SURVEYOR THOMAS JAMES KING JR

STARTING POINT: SOUTHWEST CORNER OF S/L 161 IN RAWSONVILLE PV 1/23

25-05643-C

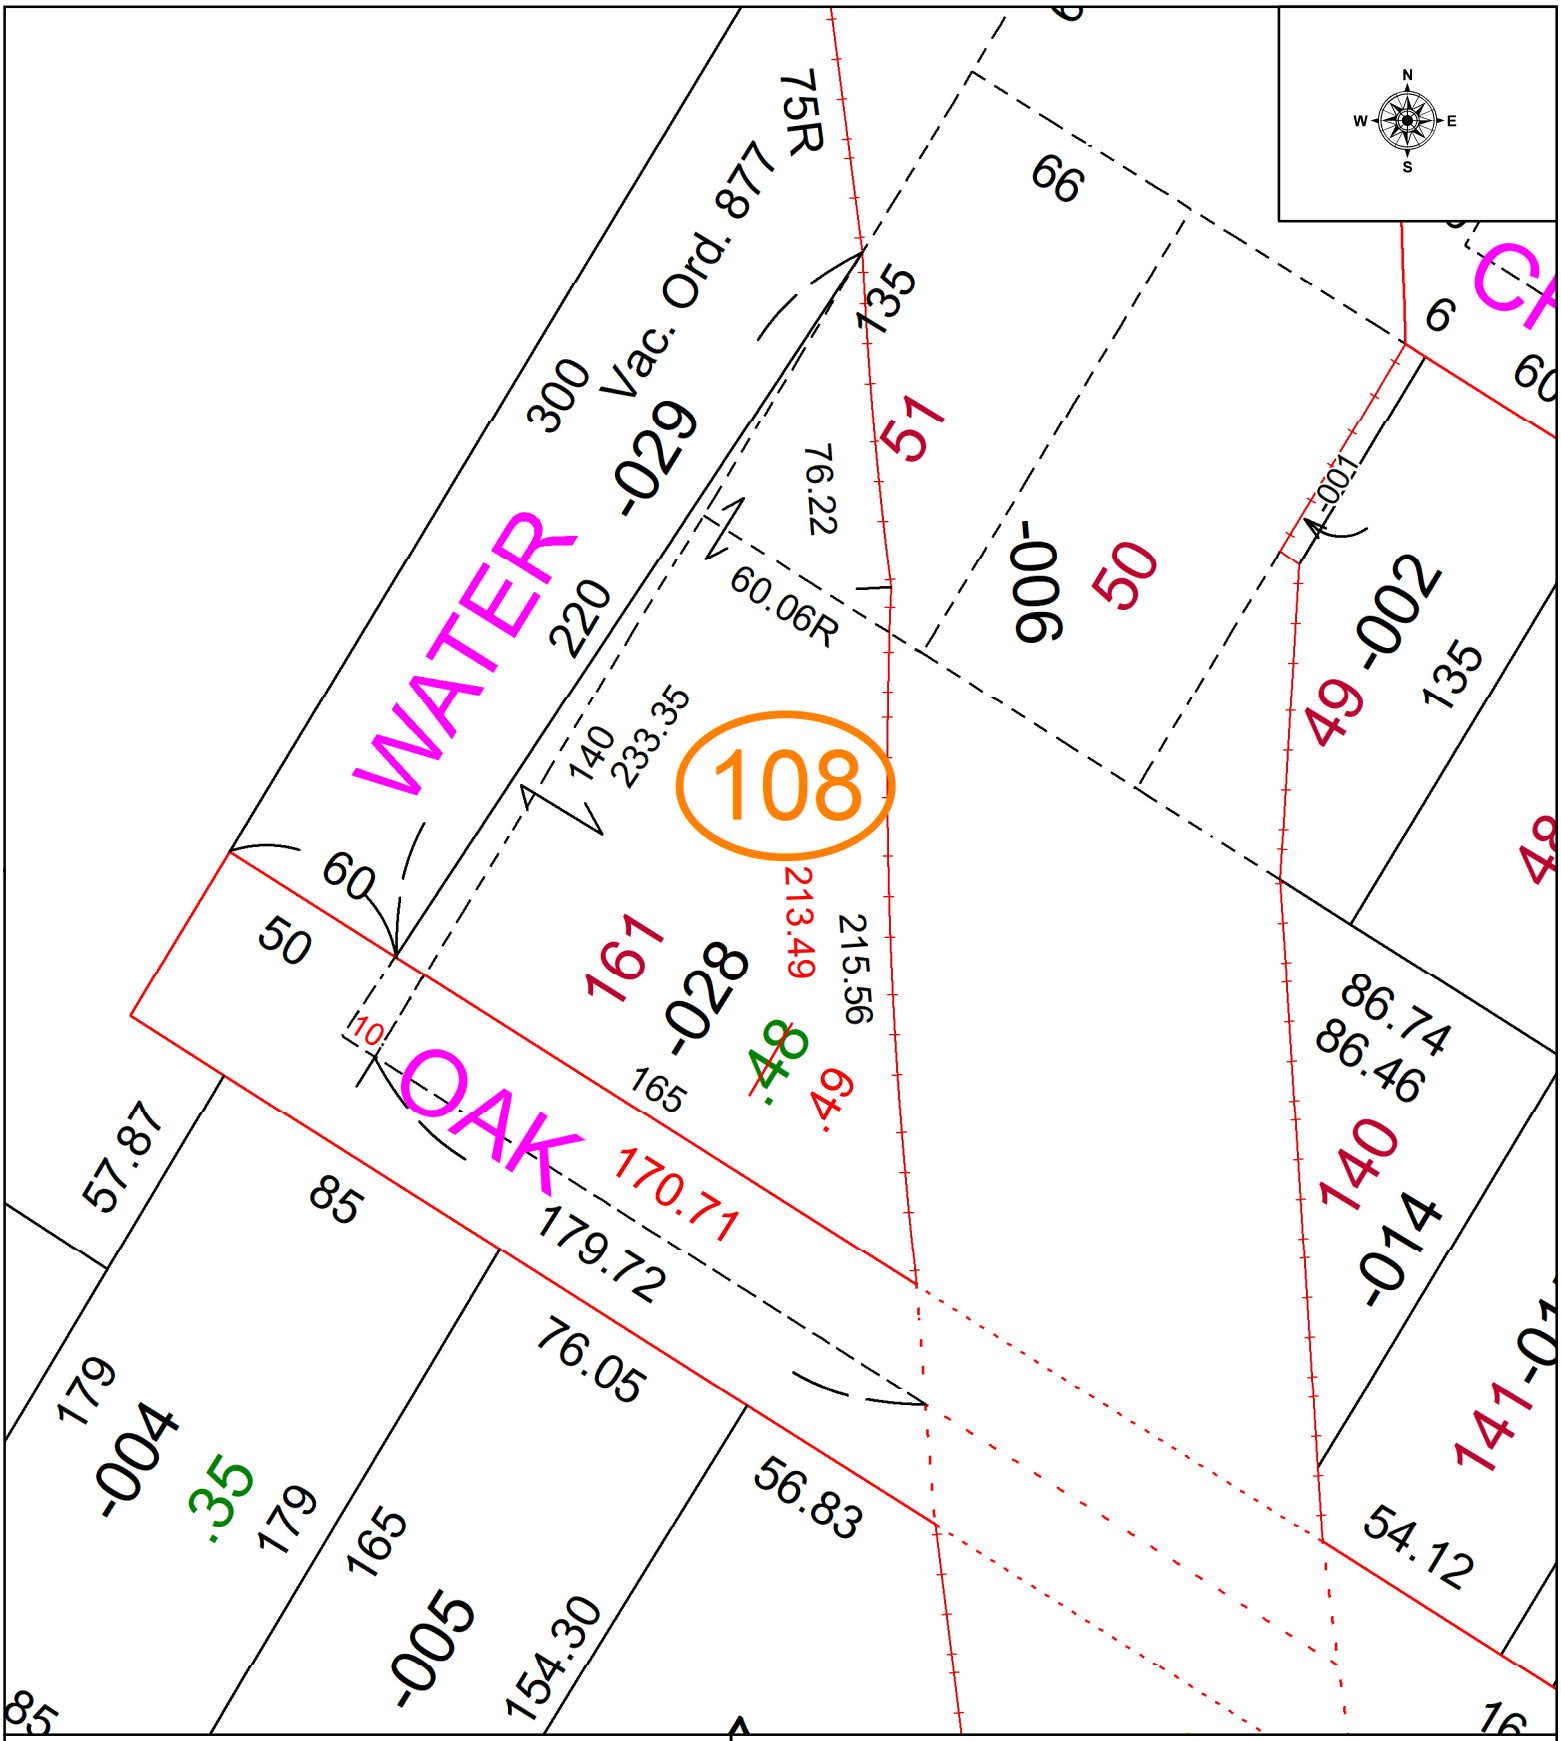

SPLITS/DEEDS PROCESSED

LORAIN COUNTY TAX MAP DEPARTMENT
226 MIDDLE AVE. ELYRIA, OH

SURVEYED BY: THOMAS JAMES KING JR

SURVEY # 51627

CLOSURE: 1: 128806

MAP PAGE(S): 16-00-001

APPOVED BY: WRZ **DATE:** 12/23/2025

SCALE: 1" = 50 **PRIOR INSTRUMENT:** #2000-0672827