PARENT PARCEL: 04-00-030-103-021

CHILD PARCEL: FR & DPTH TO AC CORR PER SURVEYOR STAN LOCH

STARTING POINT: INTERSECTION OF C/LS OF LAKE RD & WESTWIND DR

26-05649-C

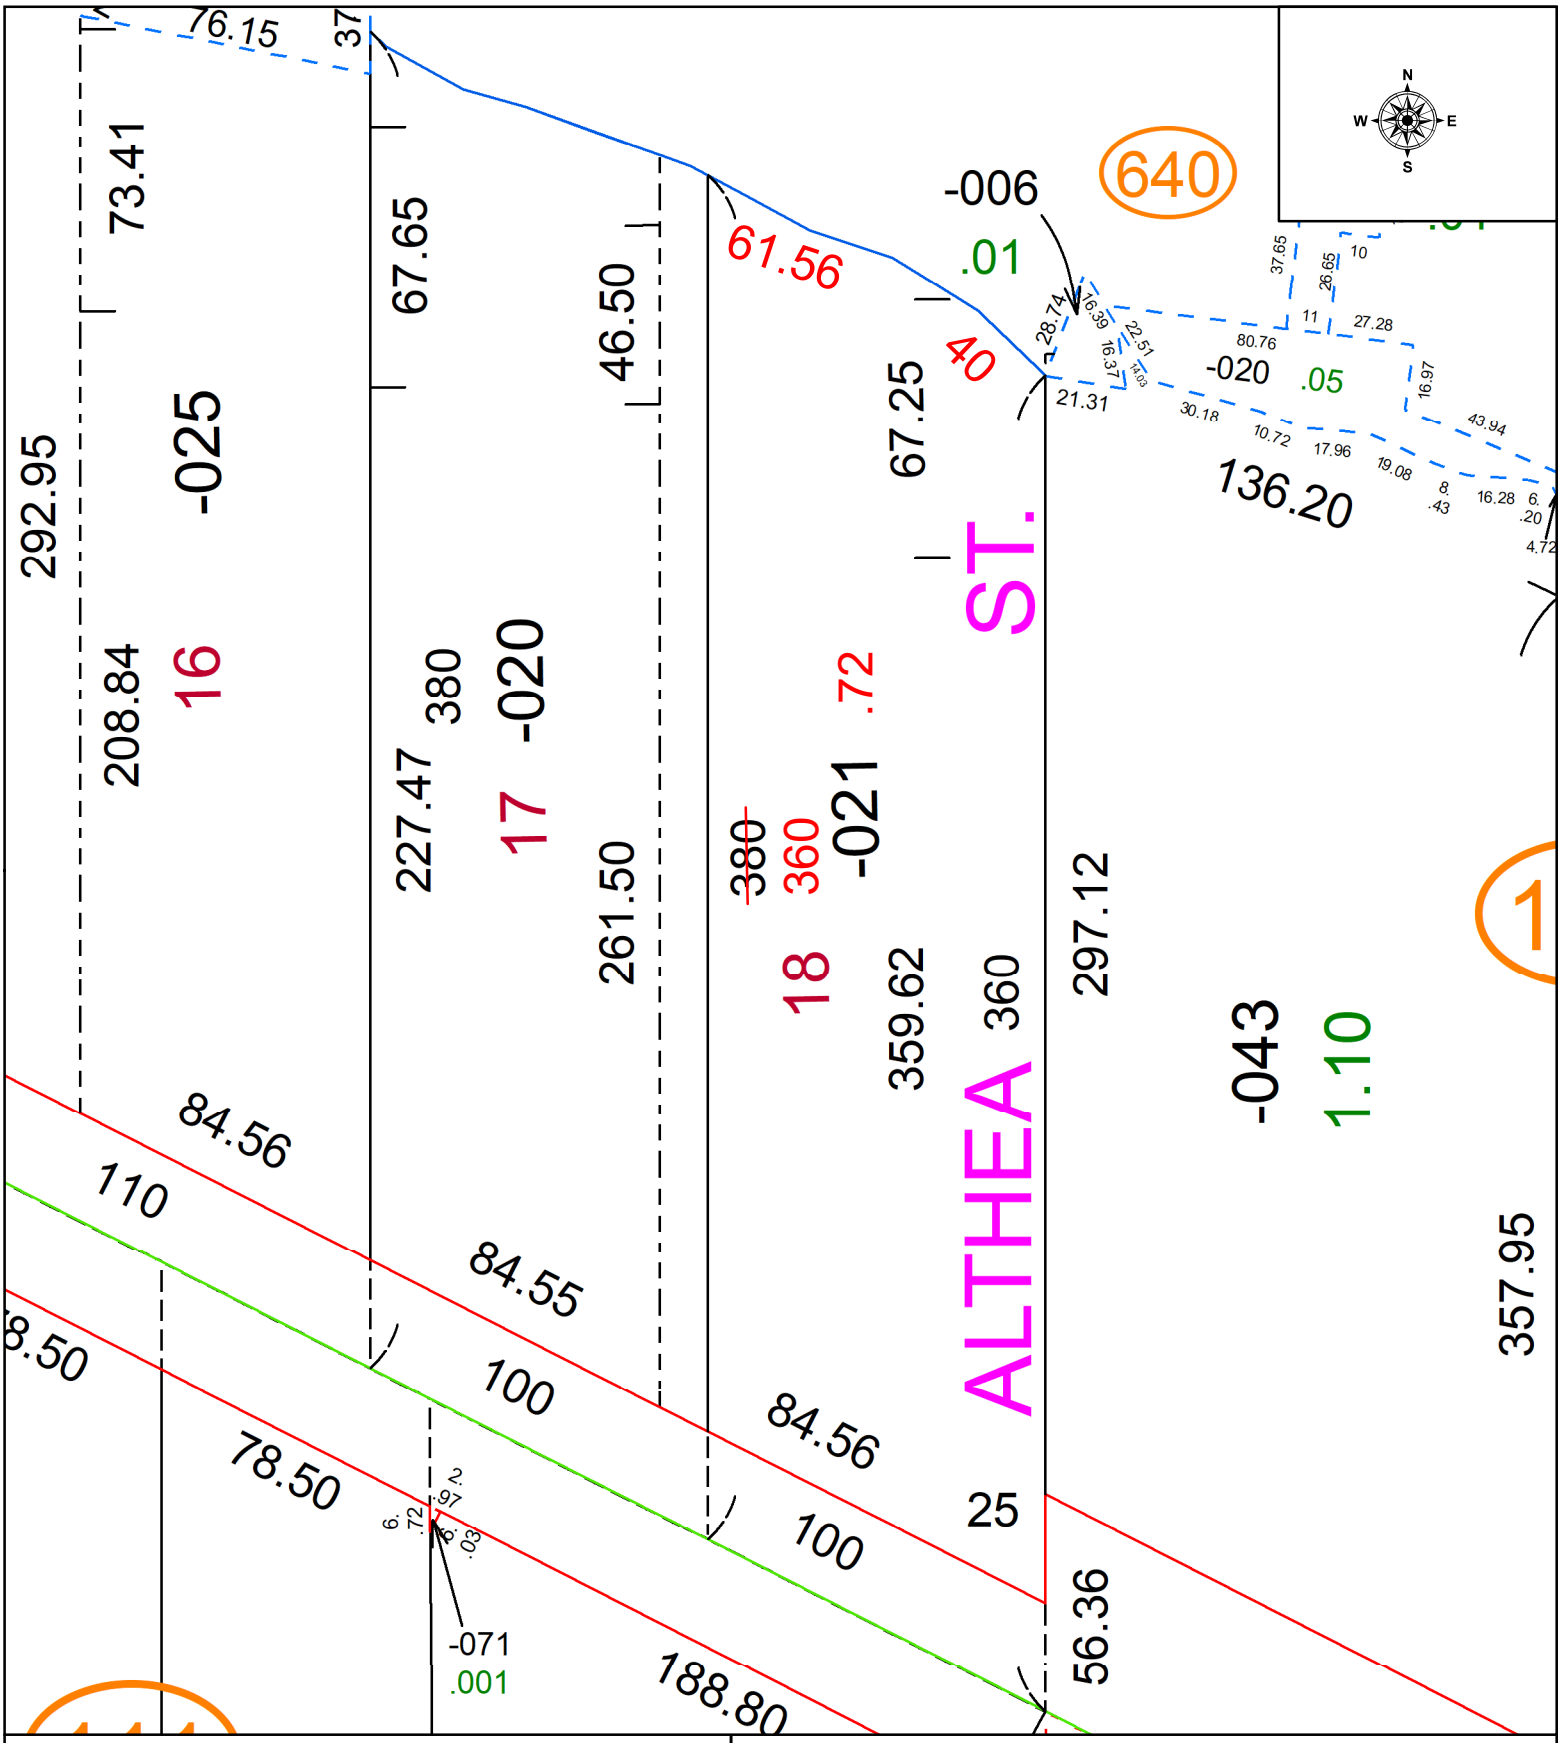

SPLITS/DEEDS PROCESSED

LORAIN COUNTY TAX MAP DEPARTMENT
226 MIDDLE AVE. ELYRIA, OH

SURVEYED BY: STAN LOCH

SURVEY # 51634

CLOSURE: 1: 301464

MAP PAGE(S): 04-00-030

APPOVED BY: WRZ **DATE:** 1/6/2026

SCALE: 1" = 50 **PRIOR INSTRUMENT:** #2024-0002528