PARENT PARCEL: 07-00-017-130-030(S.T.), 07-00-008-116-003(S.T.), 07-00-009-101-001, -060, -083, & 07-00-016-112-030(S.T.)

CHILD PARCEL: 07-00-009-101-097 AC CORR & COMBO PER PRIOR DEED #2021-0854568

STARTING POINT: INTERSECTION OF C/L CENTER RIDGE RD & EAST LINE OF O.L. 17

26-05649-C

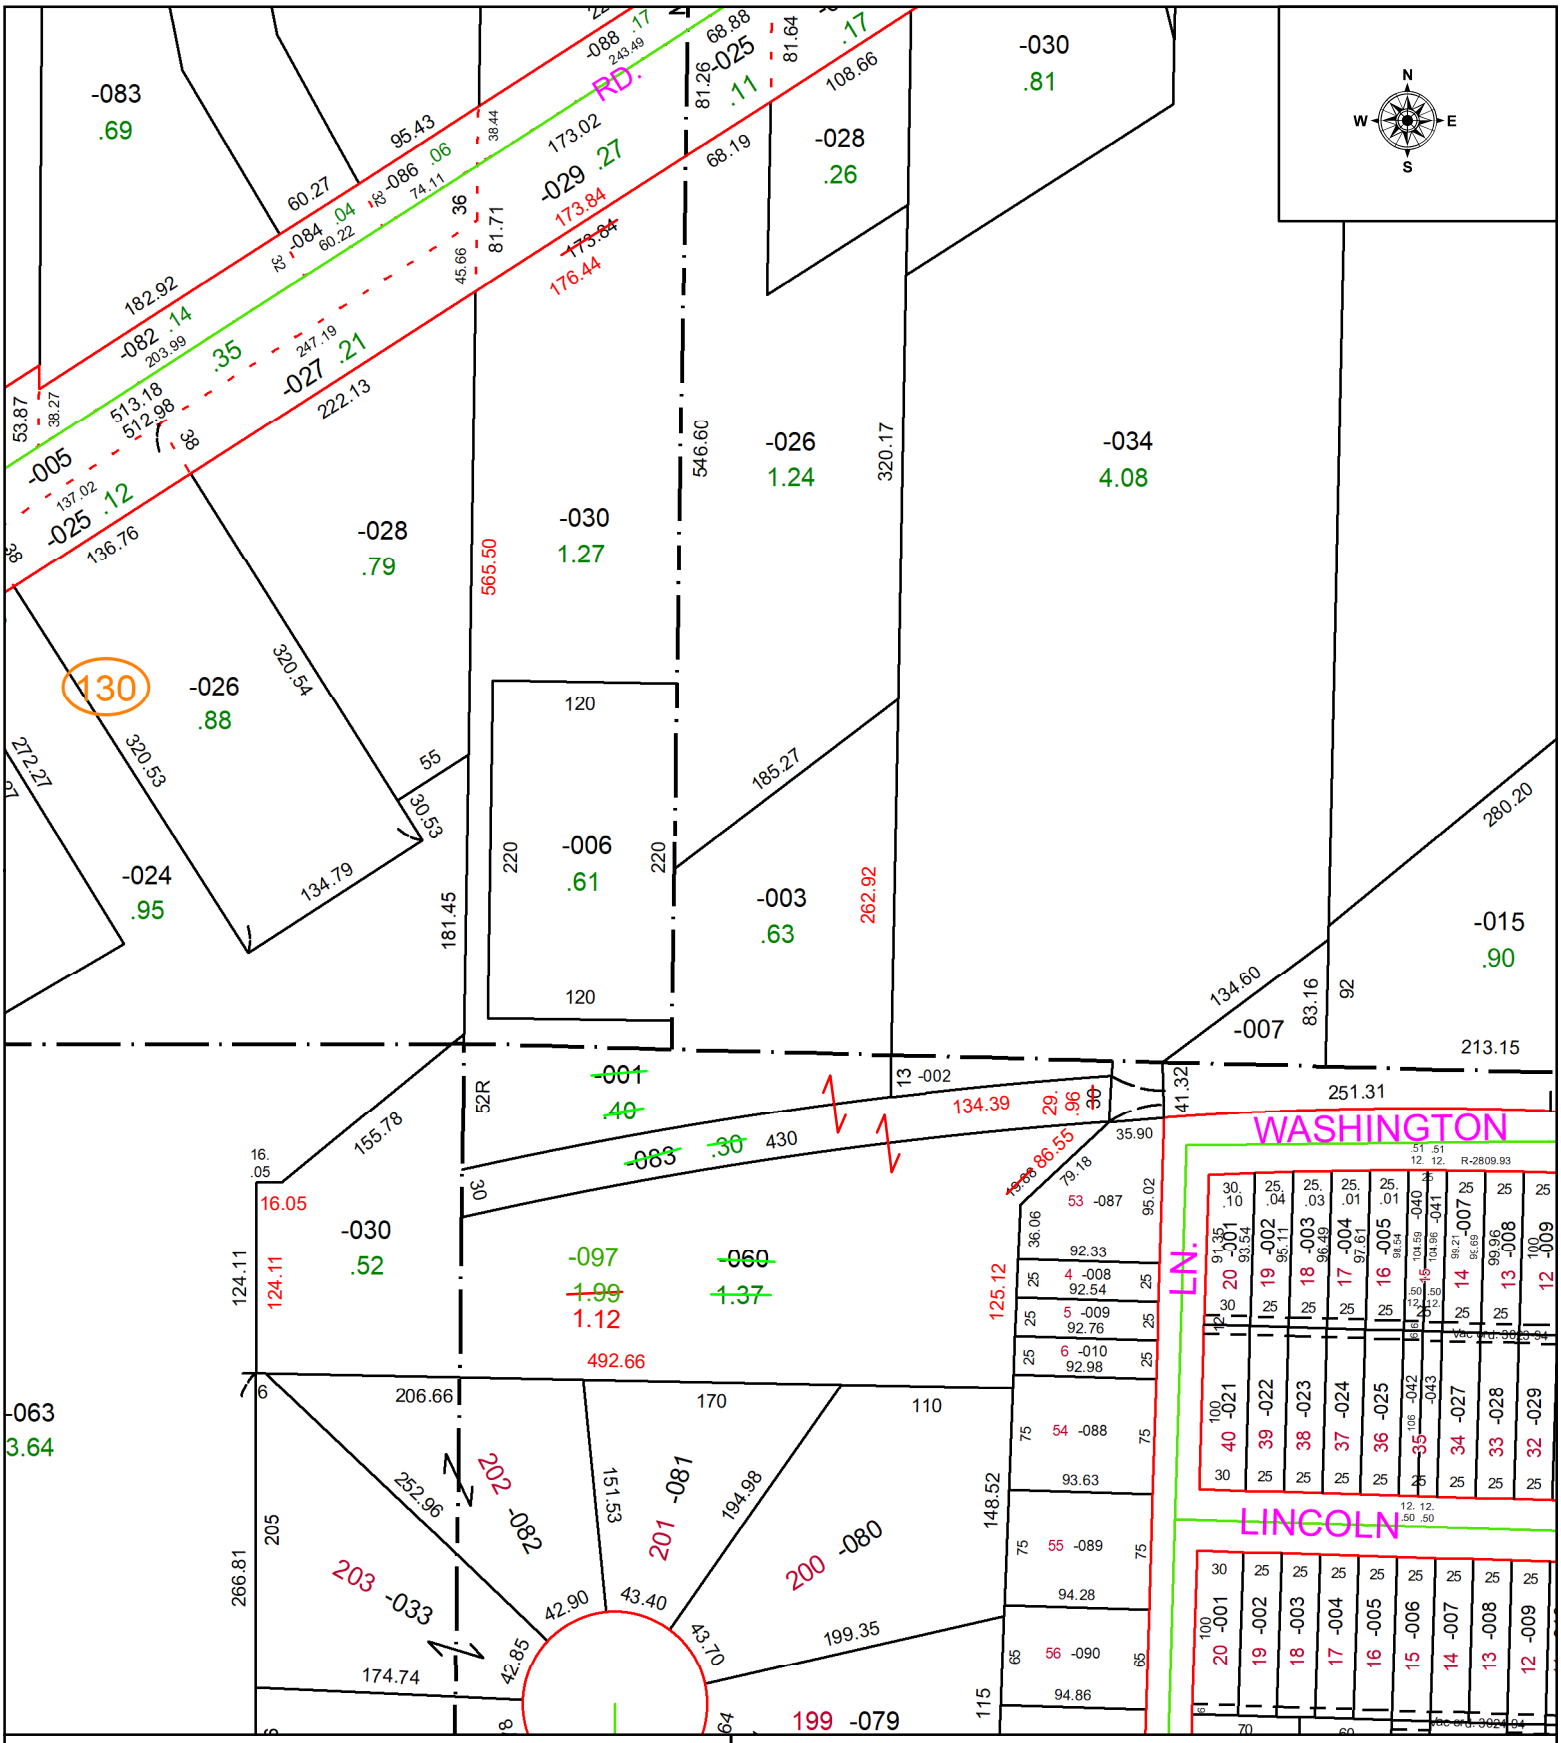
N
S
E
W
RD.
WASHINGTON
LN.
LINCOLN
130
-083 .69
-030 .81
-028 .26
-029 .27
-026 1.24
-034 4.08
-028 .79
-030 1.27
-026 .88
-024 .95
-006 .61
-003 .63
-015 .90
-007
-001 .40
-083 .30
-097 1.99 1.12
-060 1.37
-030 .52
-063 3.64
-087
-088
-089
-090
-079
-080
-081
-082
-033
-002
-008
-009
-010
-025
-027
-028
-029
-032
-033
-034
-035
-040
-041
-042
-043
-001
-002
-003
-004
-005
-006
-007
-008
-009
