PARENT PARCEL: 05-00-038-102-003

CHILD PARCEL: AC CORR PER SURVEYOR THOMAS SIMON

STARTING POINT: NORTHWESTERLY CORNER OF S/L 1 IN WOODHILL ACRES NO. 1 PV 20/15A

26-05652-C

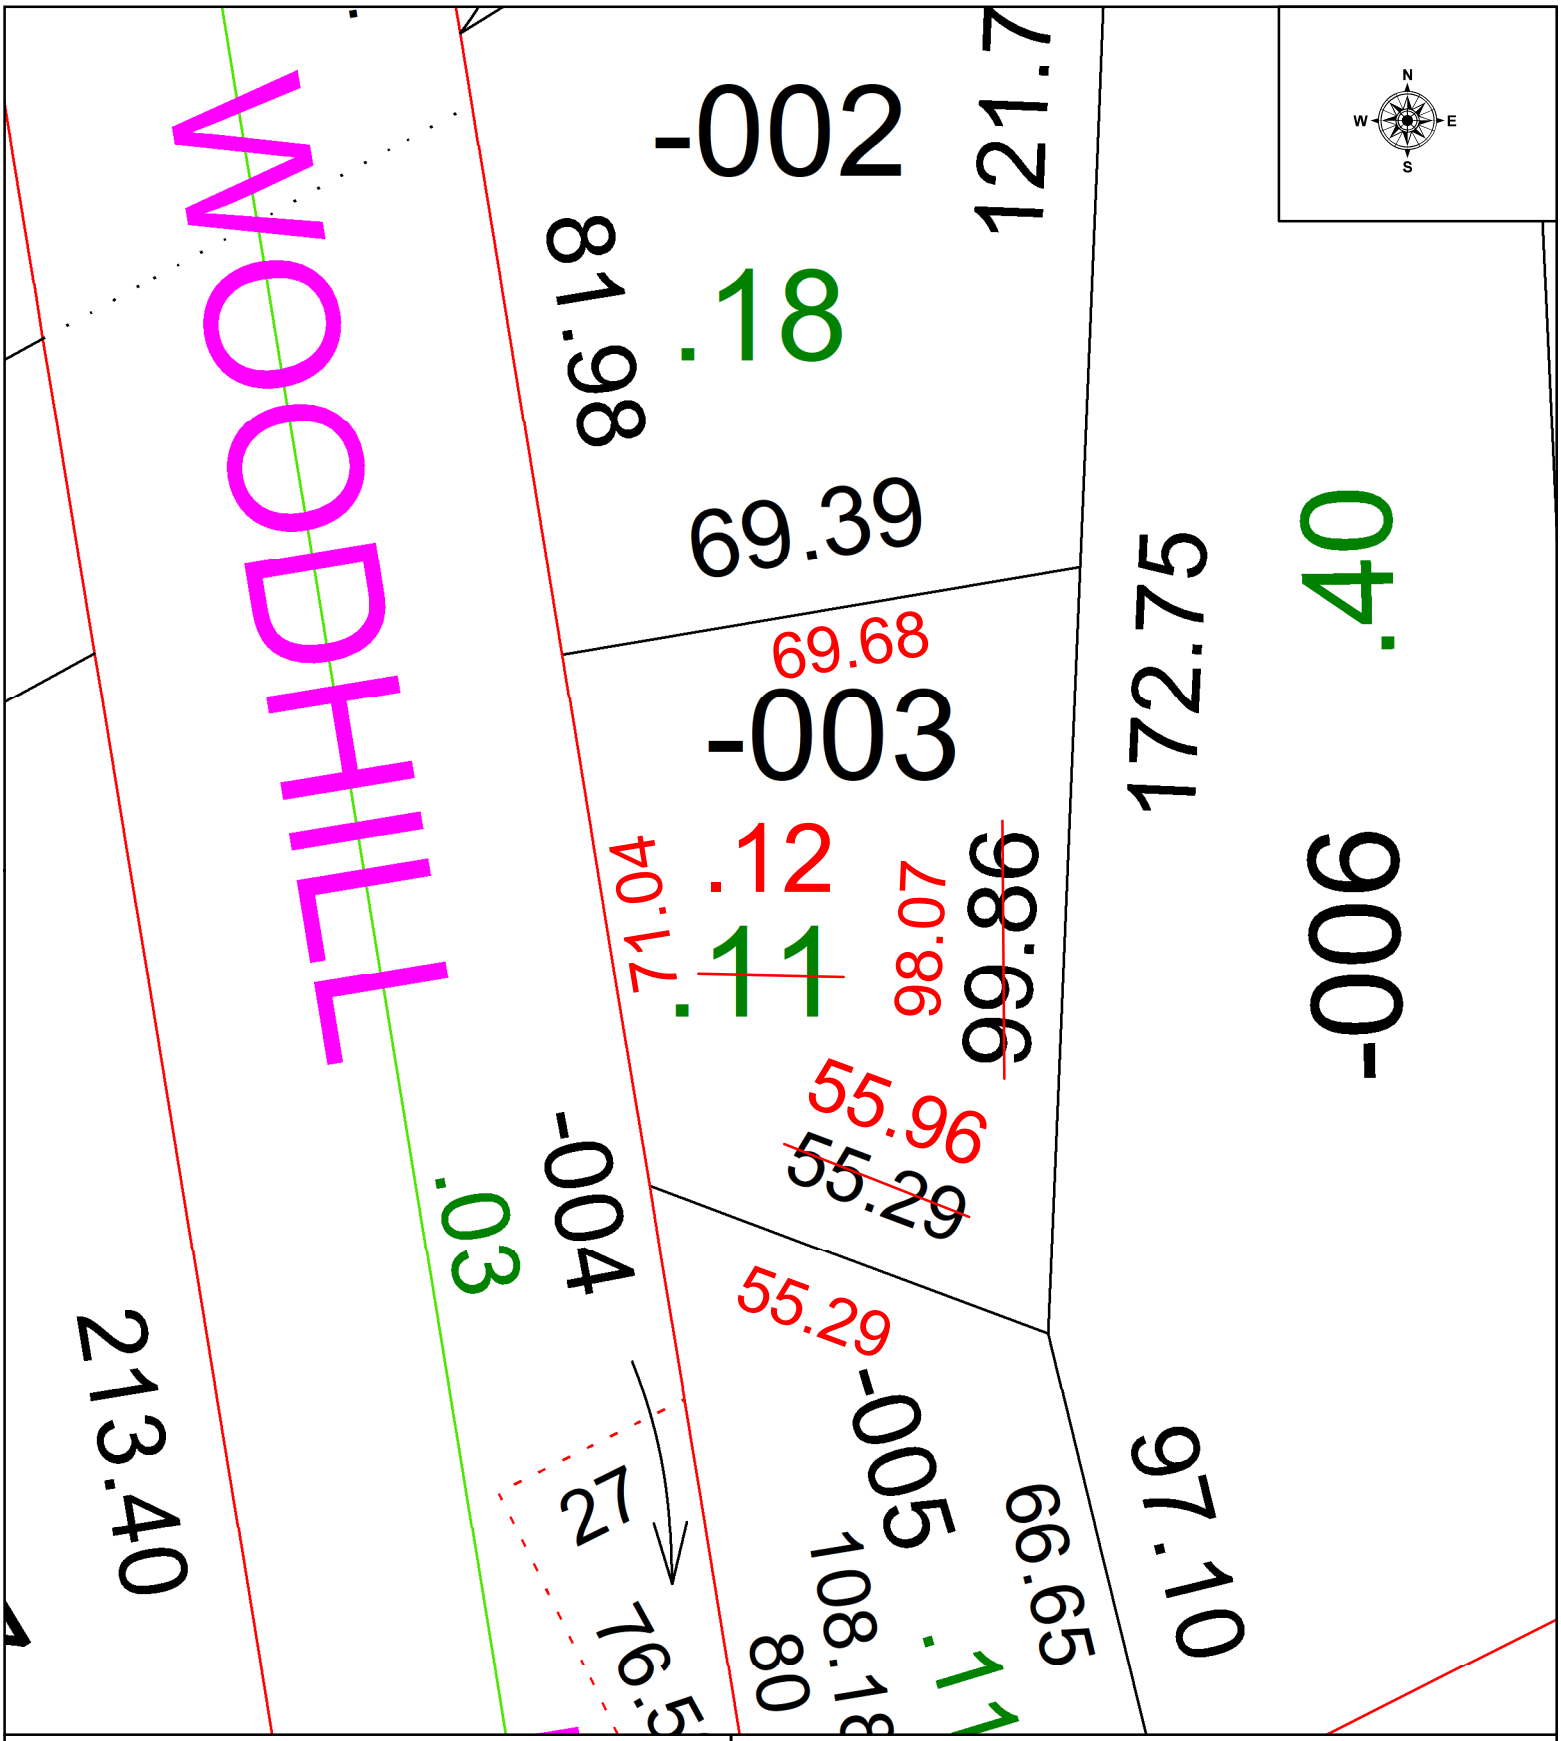

SPLITS/DEEDS PROCESSED

LORAIN COUNTY TAX MAP DEPARTMENT
226 MIDDLE AVE. ELYRIA, OH

SURVEYED BY: THOMAS SIMON

SURVEY # 51640

CLOSURE: !: 148386

MAP PAGE(S): 05-00-038

APPOVED BY: WRZ **DATE:** 1/20/2026

SCALE: 1" = 25 **PRIOR INSTRUMENT:** #2022-0897467