PARENT PARCEL: 03-00-113-108-026

CHILD PARCEL: AC CORR PER SURVEYOR ROBERT RUFFING

STARTING POINT: SOUTHWESTERLY CORNER OF S/L 75 OF HILL'S ALLOTMENT PV 22/7

26-05659-C

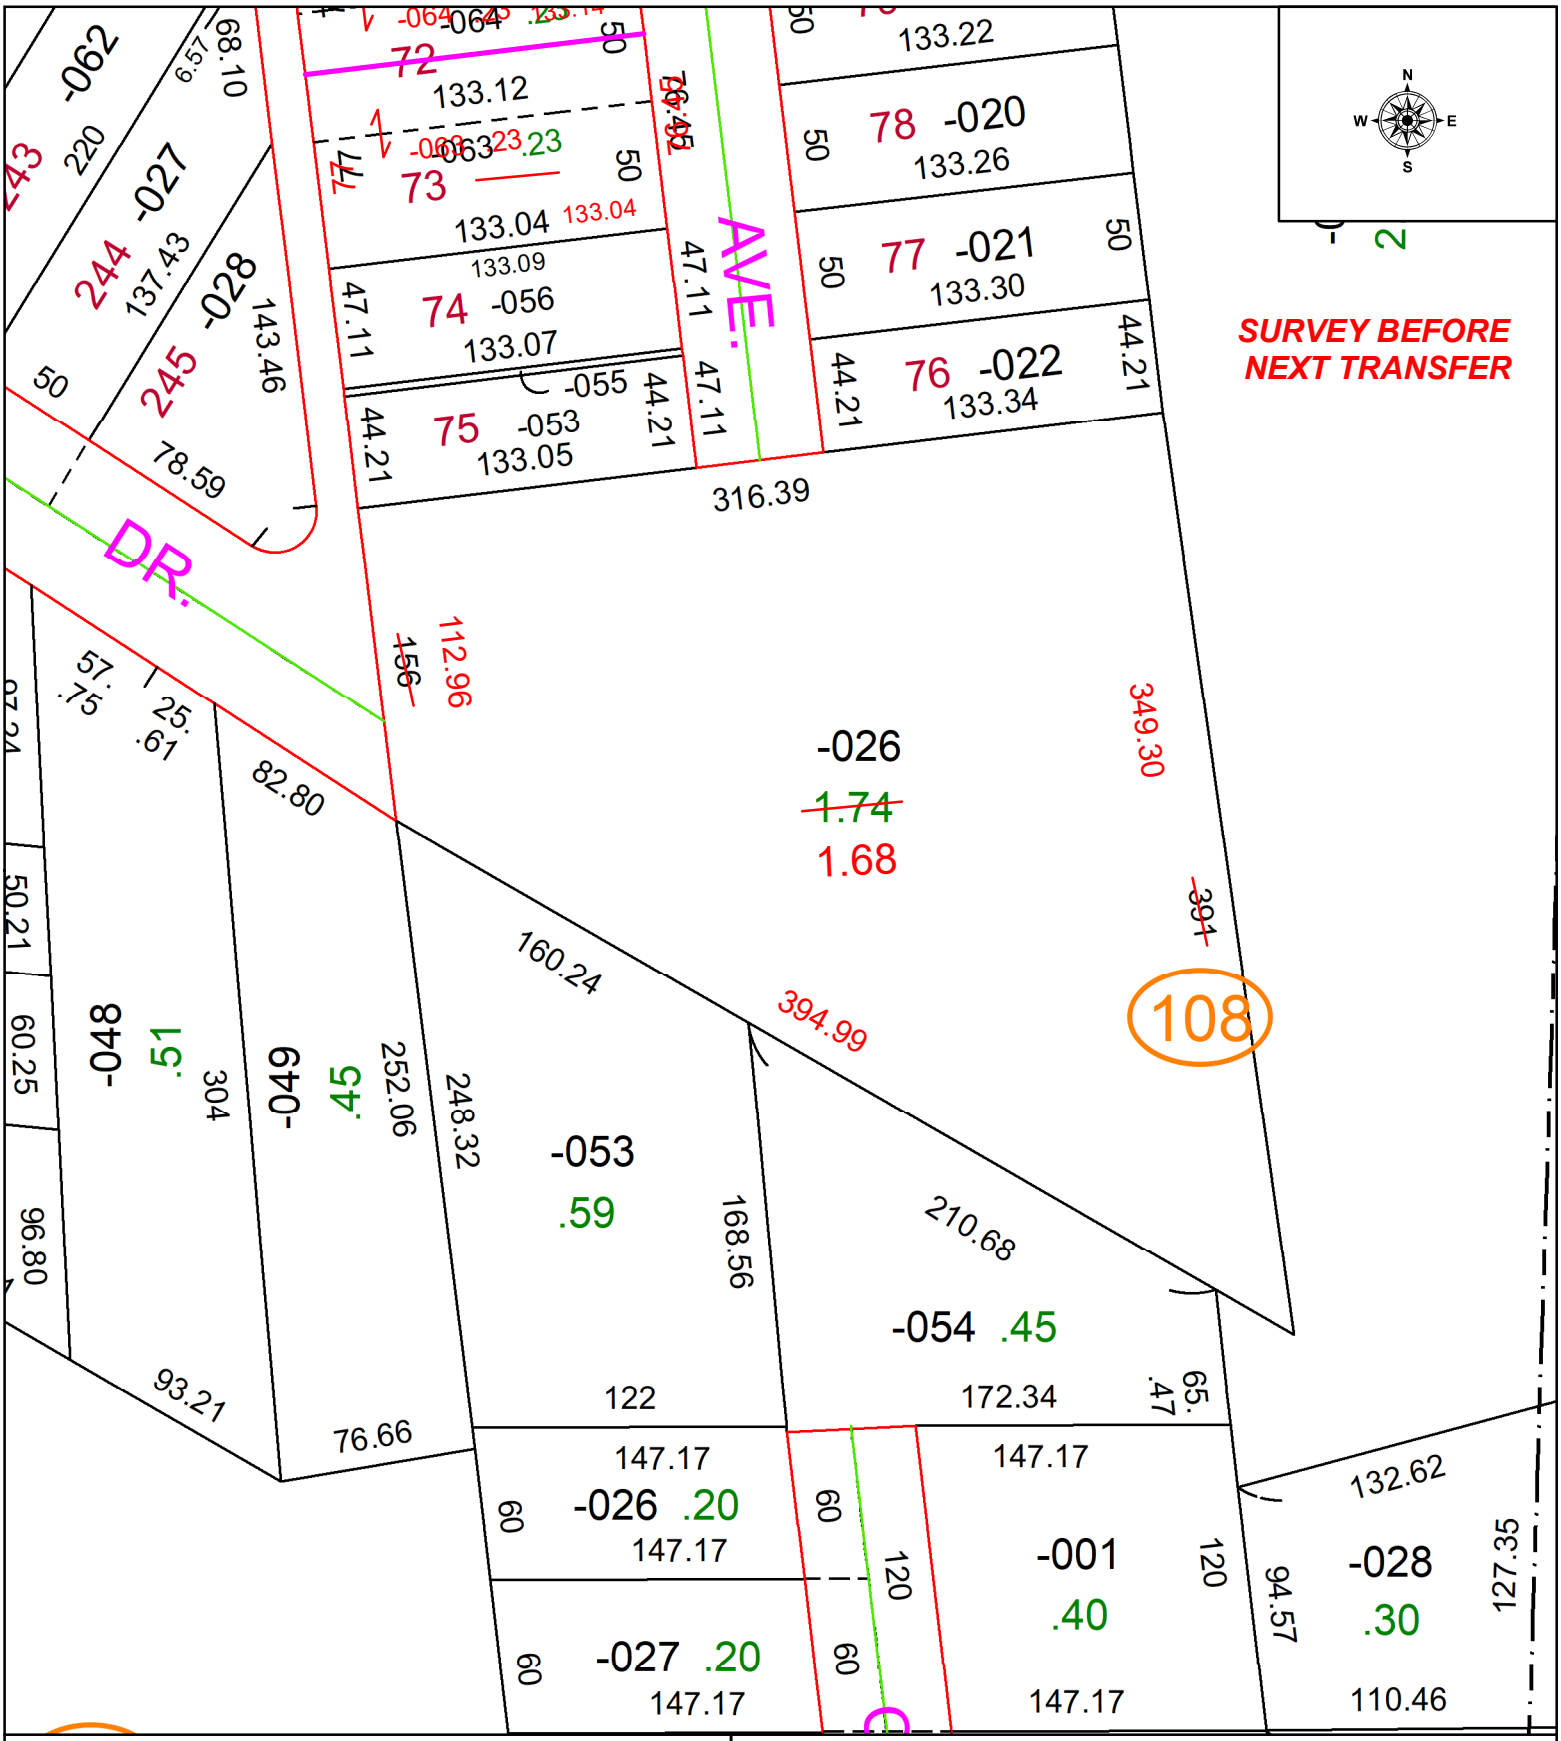

SPLITS/DEEDS PROCESSED

LORAIN COUNTY TAX MAP DEPARTMENT
226 MIDDLE AVE. ELYRIA, OH

SURVEYED BY: ROBERT RUFFING — SURVEY # 51647

CLOSURE: 1: 503361

MAP PAGE(S): 03-00-113

APPOVED BY: WRZ **DATE:** 1/30/2026

SCALE: 1" = 75 **PRIOR INSTRUMENT:** #2016-0608548