PARENT PARCEL: 02-02-022-101-017

CHILD PARCEL: 02-02-022-101-026 & -02-02-023-101-033

STARTING POINT: UNCOMBINATION PER SURV BY THOMAS A. SIMON

26-05663-C

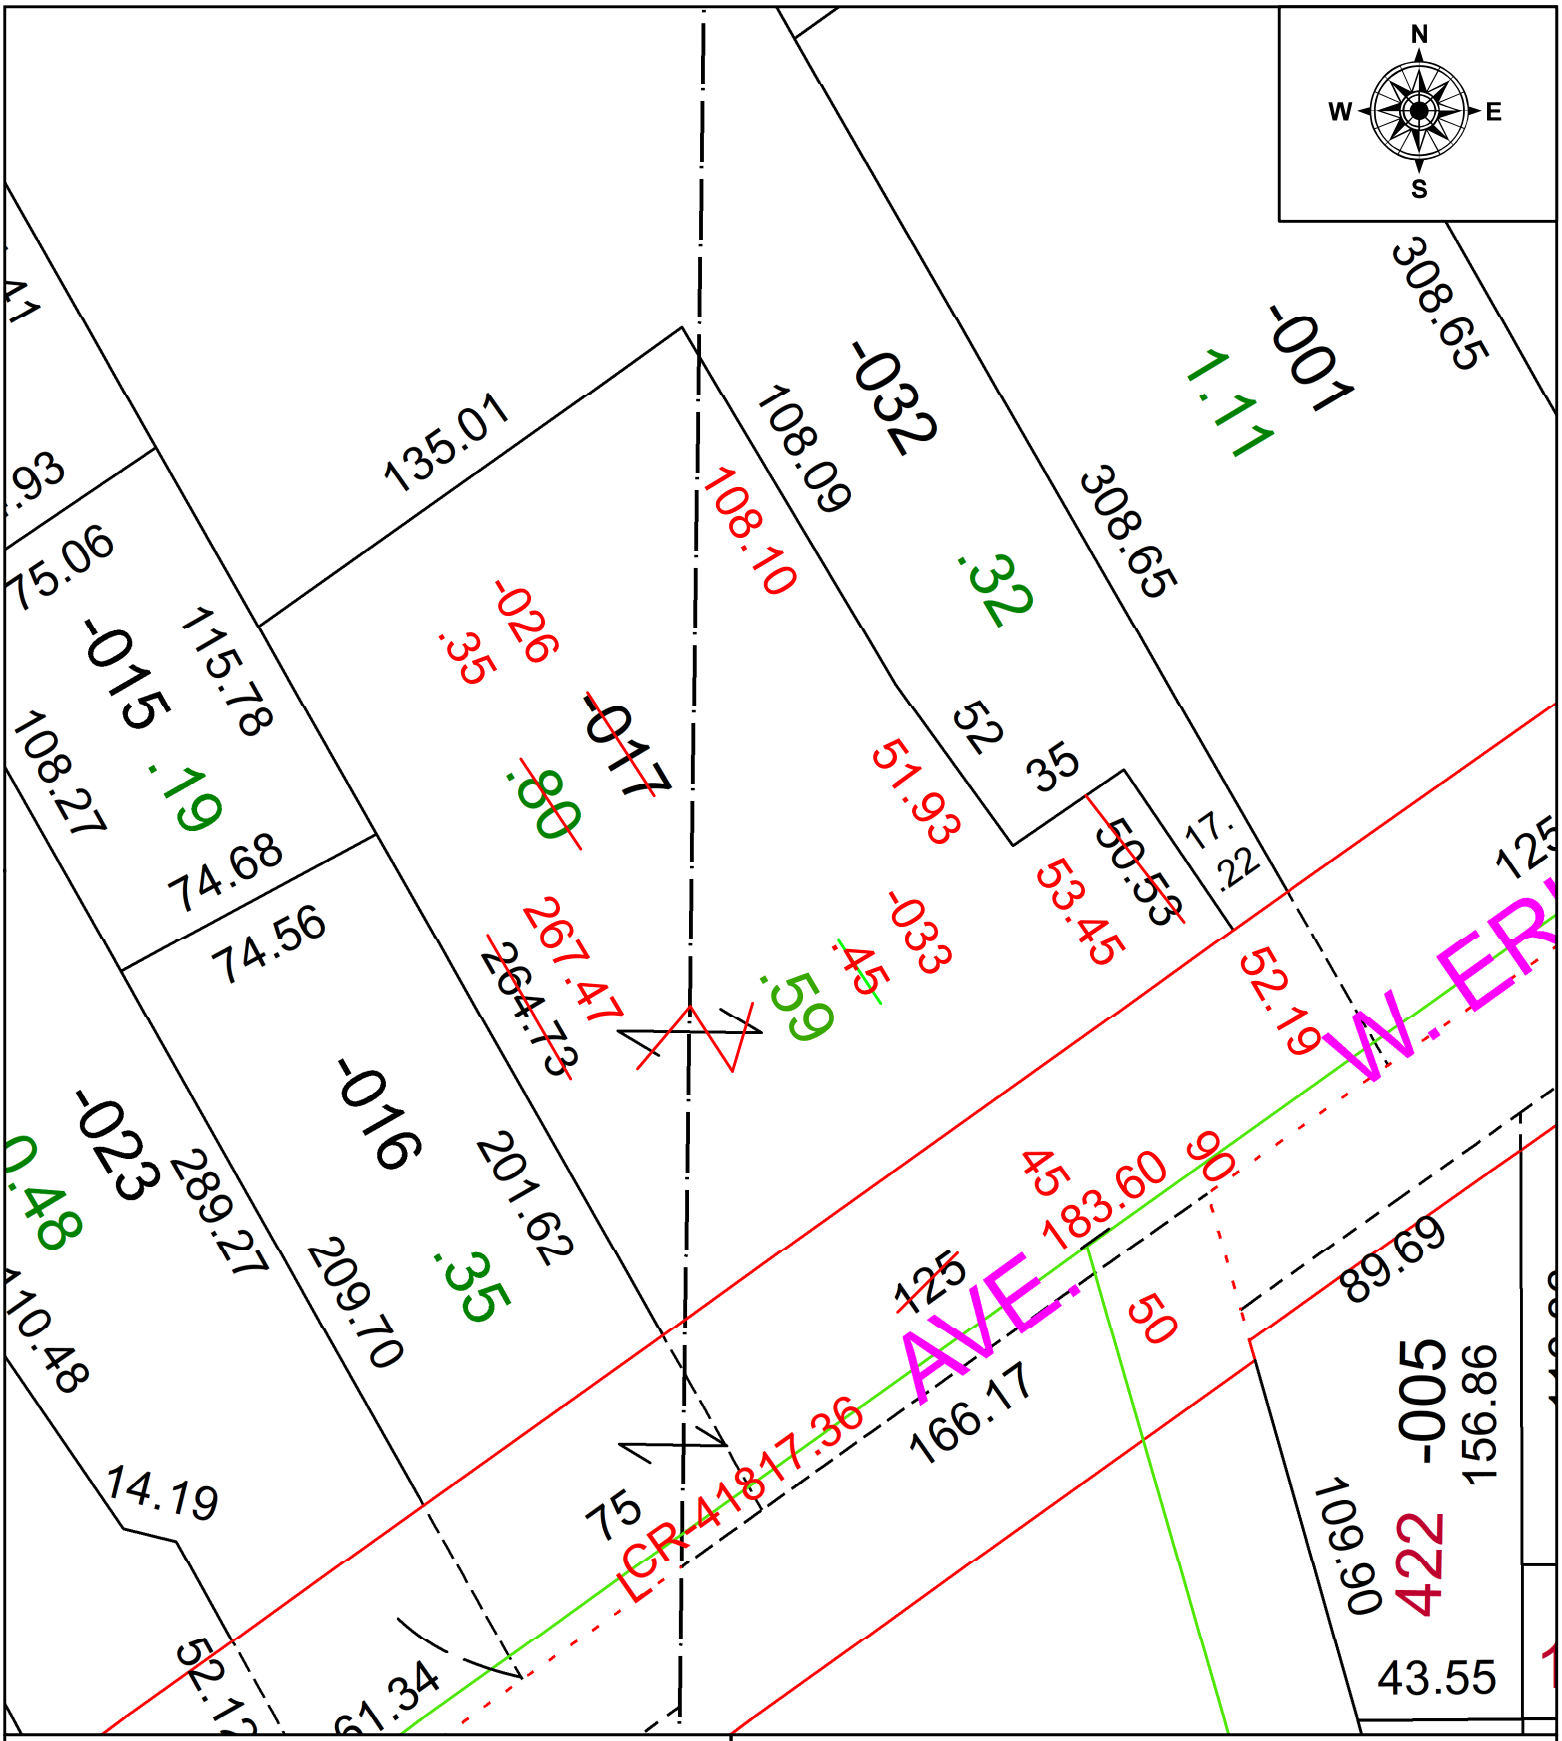

SPLITS/DEEDS PROCESSED

LORAIN COUNTY TAX MAP DEPARTMENT
226 MIDDLE AVE. ELYRIA, OH

SURVEYED BY: THOMAS A. SIMON **SURV # 51652**

CLOSURE: 1: 100000

MAP PAGE(S): 02-02-022

APPOVED BY: AC **DATE:** February 10, 2026

SCALE: 1 in = 50 ft **PRIOR INSTRUMENT:** 2022- 0870338