PARENT PARCEL: 04-00-016-101-202

CHILD PARCEL: AC CORR PER SURVEYOR MICHAEL P. SPELLACY

STARTING POINT: C/L IN CHESTER AND CENTER RD

26-05666-C

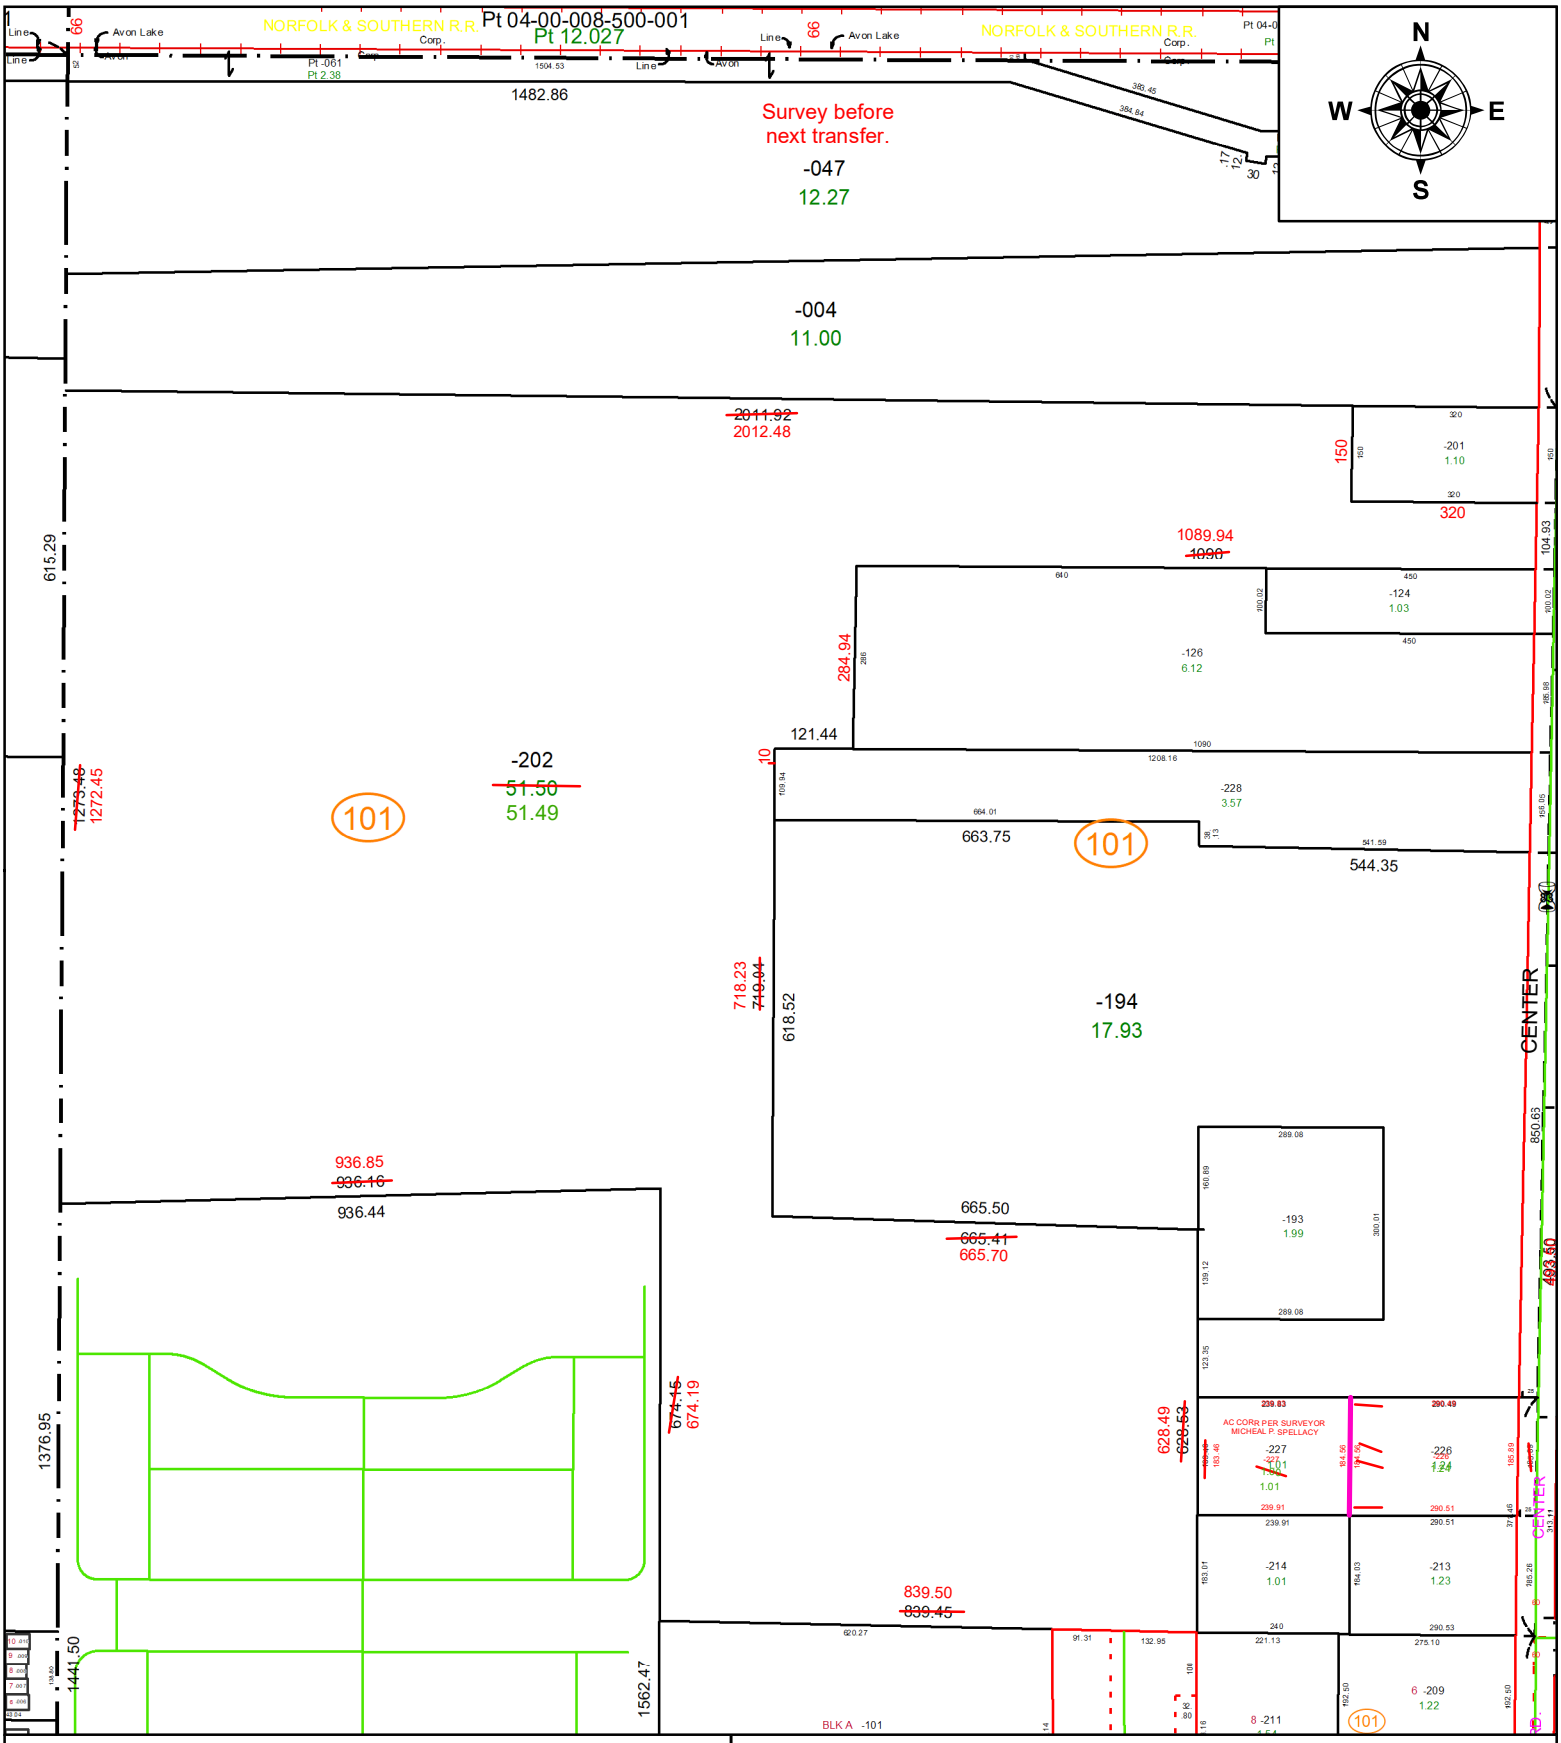

SPLITS/DEEDS PROCESSED

LORAIN COUNTY TAX MAP DEPARTMENT
226 MIDDLE AVE. ELYRIA, OH

SURVEYED BY: MICHAEL P SPELLACY **SURVEY #:** 51655

CLOSURE: 1: 2716402421

MAP PAGE(S): 04-00-016

APPOVED BY: BB **DATE:** 2/18/2026

SCALE: 1" = 300' **PRIOR INSTRUMENT:** #20190731596