PARENT PARCEL: 03-00-113-107-001
CHILD PARCEL: AC. CORR. PER INSTR. #2015-0570931
STARTING POINT: N/A

26-05668-A

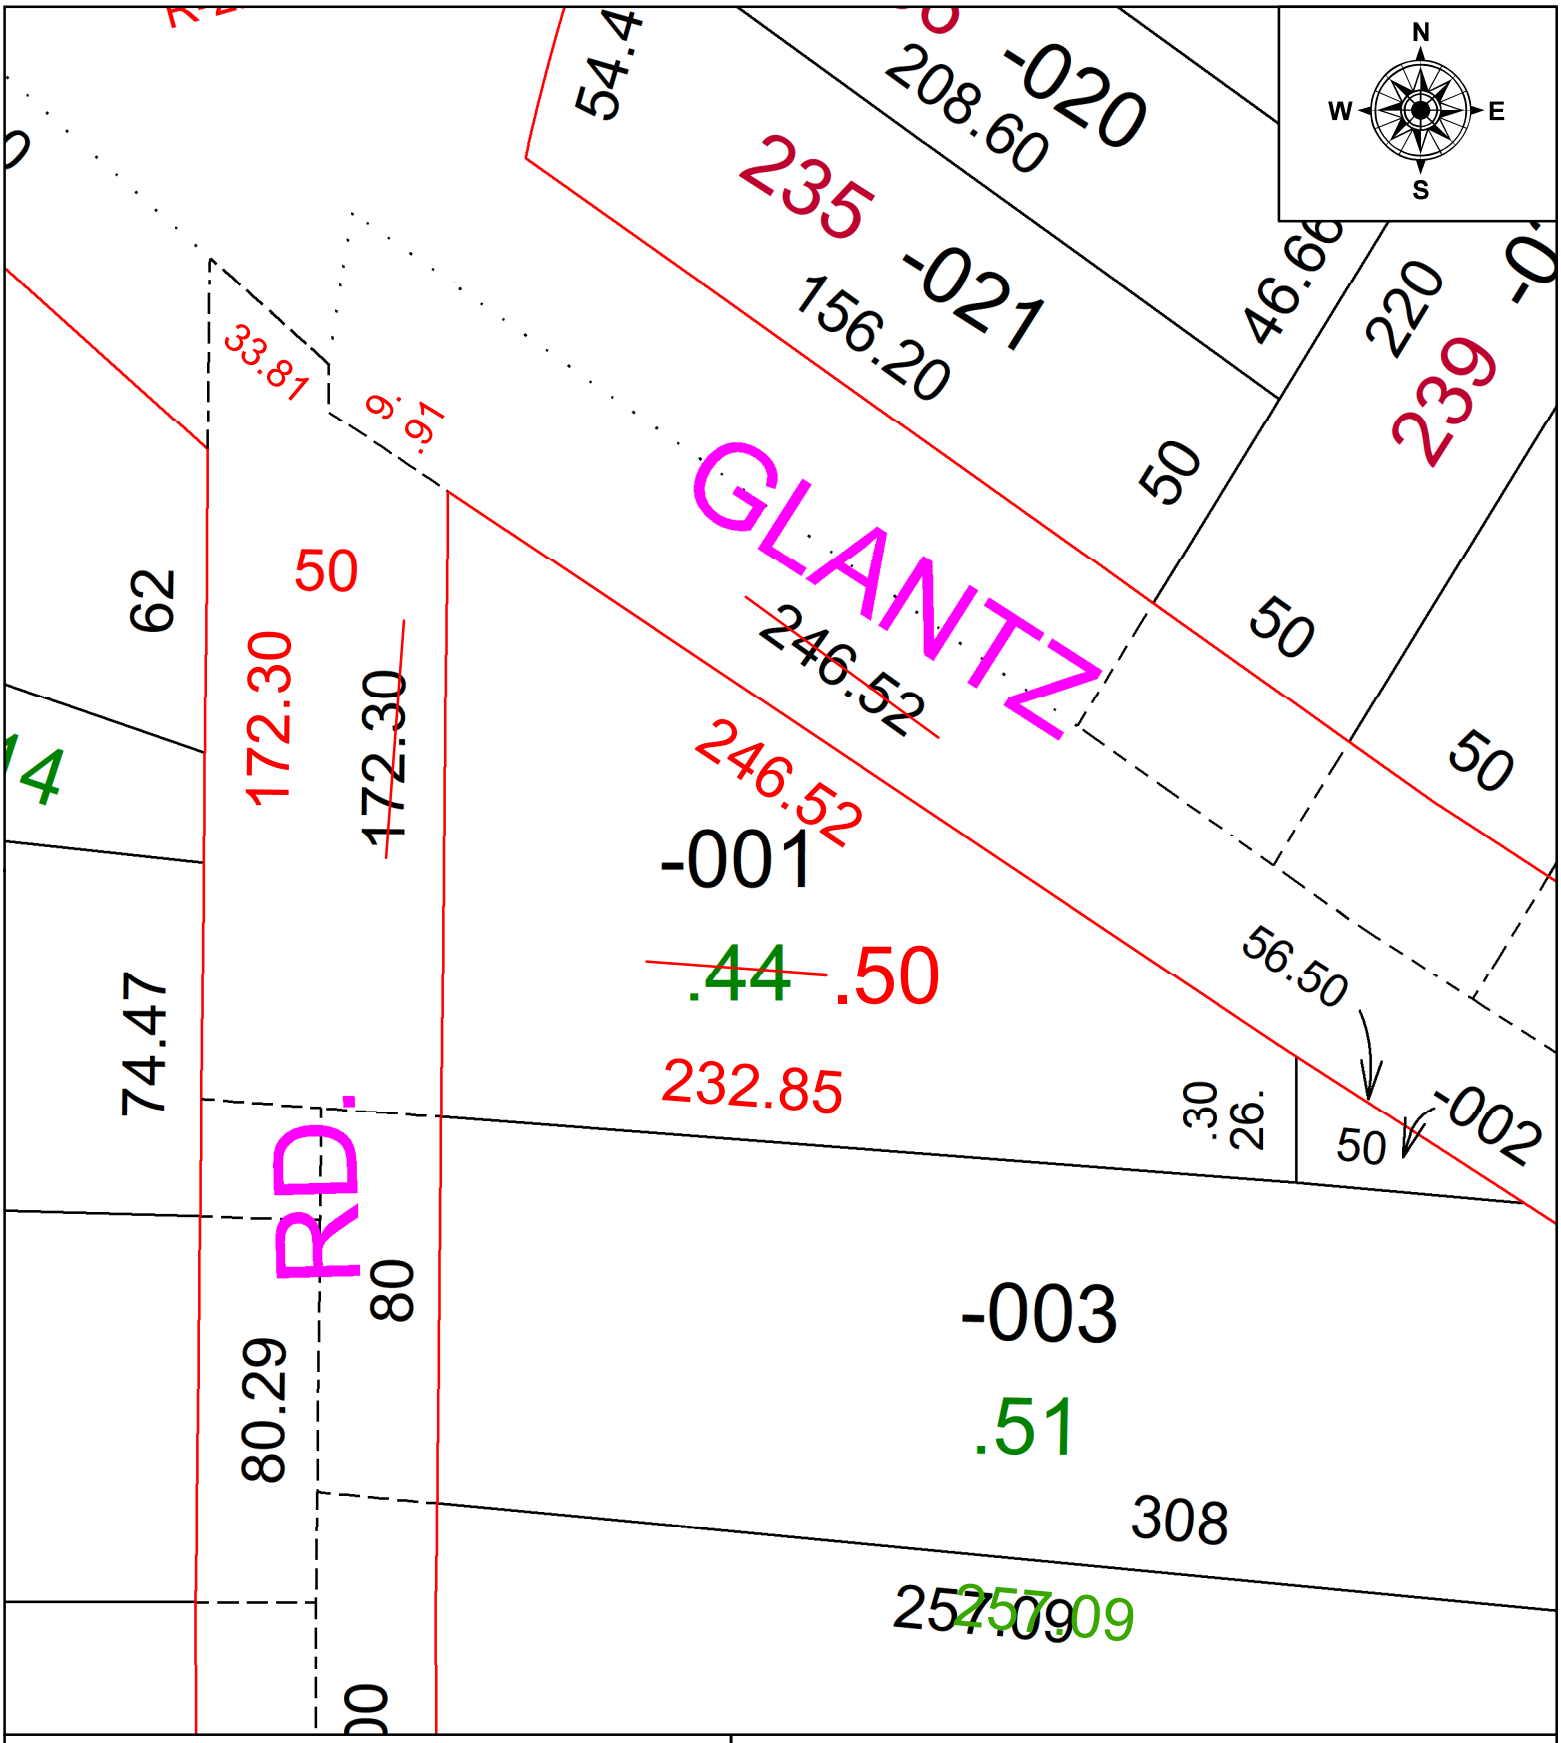

SPLITS/DEEDS PROCESSED
LORAIN COUNTY TAX MAP DEPARTMENT
226 MIDDLE AVE. ELYRIA, OH

SURVEYED BY: N/A **SURVEY #:** N/A
CLOSURE: N/A
MAP PAGE(S): 03-00-113
APPOVED BY: DMA **DATE:** 2/23/2026
SCALE: 1" = 600' **PRIOR INSTRUMENT:** 2015-0570931