PARENT PARCEL: 15-00-015-000-016

CHILD PARCEL: 15-00-015-000-021, -022

STARTING POINT: INT CL S.R. 301 AND N LINE OF O.L. 15

09-00194

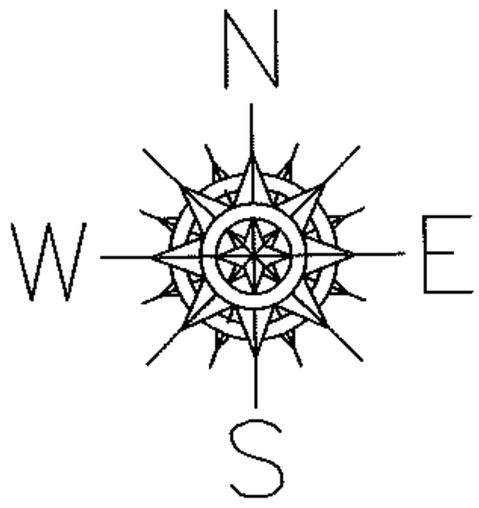

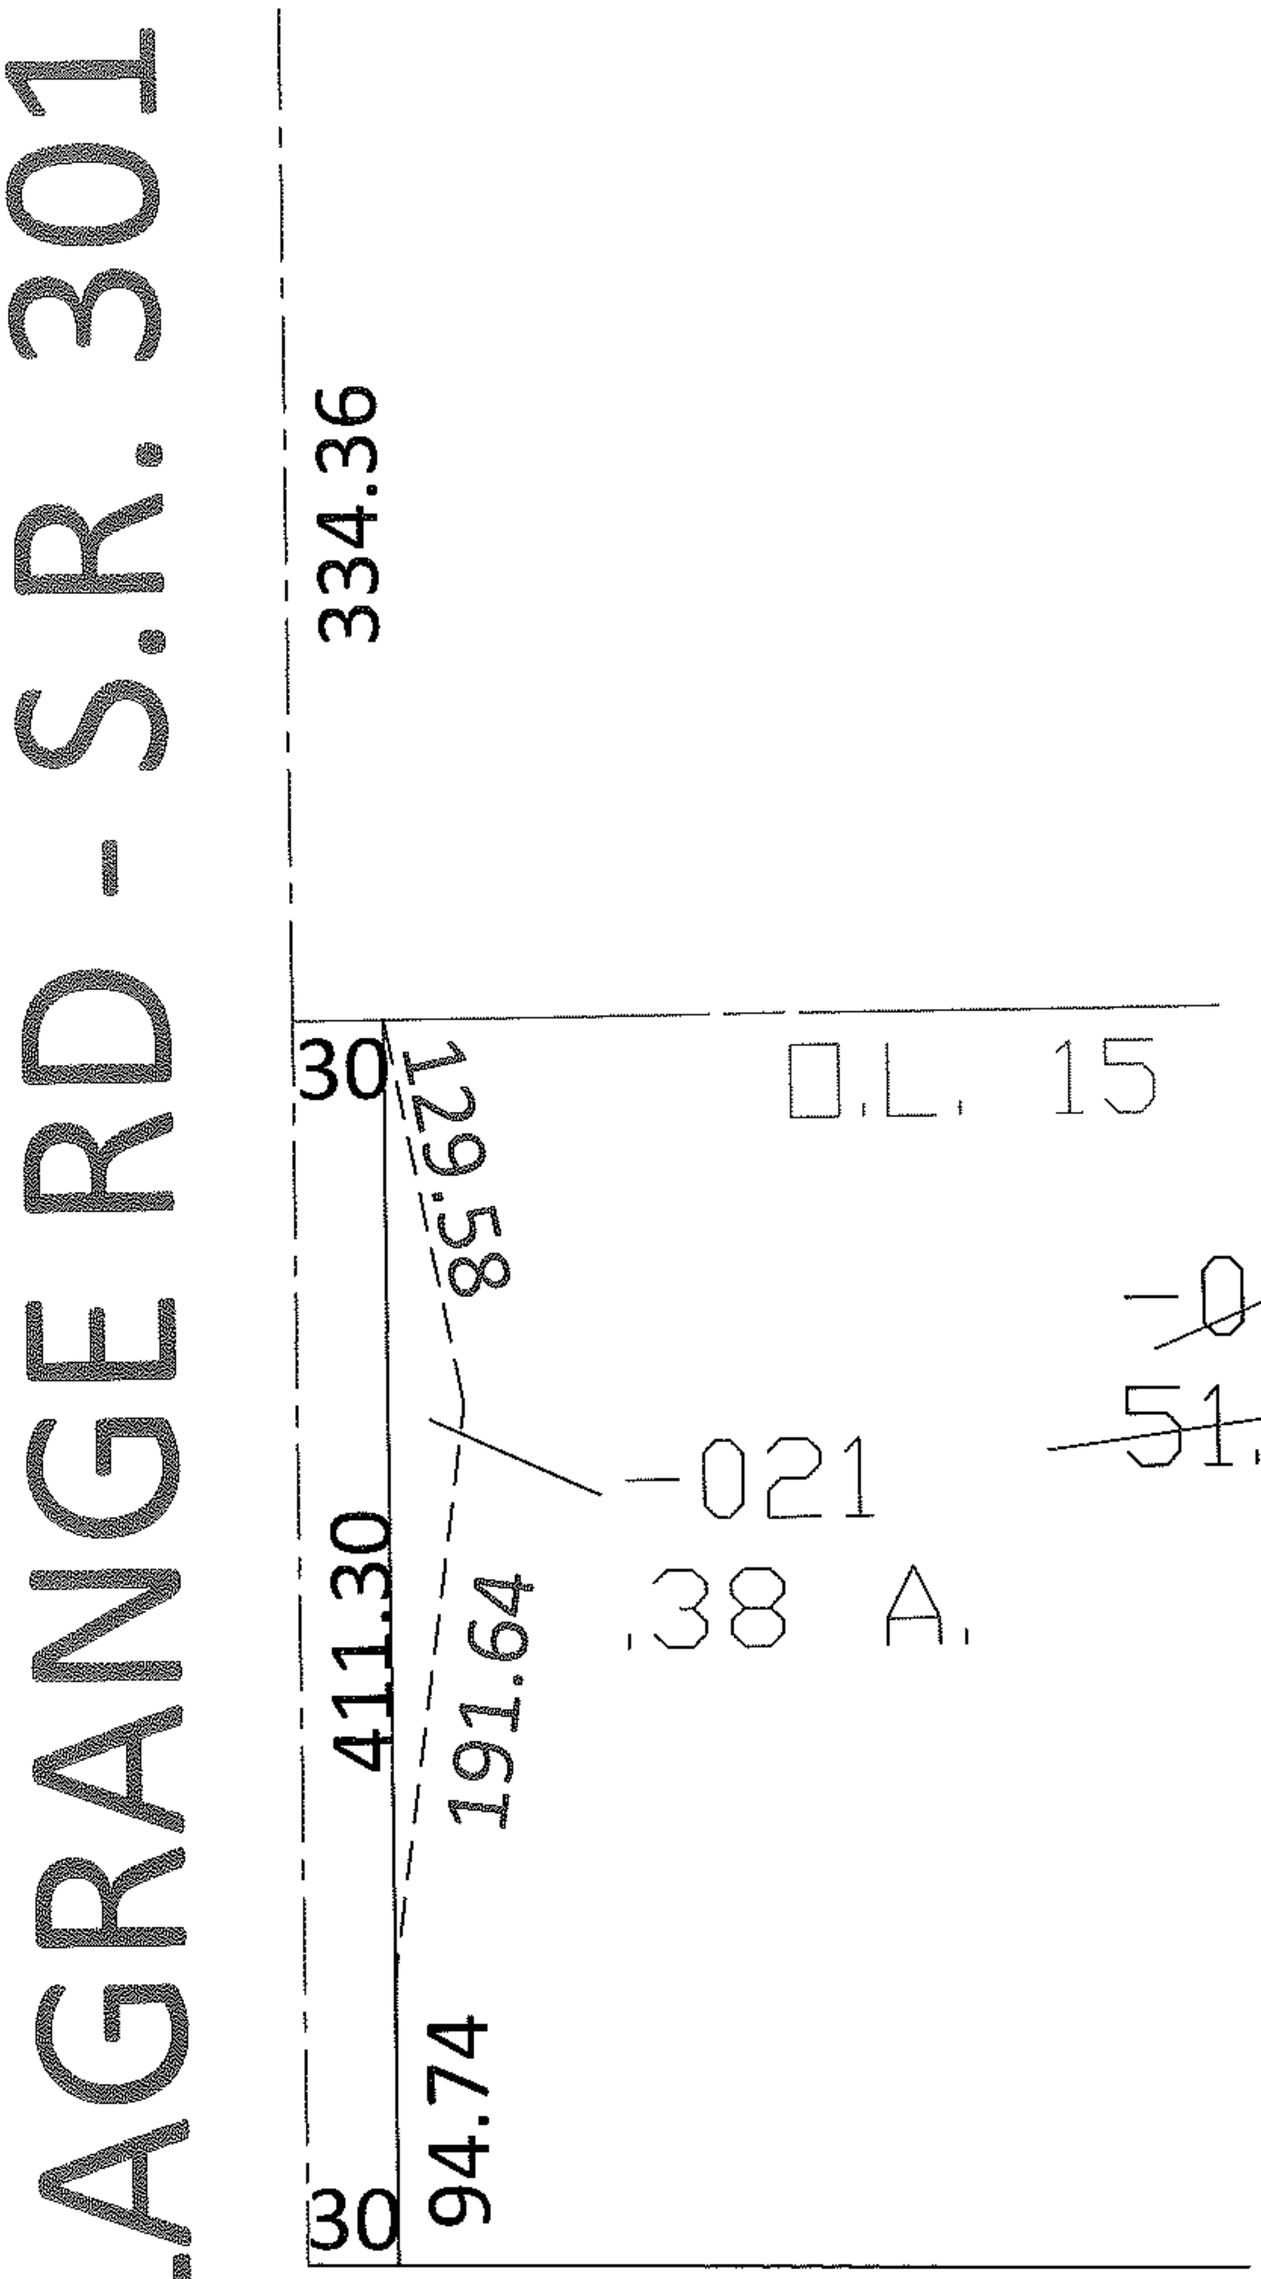

PAGE 2 OF 2

SPLITS/DEEDS PROCESSED

LORAIN COUNTY TAX MAP DEPARTMENT
226 MIDDLE AVE. ELYRIA, OHIO

SURVEYED BY: SHANE L. QUEER

CLOSURE: 1:10,000

MAP PAGE(S): 15-C

APPROVED BY: DRH DATE: 2/25/2009

SCALE: 1"= 100 PRIOR INST.: 19920201703