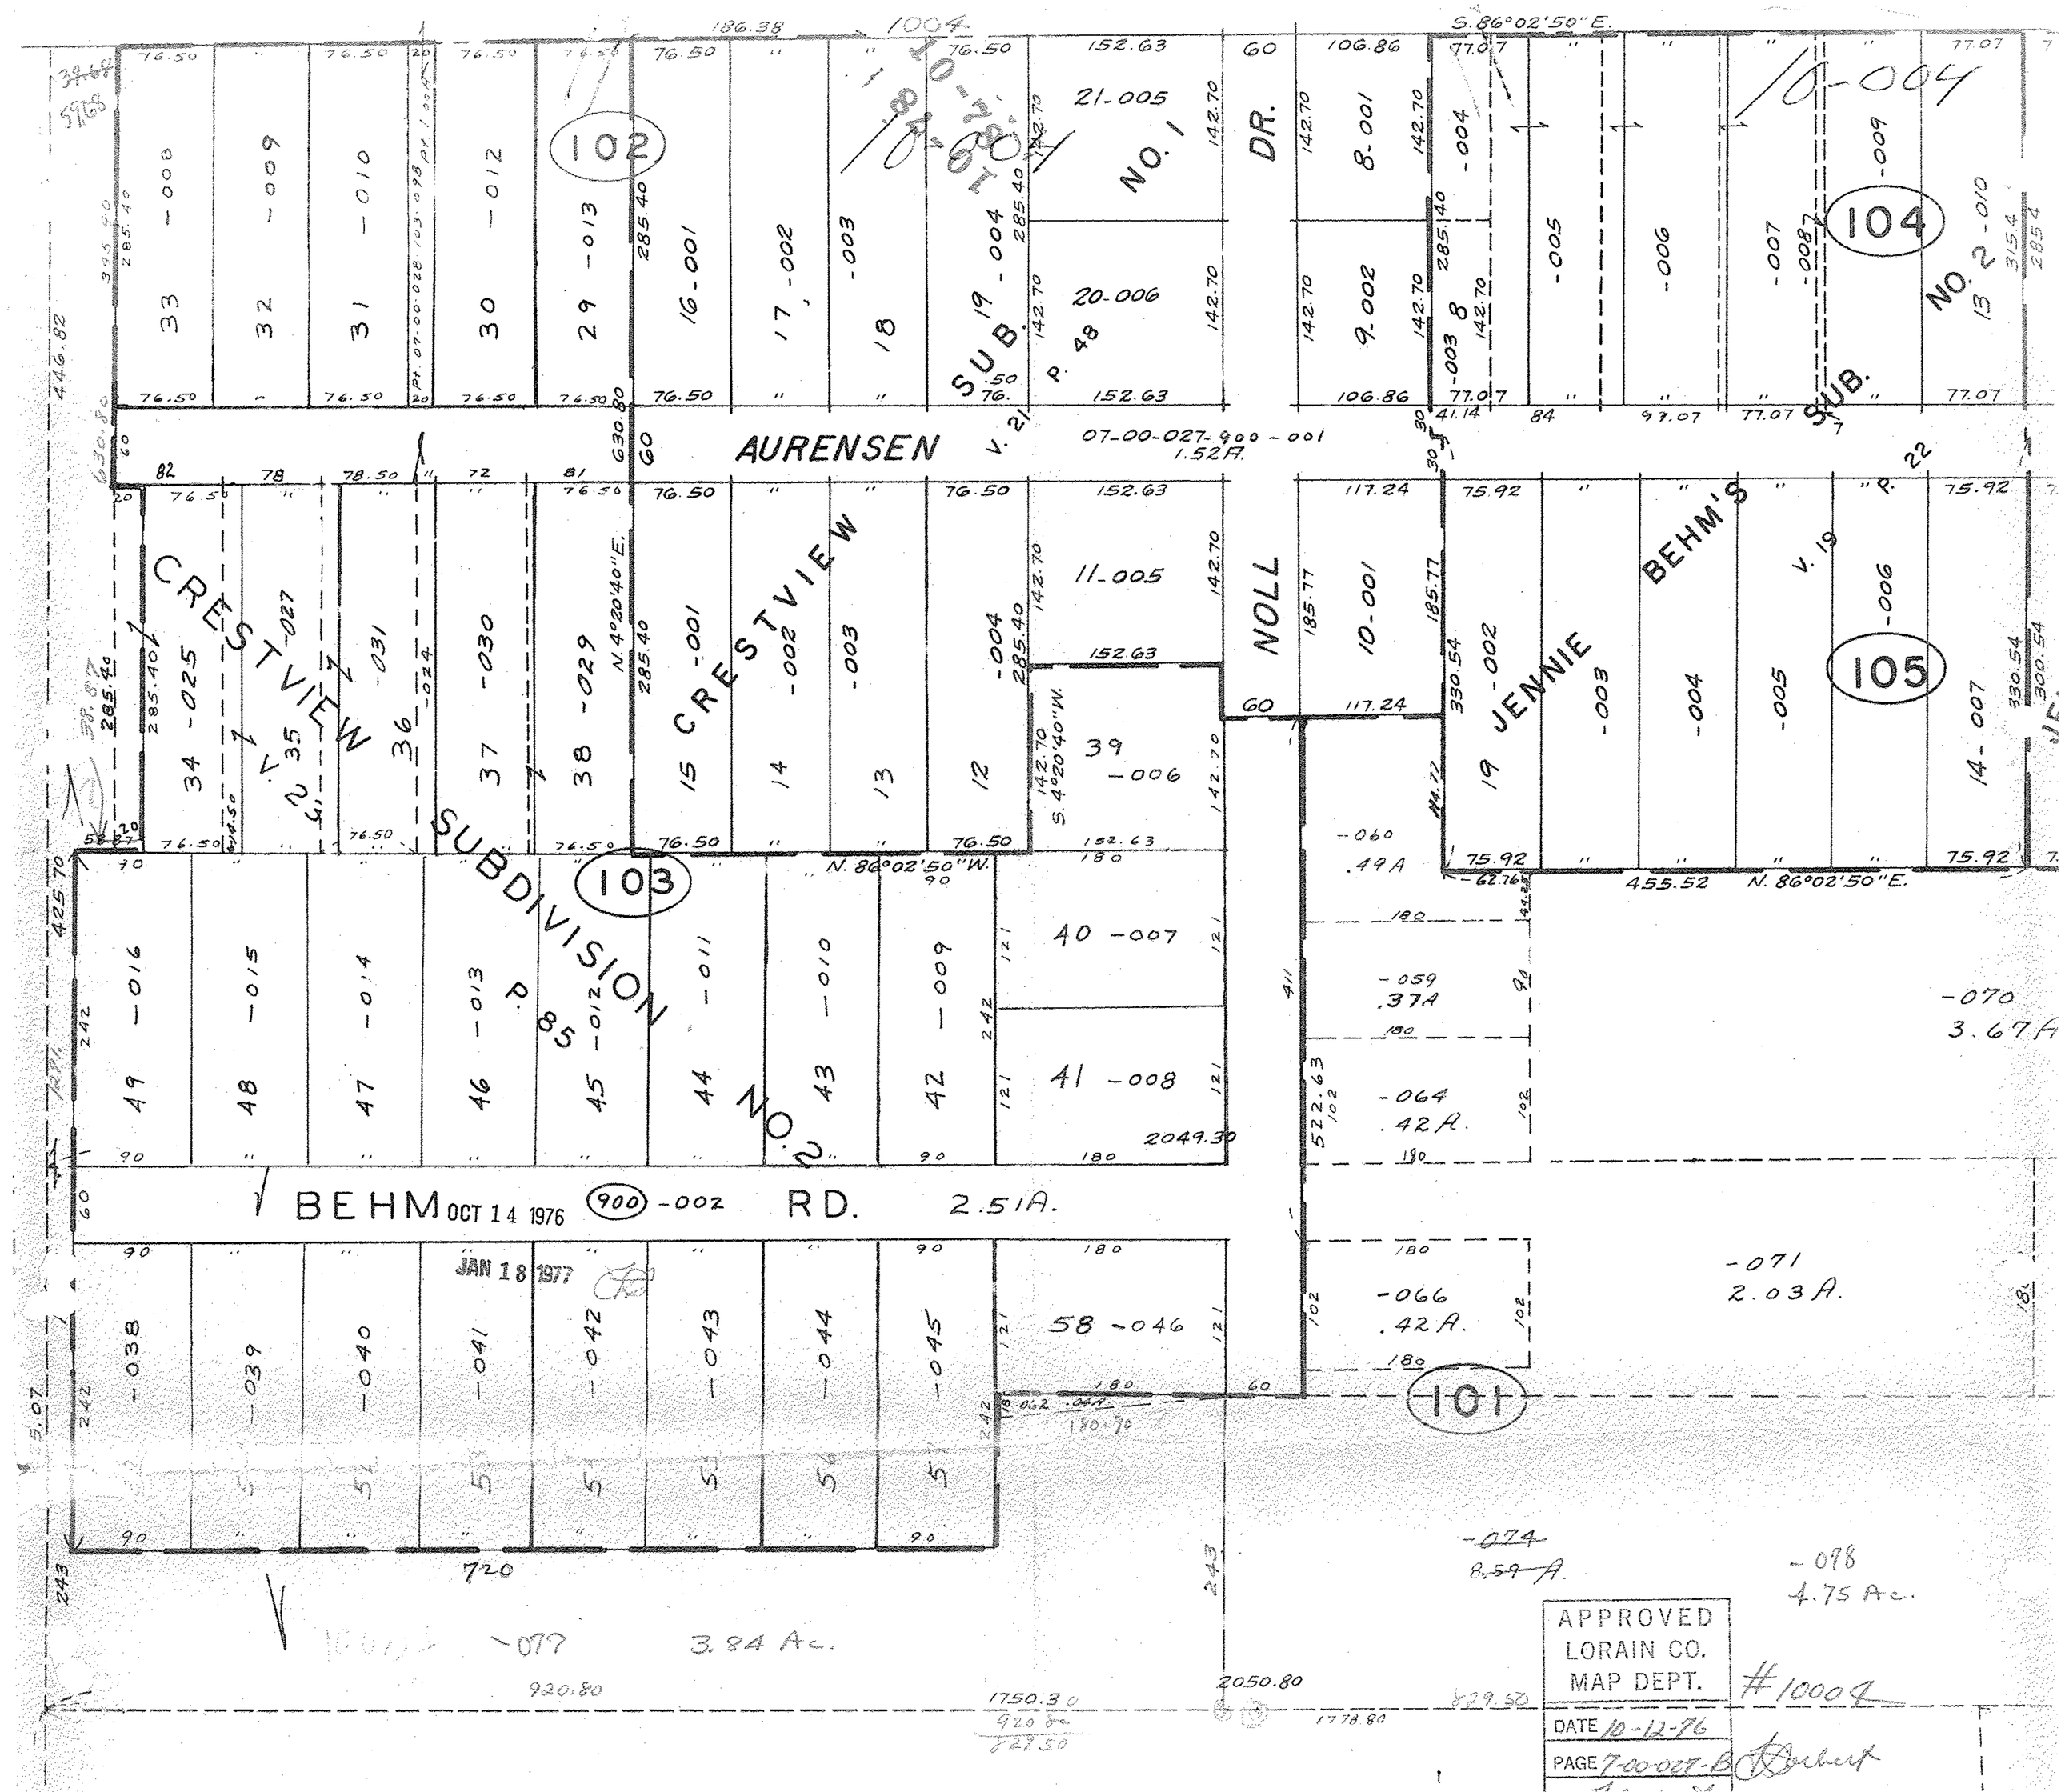

AURENSEN
CRESTVIEW SUBDIVISION NO. 2
CRESTVIEW SUB. NO. 1
NOLL DR.
JENNIE BEHM'S SUB. NO. 2
BEHM RD.
OCT 14 1976
JAN 18 1977
S. 86°02'50" E.
N. 86°02'50" W.
N. 86°02'50" E.
N. 4°20'40" E.
S. 4°20'40" W.
07-00-027-900-001
1.52A.
2.51A.
3.84 Ac.
4.75 Ac.
3.67A
2.03A.
APPROVED
LORAIN CO.
MAP DEPT.
#10004
DATE 10-12-76
PAGE 7-00-027-B