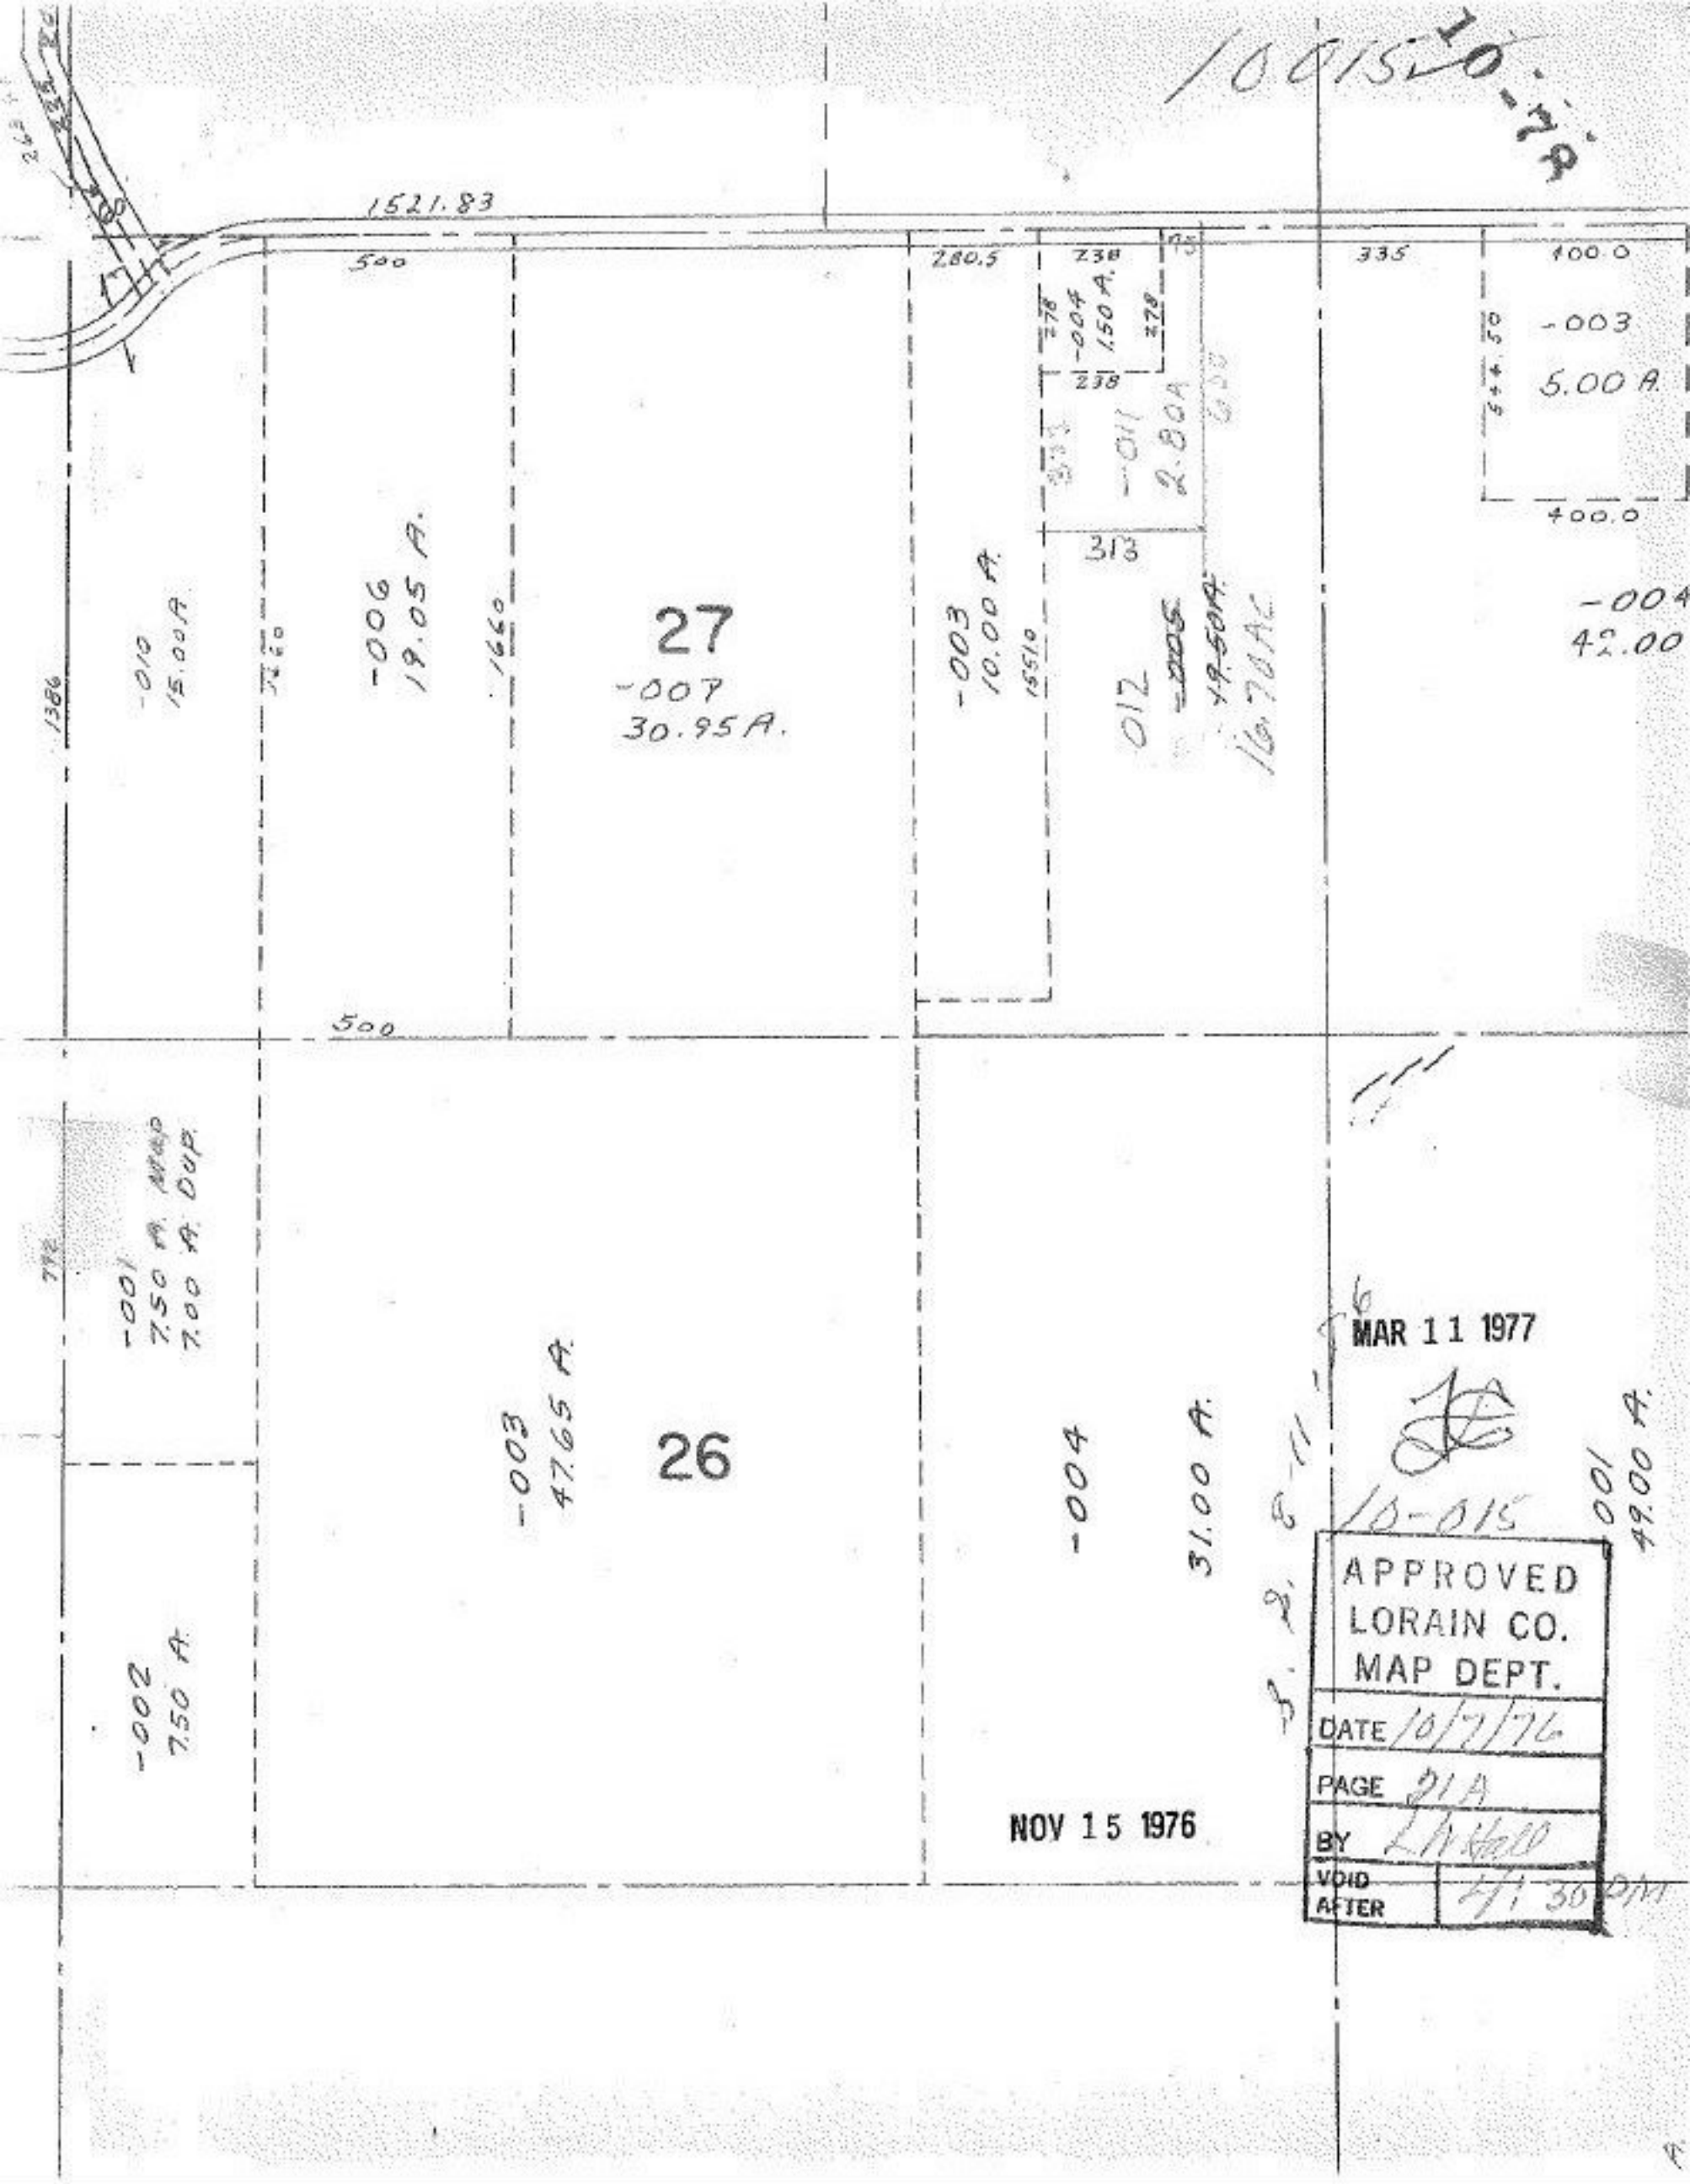
10015 10-7A
1521.83
500
280.5
238
335
400.0
-004
1.50 A.
-003
5.00 A.
-011
2.80A
313
-010
15.00A
-006
19.05 A.
1660
27
-007
30.95A.
-003
10.00 A.
1551.0
012
16.70AC
-004
42.00
1386
500
-001
7.50 A. Map
7.00 A. Dup.
-003
47.65 A.
26
-004
31.00 A.
-002
7.50 A.
-001
49.00 A.
MAR 11 1977
10-015
APPROVED
LORAIN CO.
MAP DEPT.
DATE 10/7/76
PAGE 21A
BY L.H. Hall
VOID AFTER 4:30 PM
NOV 15 1976