10-78

10018

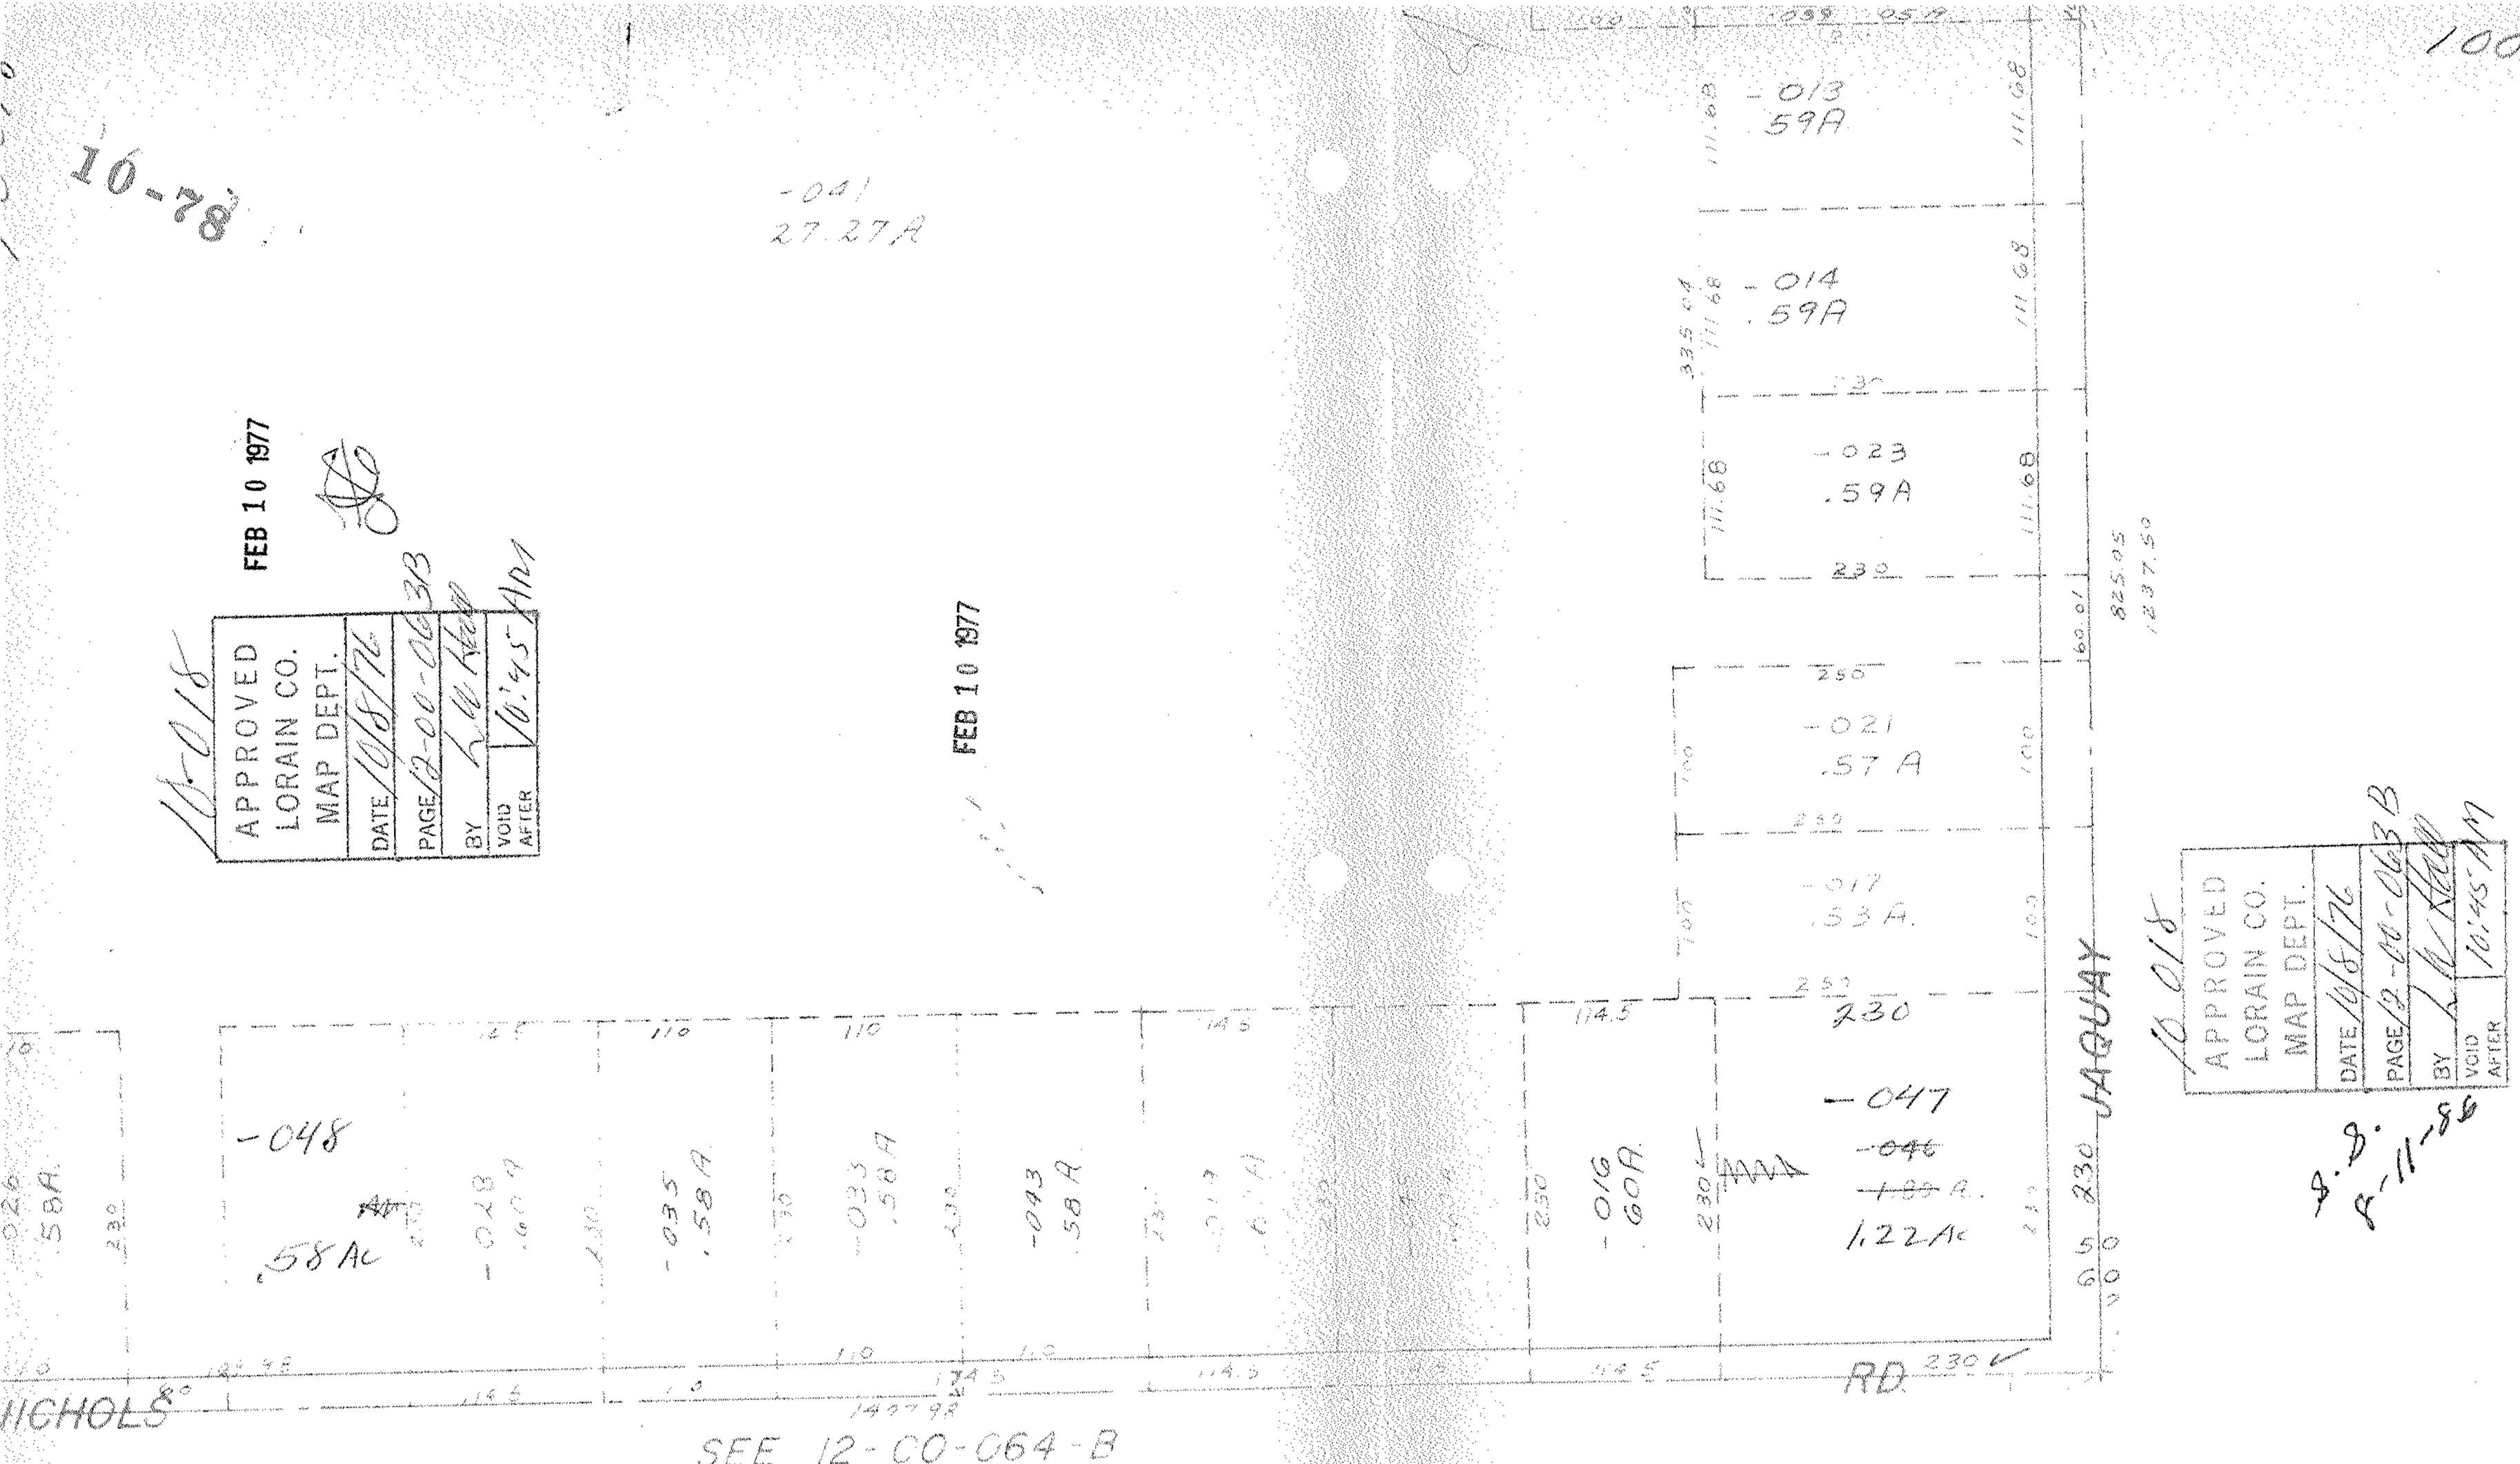

FEB 10 1977

APPROVED
LORAIN CO.
MAP DEPT.
DATE 10/8/76
PAGE 12-00-063B
BY L.W. Kaap
VOID AFTER 10:45 AM

10-018

APPROVED
LORAIN CO.
MAP DEPT.
DATE 10/8/76
PAGE 12-00-063B
BY L.W. Kaap
VOID AFTER 10:45 AM

8.8.
8-11-86

OCT 21 19

Copyright

UMBIA TWP.

ELY PT LOT 63

12-00-063