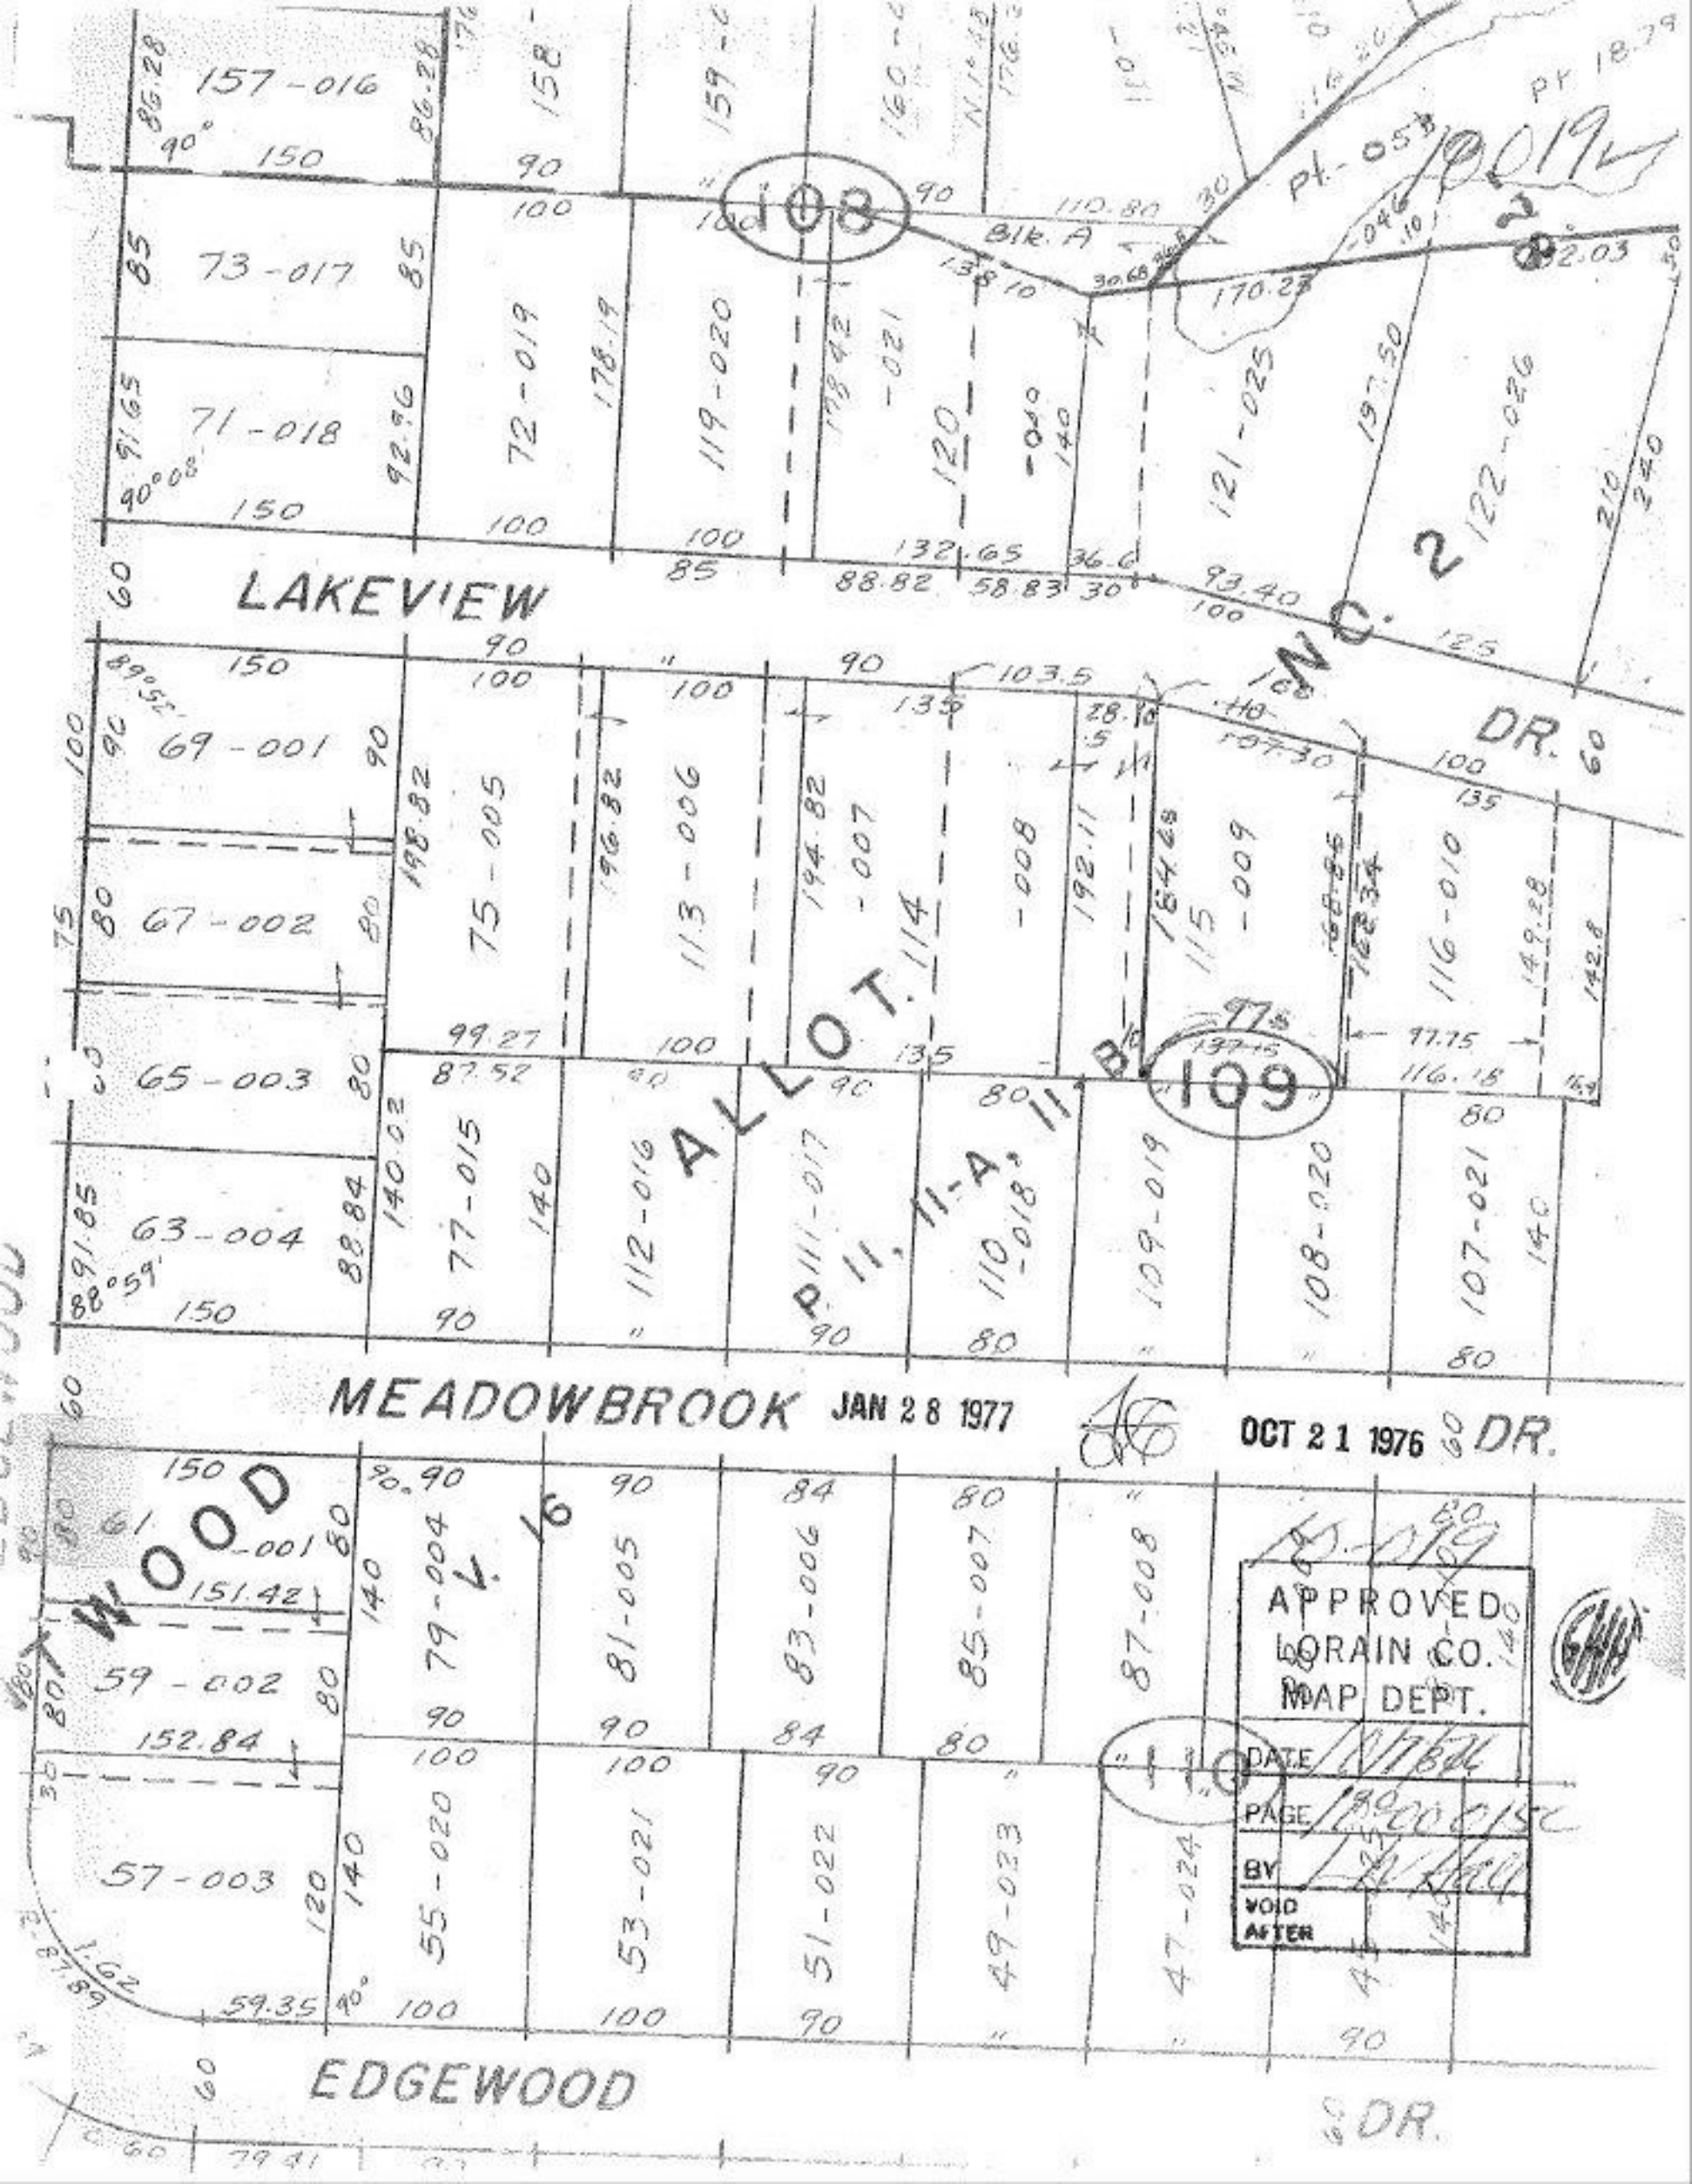

JAN 28 1977

OCT 21 1976

APPROVED
LORAIN CO.
MAP DEPT.
DATE
PAGE
BY
VOID
AFTER